IREDELL COUNTY HEALTH DEPARTMENT

STATESVILLE 704-878-5305 MOORESVILLE 704-664-5281

IMPROVEMENT PERMIT / AUTHORIZATION TO CONSTRUCT / OPERATION PERMIT / EXISTING SYSTEM INSPECTION

(1)

PERMIT# 11,323 PIN# 4749-93-3925 DATE 6-5-03

OWNER OR CONTRACTOR PIEDMONT FARM SYSTEMS, INC PHONE: Business Home 704-873-0259

ADDRESS 1020 TOMLIN MILL ROAD, STATESVILLE NC 28677

LOCATION I-77 NORTH, TL TOMLIN MILL ROAD, TRACT ON RIGHT JUST PAST LENTZ ROAD,

SUBDIVISION BLOCK / SECTION LOT LOT AREA 5.898 ACRES SITE CLASS PS DESIGN FLOW 300 L.T.A.R. 0.25 GPD/FT2

Septic Tank: 1000 Gallons; STB 1007 Date 5-21-03

Pump Tank: Gallons; PT Date

Pump Make: Model Serial No.

Nitrification Field: No Fields 1 Square Feet 1200 Linear Feet 400

No Lines FIVE Trench Width 36" Max Trench Bottom Depth 36" Gravel Depth 12"

☑ New System ☐ Repair System Type: I, (II), III, IV, V, VI

System Description: CONVENTIONAL, GRAVITY

Repair System Description: CONVENTIONAL, GRAVITY

Maintenance Agreement Required: ☐ Yes ☑ No

☐ House/Mod. Home ☐ Mobile Home ☑ Business ☐ Other

No. Bedrooms No. Bathrooms No. Employees 12


☑ Slab ☐ Crawl Space ☐ Basement w/plumbing ☐ Basement wo/plumbing

Water Supply: ☐ Individual ☑ Public ☐ Community


Comments/Conditions: GRADE DESIGNATED DRAINFIELD AREA TO REMOVE FILL DIRT & TO PROVIDE UNIFORM SLOPE, CONTACT HEALTH DEPARTMENT AFTER GRADING & PRIOR TO INSTALLATION TO FLAG OUT SYSTEM

Comments/Conditions: (1) SYSTEM ALTERED AS SHOWN DUE TO INADEQUATE STONE DEPTH (10") IN ORIGINAL FIVE LINES (2) SEPTIC TANK WITH MARKER INSTALLED USING "POLYLOK" FILTER

INITIAL SITE SKETCH

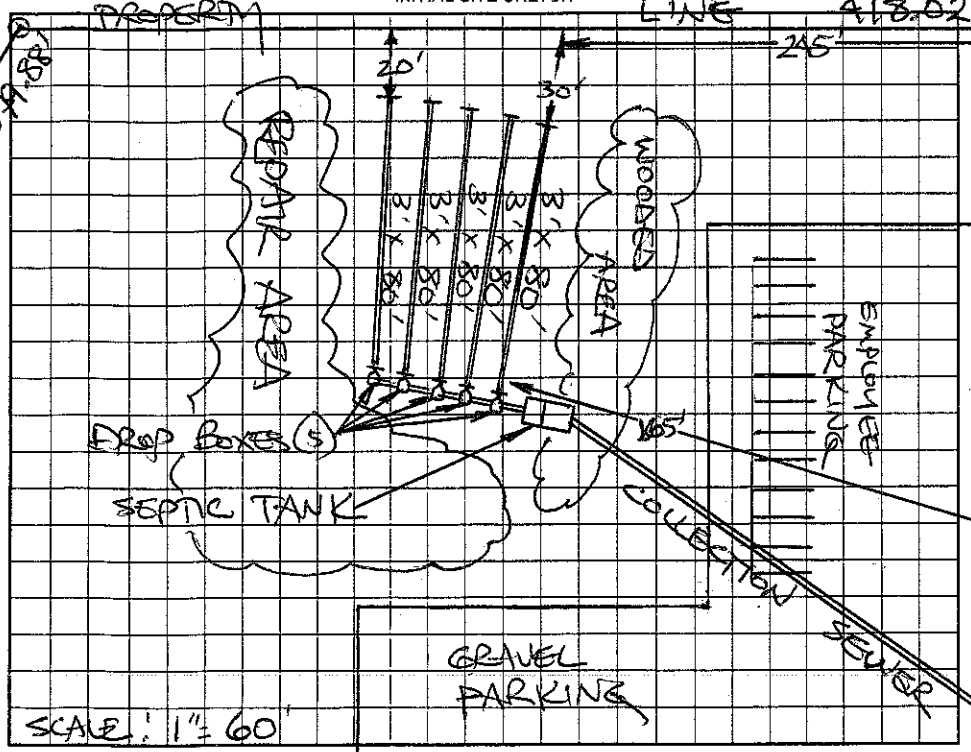

AS BUILT SKETCH

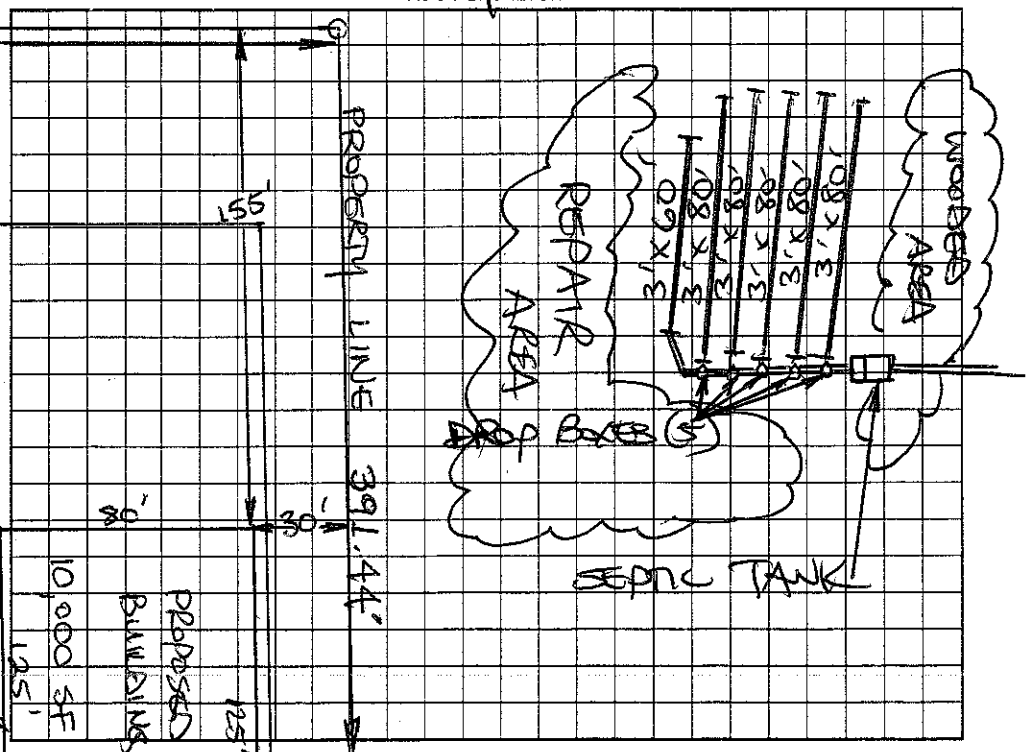

Permit can be suspended or revoked if any false information is supplied toward securing the permit/any unauthorized changes are made to the site/any unauthorized changes are made in the installation of the system. Improvement Permit with plat valid without expiration/Improvement Permit with site plan valid for sixty months. Authorization to Construct is valid for a period equal to that of Improvement Permit - not to exceed sixty months.

Signed: [signature] date 6-5-03

Improvement Permit by: STEVE HEDRICK date 6-5-03

Authorization to Construct by: STEVE HEDRICK date 6-5-03

Installed by: JAMES HUALER

Operation Permit by: STEVE HEDRICK date 7-16-03

Existing System Inspection by: date

HEALTH DEPT. COPY: WHITE OWNER COPY (FINAL): YELLOW OWNER COPY (INITIAL): PINK