IREDELL COUNTY HEALTH DEPARTMENT

Authorization to construct 3:30-4:00

STATESVILLE 704-878-5305 MOORESVILLE 704-664-5281

IMPROVEMENT PERMIT / ~~CERTIFICATE OF COMPLETION~~ / OPERATION PERMIT / EXISTING SYSTEM INSPECTION

PROPERTY DESCRIPTION NO. 067358 DATE 7/24/97 TAX MAP NO. 4750036051 Watershed: ☑ Yes ☐ No

OWNER OR CONTRACTOR CLAUDE BAILEY PHONE: Business _____ Home 871-0955

ADDRESS 235 BREVARD ST STATESVILLE NC 28677

LOCATION 21 N-TR MCALLISTER - TR SIDE RD - GO BY CHURCH ON LEFT - PROPERTY ON LEFT 160 Miss Kitty Ln.

SUBDIVISION — BLOCK / SECTION — LOT — LOT AREA .50 AC SITE CLASS. BS DESIGN FLOW 360 L.T.A.R. .25

Septic Tank: 1000 Gallons; STB 821 Date 7/8/97
Pump Tank: 1000 Gallons; PT ~~PO~~ Date 8/6/97
Pump Make: _____ Model _____ Serial No. _____
Nitrification Field: No Fields 1 Square Feet 1080 Linear Feet 360
No Lines 6 @ 60' Trench Width 36" Max Trench Bottom Depth 24" Gravel Depth N/A

☑ New System ☐ Repair System Type: I, II, III, IV, V, VI
System Description: PUMP CHAMBERED
Repair System Description: DEEDED IN 1942
Maintenance Agreement Required: ☐ Yes ☑ No


☐ House/Mod. Home No. Bedrooms 3
☑ Mobile Home No. Bathrooms 2
☐ Business No. Employees _____
☐ Other _____
☐ Slab ☑ Crawl Space ☐ Basement w/plumbing ☐ Basement wo/plumbing

Water Supply: ☑ Individual ☐ Community ☐ Public


Comments:

Comments: HOUSE NOT LOCATED OR WELL AT TIME OF INSPECTION - CBP.
WELL NOT ABANDONED 8/6/97 CBP

INITIAL SITE SKETCH 1" = 40'

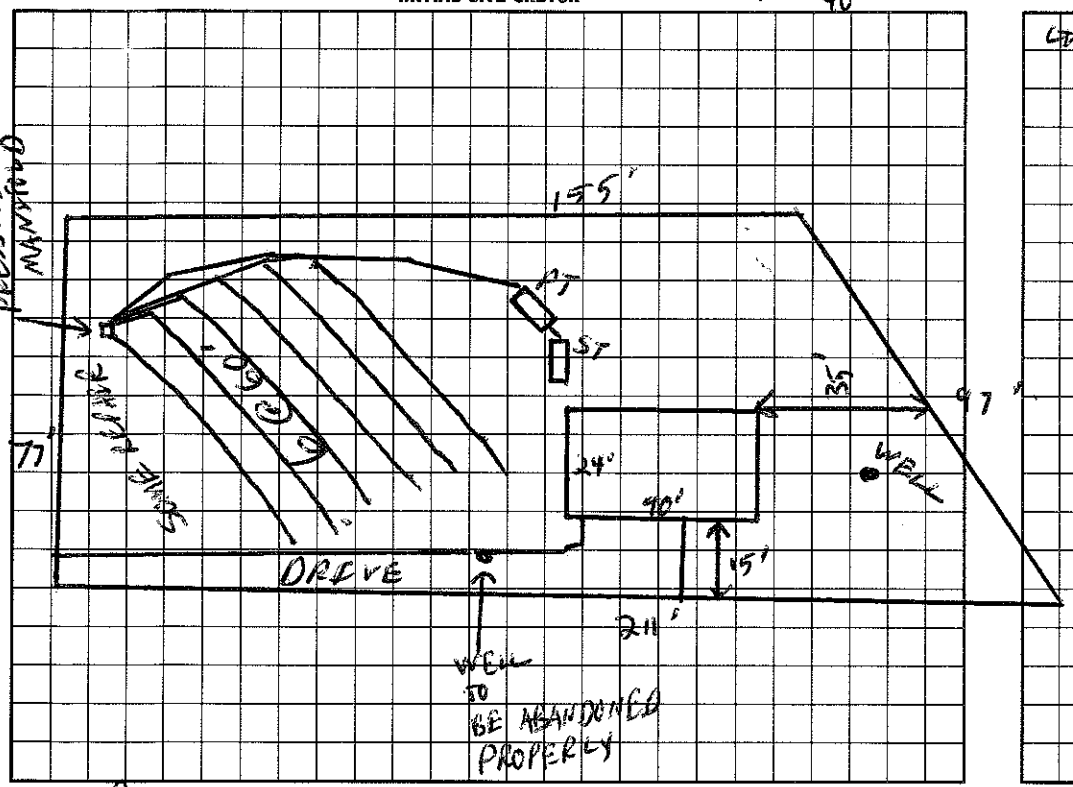

AS BUILT SKETCH

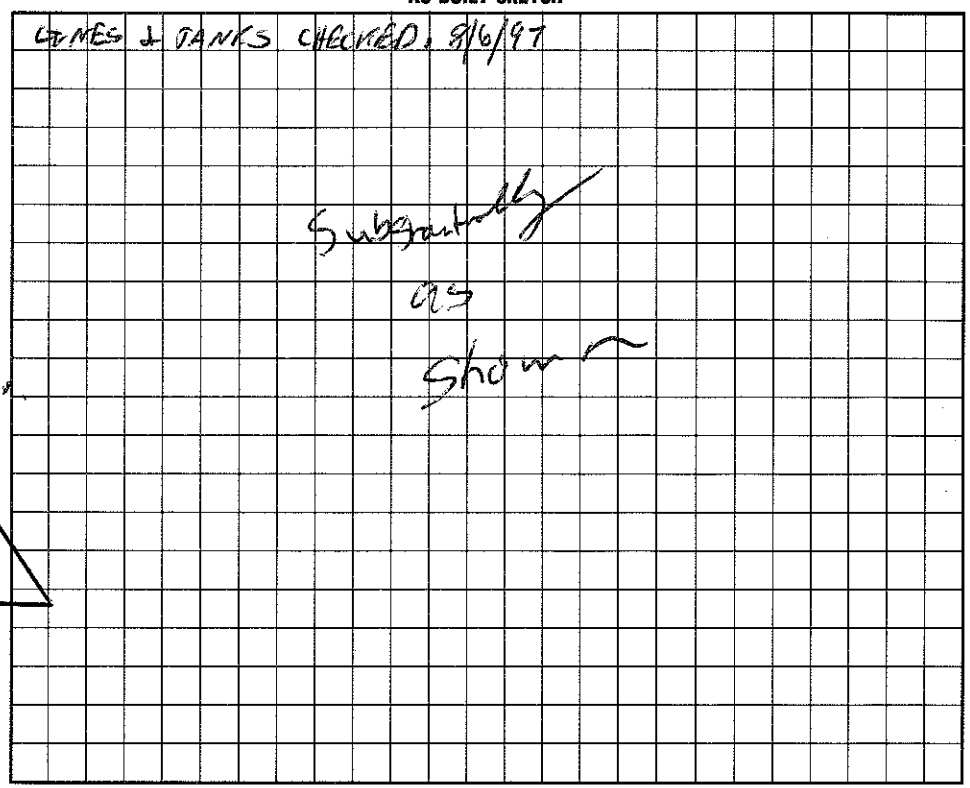

I understand that this permit can be suspended or revoked if any false information is supplied toward securing the permit/any unauthorized changes are made to the site/any unauthorized changes are made in the installation of the system. Improvement Permit is valid for 60 months from date of issuance.

Signed: Thomas Claude Bailey

Installed by: G & M Enterprises

Improvement Permit by: _____ date 7/24/97

Existing System Inspection by: _____ date 7/24/97

Certificate of Completion by: _____ date _____

Operation Permit by: _____ date 9/15/97

Authorization to construct

HEALTH DEPT. COPY: WHITE INSPECTION COPY (FINAL): GREEN OWNER COPY (FINAL): YELLOW INSPECTION COPY (INITIAL): PINK OWNER COPY (INITIAL): GOLD