IREDELL COUNTY HEALTH DEPARTMENT

Redraw 9 3

STATESVILLE 704-878-5305 MOORESVILLE 704-664-5281

IMPROVEMENT PERMIT / AUTHORIZATION TO CONSTRUCT / OPERATION PERMIT / EXISTING SYSTEM INSPECTION

PERMIT# 148416 PIN# 4750068409.000 4750-06-8423 DATE 7/24/08

OWNER OR APPLICANT Lowe's (Joe Hilton) PHONE: Business 704 996-6330 Home 336-658-4018

ADDRESS 1000 Lowes Blvd Mooresville NC 28115

LOCATION Hwy 21 N TR Houston Rd. property on right

SUBDIVISION _____ BLOCK / SECTION _____ LOT _____ LOT AREA 19 acres SITE CLASS. PS DESIGN FLOW 900gpd L.T.A.R. .25

36 employees

Septic Tank: ~~2000~~ 2100 Gallons; STB 548 Date 7-21-08

Pump Tank: 2000 Gallons; PT 494 Date 9-4-05

Pump Make: ZOELLER Model 10-10SR Serial No. _____

Nitrification Field: No Fields 1 Square Feet 2760 Linear Feet 920'

No Lines 7 Trench Width 36" Max Trench Bottom Depth 36"

☑ New System ☐ Repair ☐ Expansion System Type: I II III IV V VI

System Description: Pump to PM 25% Reduction

Repair System Description: Same

Maintenance Agreement Required: ☐ Yes ☑ No

☐ House/Mod. Home No. Bedrooms ____

☐ Mobile Home No. Persons ____

☑ Business No. Employees 36


☑ Other Lowe's Planogram

Water Supply: ☑ Individual ☐ Public ☐ Community

Gravel Depth N/A ☐ Gravity ☑ Pressure ☐ Slab ☐ Crawl Space ☐ Basement w/plumbing ☐ Basement wo/plumbing


Comments/Conditions: Not Drawn to Scale
Initial Soil work & Layout by Paul Pennington of SS ME

INITIAL SITE SKETCH

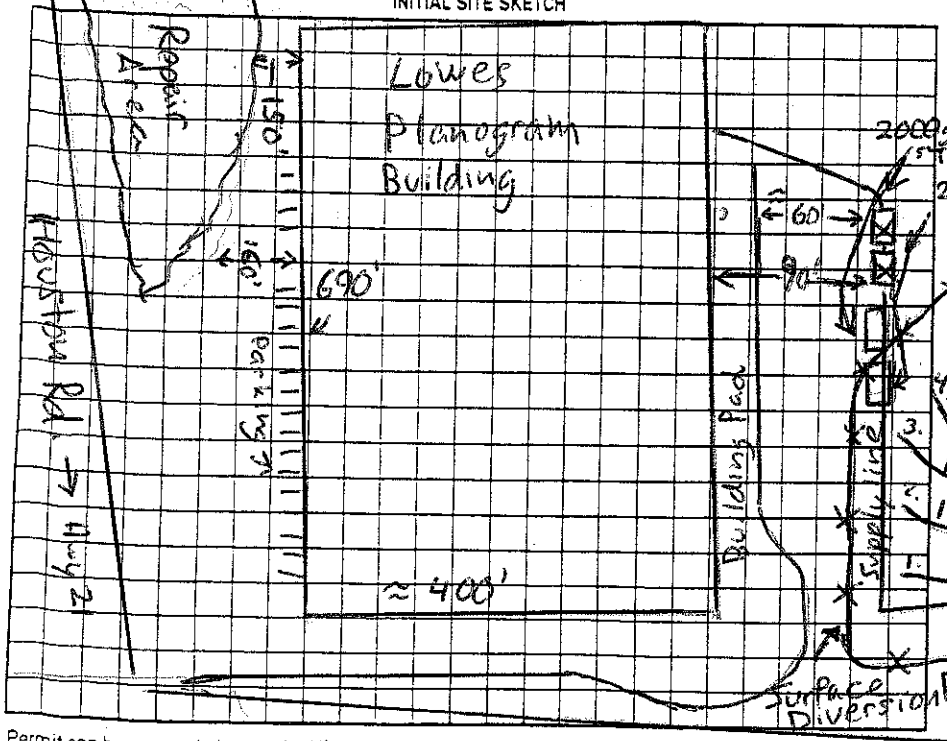

Comments/Conditions: Due to Landscape position Install surface diversion ditch as shown

AS BUILT SKETCH

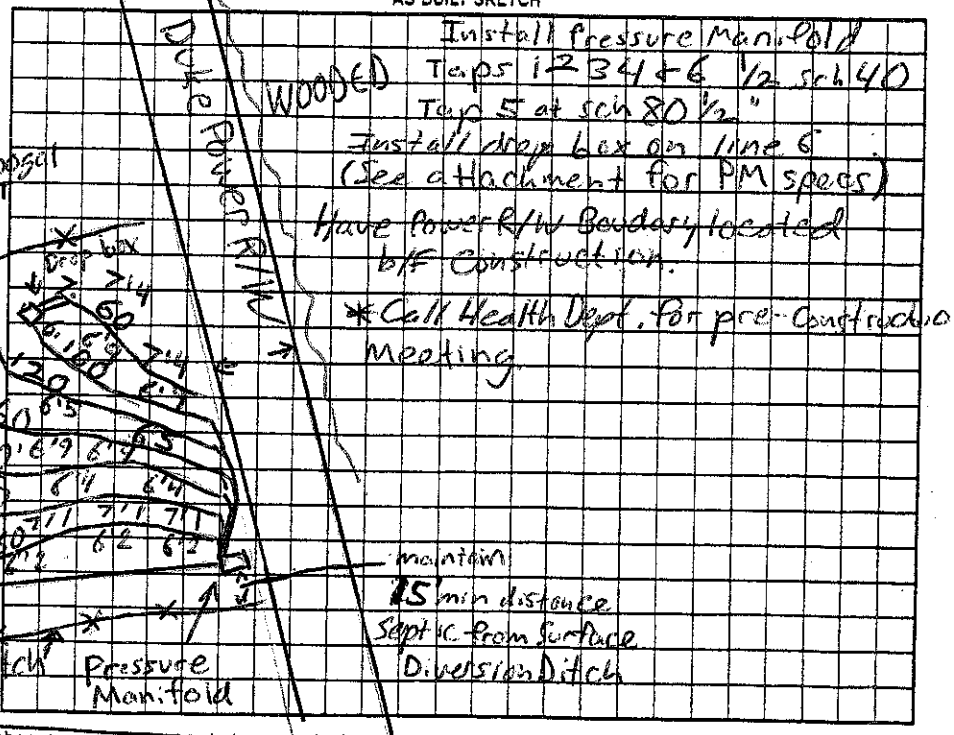

Permit can be suspended or revoked if any false information is supplied toward securing the permit/any unauthorized changes are made to the site/any unauthorized changes are made in the installation of the system. Improvement Permit with plat valid without expiration ☐ Improvement Permit with site plan valid for sixty months ☐ Authorization to Construct is valid for a period equal to that of Improvement Permit – not to exceed sixty months.

Signed: Ed Boothe Vannoy date 7-25-08 Installed by: ~~BNS Grading~~ V&S Grading

Improvement Permit by: Anthony Coker Jr. R.S. date 7/24/08 Operation Permit by: Wesley Sparks R.S. date 11/24/08

Authorization to Construct by: Anthony Coker Jr. R.S. date 7/24/08 Existing System Inspection by: _____ date _____

HEALTH DEPT. COPY: WHITE OWNER COPY (FINAL): YELLOW OWNER COPY (INITIAL): PINK