ICHD - ENVIRONMENTAL HEALTH DIVISION

Statesville Office (704) 878-5305 | Mooresville Office (704) 660-3625 (DW) | PERMIT # AP 325962

SEPTIC: IMPROVEMENT PERMIT / AUTHORIZATION TO CONSTRUCT / OPERATION PERMIT / EXISTING SYSTEM

PIN # 4750 -- 14 -- 3914 ✓

APPLICANT/OWNER: Debra Arthurs | APPLICANT ADDRESS: 275 Houston Rd Troutman, NC 28166

SITE ADDRESS: 275 Houston Rd Troutman, NC ✓ | PHONE: 704 880 7286 Jeff | ALT. PHONE 980-759-5232

SITE DIRECTIONS: LS 21 N TR Houston Rd Cross I-77 on left by Power lines | SAP CONTROLLED: N/A ☐ YES ☐ NO


SUBDIVISION: | SECTION: | LOT # | LOT AREA: ~.754 ac | DESIGN FLOW: 240 gpd | L.T.A.R.:

Septic Tank	Exist	(gal)	STB	Date	☐ New System ☐ Repair ☐ Expansion	System Type: I II III IV V VI	☒ Residence	No. Bedrooms	2	Water Supply	
Pump Tank		(gal)	PT	Date	System Description: Exist. Gravity – Convent (Gravel)		☐ Business	No. Persons	4	☐ Private	
Pump Make		Model		Serial #	Repair System Description:		☐ Other	No. Employees		☒ Public	
# Nitrification Fields		# Lines	Existing	Linear Ft	Maintenance Agreement Required:	☐ YES ☒ NO	☐ Slab	☒ Crawl Space		☐ Community	
Trench Width		Trench Bottom Depth(Low side)		Gravel Depth		☒ GRAVITY ☐ PRESSURE	☐ Basement w/plumbing			☐ Basement w/o plumbing	

Comments / Conditions: ~~X~~ No Vehicular traffic over Septic Must Keep Mfl at least 5ft (with no drain) from Septic

~~X~~ Must Keep Mfl at least 25ft from existing well (unless well is properly abandoned)

INITIAL SITE SKETCH

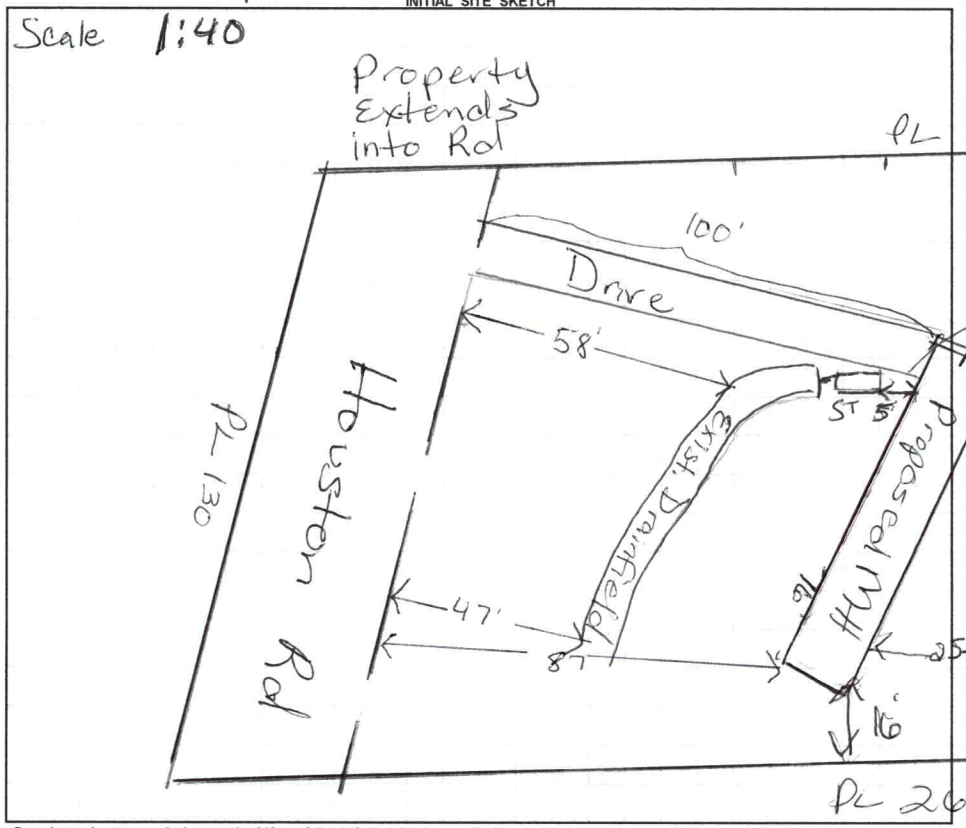

AS BUILT SKETCH

FOR SEPTIC FINAL INSPECTION CALL: 704-664-3703 between 8am-9am the day the inspection is needed. Be sure to speak with an inspector to confirm your time.

Permit can be suspended or revoked if any false information is supplied toward securing the permit / any unauthorized changes are made to the site / any unauthorized changes are made in the installation of the system. **CONTACT A LOCATOR SERVICE PRIOR TO ANY EXCAVATION**

☐ **IMPROVEMENT PERMIT** *with plat valid without expiration.* ☐ **IMPROVEMENT PERMIT** *with site plan valid for 60 mos.* ☐ **AUTHORIZATION TO CONSTRUCT** *valid for period equal to IMPROVEMENT PERMIT--not to exceed 60 mo.*

Owner / Applicant Signature: [signature] Date: 4-8-2022 | Installed by:

IMPROVEMENT PERMIT by: Date: | OPERATION PERMIT by: Date:

AUTHORIZATION TO CONSTRUCT by: Date: | Existing System Inspected by: Maria Dotson Date: 4/7/22

FOR SEPTIC FINAL INSPECTION: CALL 704-664-3703 between 8am-9am the day the inspection is needed.

Acknowledgement Of
Plans Submittal ONLY!

Jeffrey Colbert Date 2-22-2022


Maria Dotson Date 4/7/22



Jeffrey Colbert

CONNECTGIS WEB HOSTING

North Carolina Iredell County

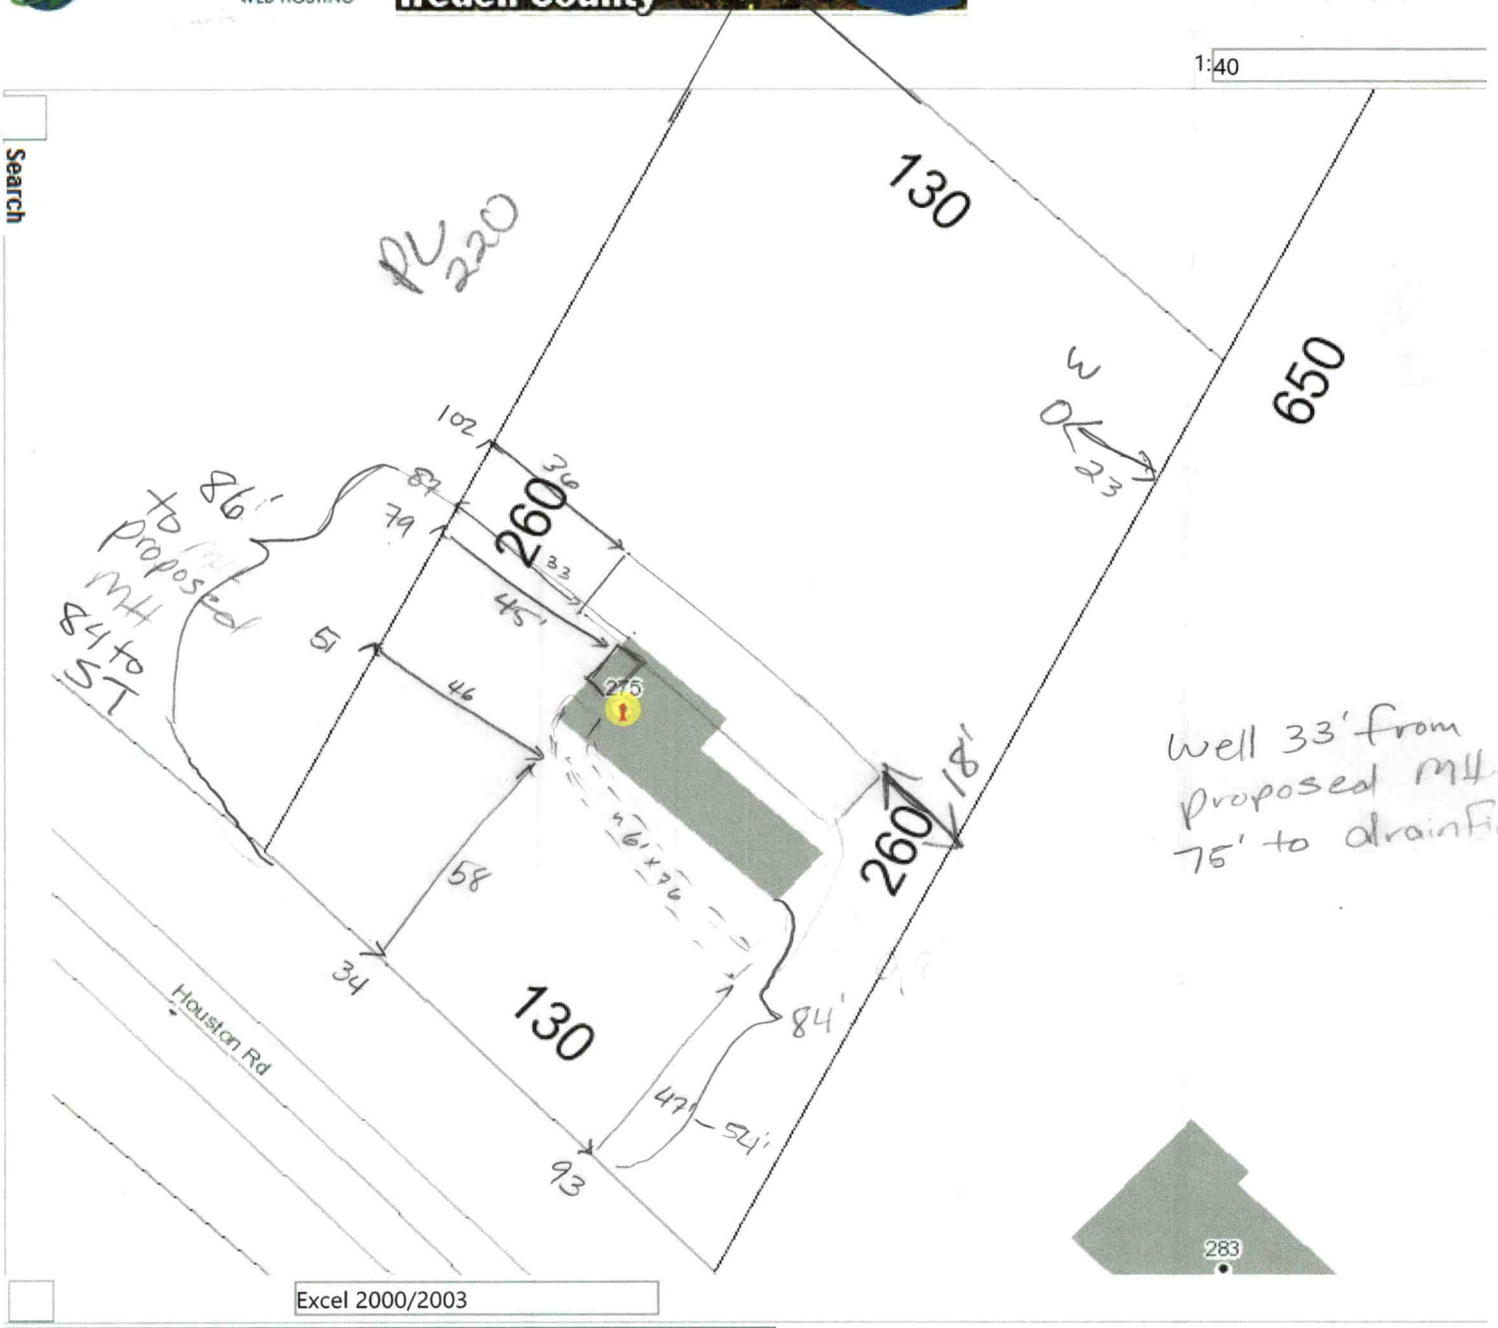

		Address	City	State	Zip	Street Name
1		275 HOUSTON RD	TROUTMAN	NC	28166	HOUSTON


471
93
House
6'1"76"
58
34
34
33
45
46
102
57
79
51