IREDELL COUNTY HEALTH DEPARTMENT

→ Authorization to Construct

STATESVILLE 704-878-5305 MOORESVILLE 704-664-5281

IMPROVEMENT PERMIT / ~~CERTIFICATE OF COMPLETION~~ / OPERATION PERMIT / EXISTING SYSTEM INSPECTION

PROPERTY DESCRIPTION NO. 23051 DATE 2/10/96 TAX MAP NO. 4L 3A 21 Watershed: ☐ Yes ☒ No

OWNER OR CONTRACTOR Larry Glenn Myers PHONE: Business 4750185512 Home Lic4-8000 to

ADDRESS 716-17 N Blood St. Mooresville, NC 28115

LOCATION Summerstree - Front Lawn of Property (2) at stop sign to last vacant lot on (L)

SUBDIVISION Summerstree BLOCK / SECTION 8 LOT 21 LOT AREA ~1AC SITE CLASS. PS DESIGN FLOW 360 L.T.A.R. .3

Septic Tank: 1000 Gallons; STB 794 Date 12/11/95

Pump Tank: _____ Gallons; PT _____ Date _____

Pump Make: _____ Model _____ Serial No. _____

Nitrification Field: No Fields 1 Square Feet 1200 Linear Feet 400

No Lines 4 Trench Width 36" Max Trench Bottom Depth 36" Gravel Depth 12"

☒ New System ☐ Repair System Type: I, (II), III, IV, V, VI

System Description: Gravity Conventional

Repair System Description: _____

Maintenance Agreement Required: ☐ Yes ☒ No

☒ House/Mod. Home No. Bedrooms 3

☐ Mobile Home No. Bathrooms 2

☐ Business No. Employees _____

☐ Other _____

☐ Slab ☒ Crawl Space ☐ Basement w/plumbing ☐ Basement wo/plumbing


Water Supply: ☒ Individual ☐ Community ☐ Public

Comments:


Comments:

installed as shown on stop Permit

INITIAL SITE SKETCH

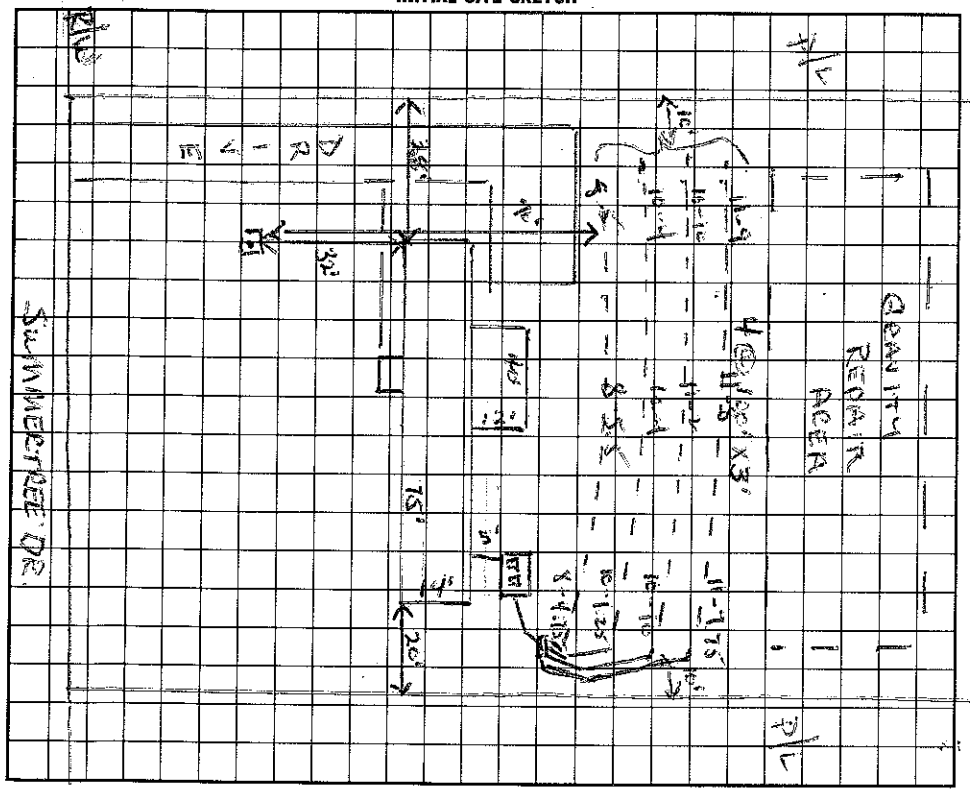

AS BUILT SKETCH

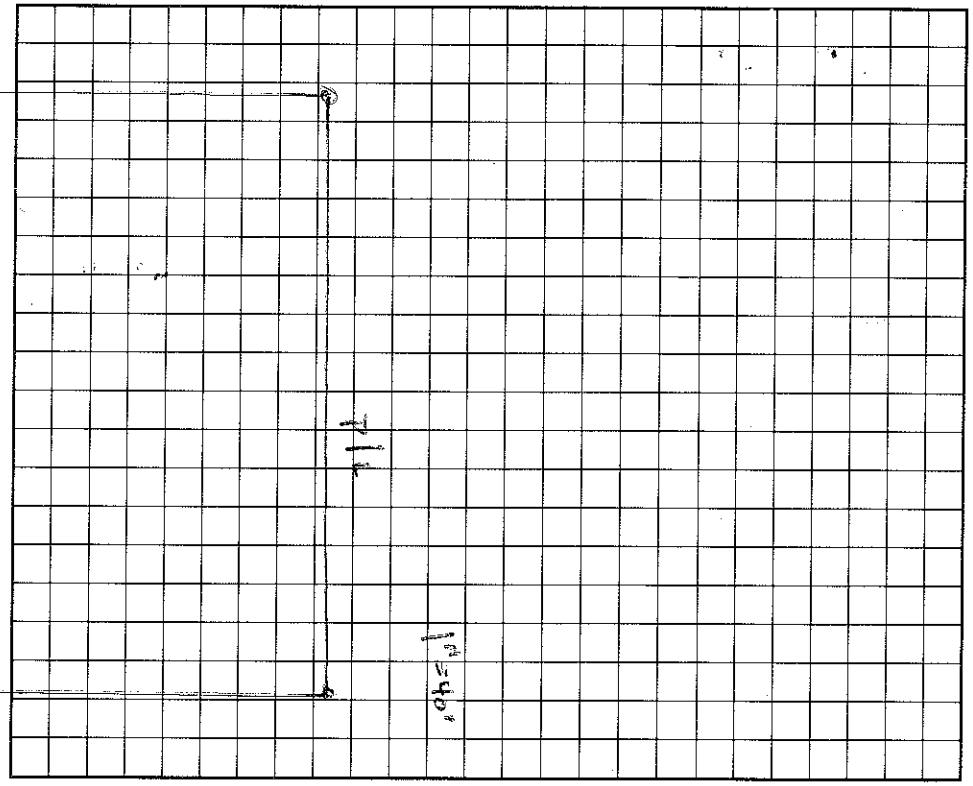

I understand that this permit can be suspended or revoked if any false information is supplied toward securing the permit/any unauthorized changes are made to the site/any unauthorized changes are made in the installation of the system.

Signed: X _____

Improvement Permit by: Wesley Sparks RS date 2/10/96

Existing System Inspection by: Wesley Sparks RS date 2/10/96

Installed by: Larry Beam

Certificate of Completion by: Wesley Sparks RS date 2/27/96

Operation Permit by: Wesley Sparks RS date 2/27/96

HEALTH DEPT. COPY: WHITE INSPECTION COPY (FINAL): GREEN OWNER COPY (FINAL): YELLOW INSPECTION COPY (INITIAL): PINK OWNER COPY (INITIAL): GOLD