IREDELL COUNTY HEALTH DEPARTMENT

Authorization to Construct

STATESVILLE 704-878-5305 MOORESVILLE 704-664-5281

4750194253

IMPROVEMENT PERMIT / ~~CERTIFICATE OF COMPLETION~~ / OPERATION PERMIT / EXISTING SYSTEM INSPECTION

PROPERTY DESCRIPTION NO. 23158 DATE 3/4/96 TAX MAP NO. 4L 37A 26 Watershed: ☐ Yes ☒ No

OWNER OR CONTRACTOR PAG KUE co Of Town MH PHONE: Business _____ Home 876-2155

ADDRESS 2109 Shelton Ave Statesville, NC.

LOCATION Summertree Dr. - Os County TR Frontlinewoods Rd stop sign, (R) onto 1st driveway (R), 1st at end of drive

SUBDIVISION Summertree BLOCK / SECTION _____ LOT 26 LOT AREA ~1.5AC SITE CLASS. PS DESIGN FLOW 360 L.T.A.R. .3

Septic Tank: Trinity Gallons; STB _____ Date _____

Pump Tank: _____ Gallons; PT _____ Date _____

Pump Make: _____ Model _____ Serial No. _____

Nitrification Field: No Fields 1 Square Feet 450 Linear Feet 850

No Lines 2 Trench Width 36" Max Trench Bottom Depth 36" Gravel Depth 12"

☐ New System ☐ Repair System Type: I II III IV V VI

System Description: Add to original system

Repair System Description: _____

Maintenance Agreement Required: ☐ Yes ☒ No

☐ House/Mod. Home ☒ Mobile Home ☐ Business ☐ Other

No. Bedrooms 3 No. Bathrooms 2 No. Employees _____


☐ Slab ☒ Crawl Space ☐ Basement w/plumbing ☐ Basement wo/plumbing

Water Supply: ☒ Individual ☐ Community ☐ Public

Comments:

Comments:

INITIAL SITE SKETCH

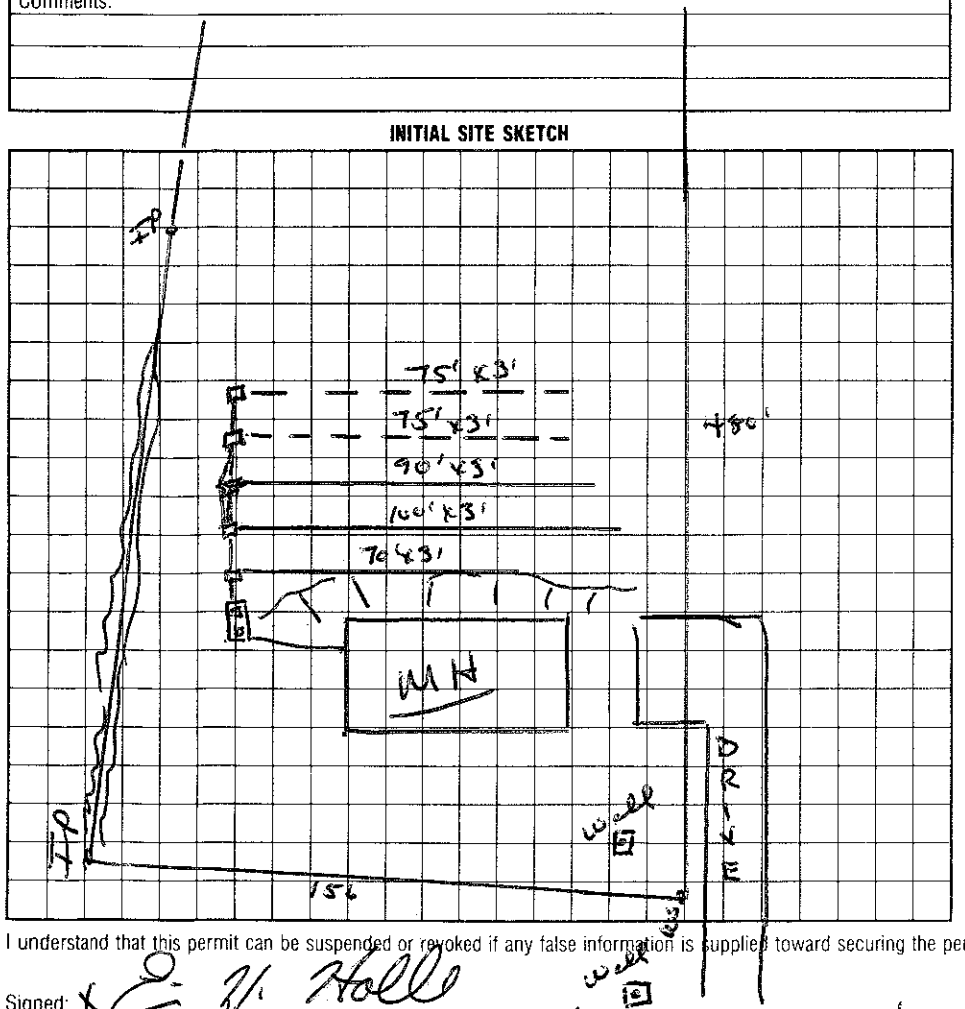

AS BUILT SKETCH

I understand that this permit can be suspended or revoked if any false information is supplied toward securing the permit/any unauthorized changes are made to the site/any unauthorized changes are made in the installation of the system.

Signed: X E. L. Hall

Improvement Permit by: Wesley Sparks RS. date 3/4/96

Authorization to Construct: Wesley Sparks RS date 3/4/96

Installed by: A-1 Backhoe Svcs

Certificate of Completion by: _____ date _____

Operation Permit by: Wesley Sparks RS date 3/27/96

HEALTH DEPT. COPY: WHITE INSPECTION COPY (FINAL): GREEN OWNER COPY (FINAL): YELLOW INSPECTION COPY (INITIAL): PINK OWNER COPY (INITIAL): GOLD

IREDELL COUNTY HEALTH DEPARTMENT

STATESVILLE 704-878-5305 MOORESVILLE 704-664-5281

IMPROVEMENT PERMIT / CERTIFICATE OF COMPLETION / OPERATION PERMIT / EXISTING SYSTEM INSPECTION

PROPERTY DESCRIPTION NO. 19195 DATE 7/15/94 TAX MAP NO. 4L 3A 26 Watershed: ☐ Yes ☑ No

OWNER OR CONTRACTOR Allen Crowe PHONE: Business _____ Home 873-1431

ADDRESS 2016 Northside Dr. Statesville, NC.

LOCATION Franklinwood Rd. to stop sign TR to last lot on (R), lot behind lot on Road

SUBDIVISION Summertree BLOCK / SECTION _____ LOT 26 LOT AREA ~1.5 AC SITE CLASS. P DESIGN FLOW 240 L.T.A.R. .3

Septic Tank: 1000 Gallons; STB 794 Date 6/21/94
Pump Tank: _____ Gallons; PT _____ Date _____
Pump Make: _____ Model _____ Serial No. _____
Nitrification Field: No Fields 1 Square Feet 800 Linear Feet 260
No Lines 3 Trench Width 3' Max Trench Bottom Depth 30-32" Gravel Depth _____

☑ New System ☐ Repair System Type: I, II, III, IV, V, VI
System Description: CONV - DRIP BOX
Repair System Description: _____
Maintenance Agreement Required: ☐ Yes ☑ No


☑ House/Mod. Home No. Bedrooms 2
☐ Mobile Home No. Bathrooms 2
☐ Business No. Employees _____
☐ Other _____
☐ Slab ☑ Crawl Space ☐ Basement w/plumbing ☐ Basement wo/plumbing

Water Supply:
☑ Individual
☐ Community
☐ Public

Comments:
Install as shown. Watch distances from wells and property lines.

Comments:

INITIAL SITE SKETCH

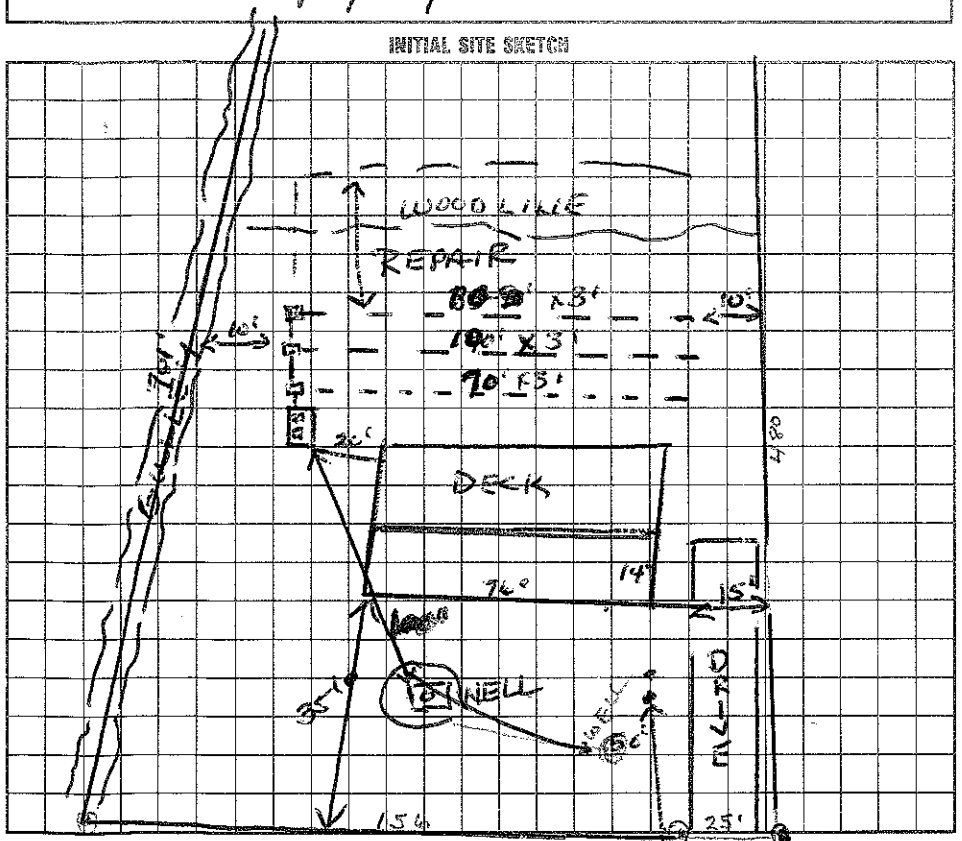

AS BUILT SKETCH

I understand that this permit can be suspended or revoked if any false information is supplied toward securing the permit/any unauthorized changes are made to the site/any unauthorized changes are made in the installation of the system. Improvement Permit is valid for 60 months from date of issuance.

Signed: [signature]

Improvement Permit by: Wesley Sparks RS. date 7/15/94

Existing System Inspection by: _____ date _____

Installed by: Dennis Belcher

Certificate of Completion by: Wesley Sparks RS. date 7/25/94

Operation Permit by: _____ date _____

HEALTH DEPT. COPY: WHITE INSPECTION COPY (FINAL): GREEN OWNER COPY (FINAL): YELLOW INSPECTION COPY (INITIAL): PINK OWNER COPY (INITIAL): GOLD