IREDELL COUNTY HEALTH DEPARTMENT

STATESVILLE 704-878-5305 MOORESVILLE 704-664-5281

IMPROVEMENT PERMIT / CERTIFICATE OF COMPLETION / OPERATION PERMIT / EXISTING SYSTEM INSPECTION

PROPERTY DESCRIPTION NO. 19575 DATE 10/17/94 TAX MAP NO. 4L 3A 29 Watershed: ☐ Yes ☒ No

OWNER OR CONTRACTOR Sabrina Stidham PHONE: Business Home 664-6034

ADDRESS 2431 Kerr Ave. Mooresville, NC. 28115 4750197103

LOCATION End of Summertime Dr. behind last Lot Lot 30

SUBDIVISION Summertime BLOCK / SECTION LOT 29 LOT AREA ~2Ac. SITE CLASS. P DESIGN FLOW 360 L.T.A.R. .25-.3

Septic Tank: 1000 Gallons; STB 824-Mull Date 8-28-94
Pump Tank: Gallons; PT Date
Pump Make: Model Serial No.
Nitrification Field: No Fields 1 Square Feet 1200 Linear Feet 400
No Lines 4 Trench Width 36" Max Trench Bottom Depth 36" Gravel Depth 12"

☒ New System ☐ Repair System Type: I, II, III, IV, V, VI
System Description: Disp Bed-Conventional
Repair System Description: None
Maintenance Agreement Required: ☐ Yes ☐ No


☒ House/Mod. Home No. Bedrooms 3
☐ Mobile Home No. Bathrooms 2
☐ Business No. Employees
☐ Other
☐ Slab ☒ Crawl Space ☐ Basement w/plumbing ☐ Basement wo/plumbing

Water Supply:
☒ Individual
☐ Community
☐ Public


Comments:
Follow contours in direction shown.

Comments:
MH not set up & well not installed as of 11/4/94

INITIAL SITE SKETCH

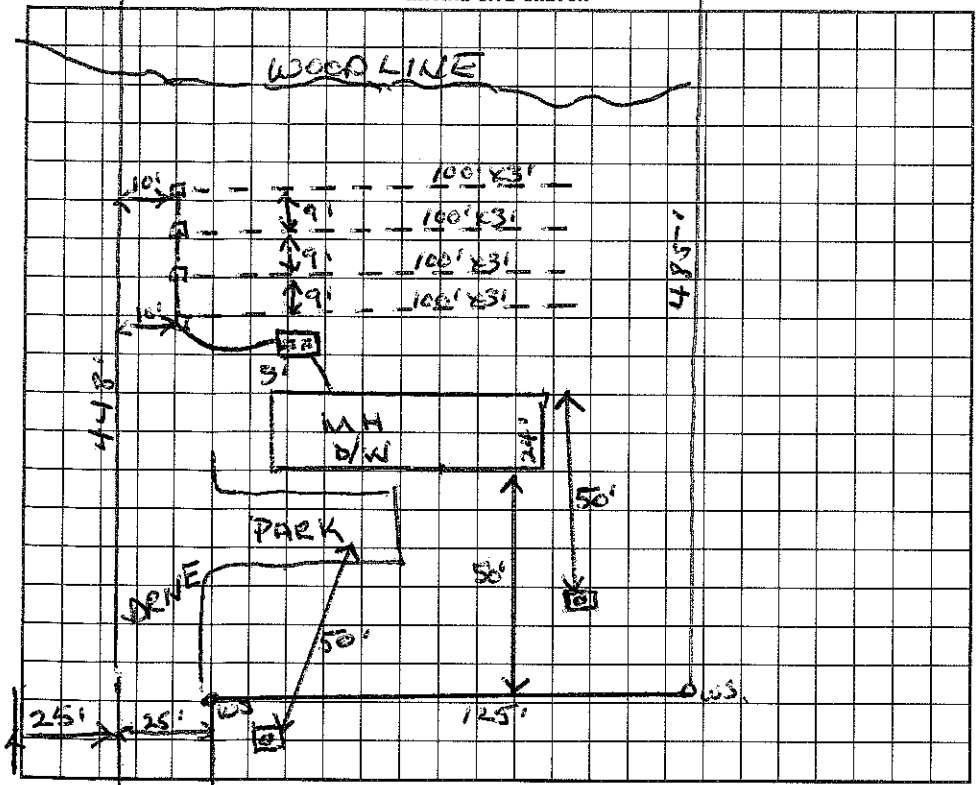

AS BUILT SKETCH

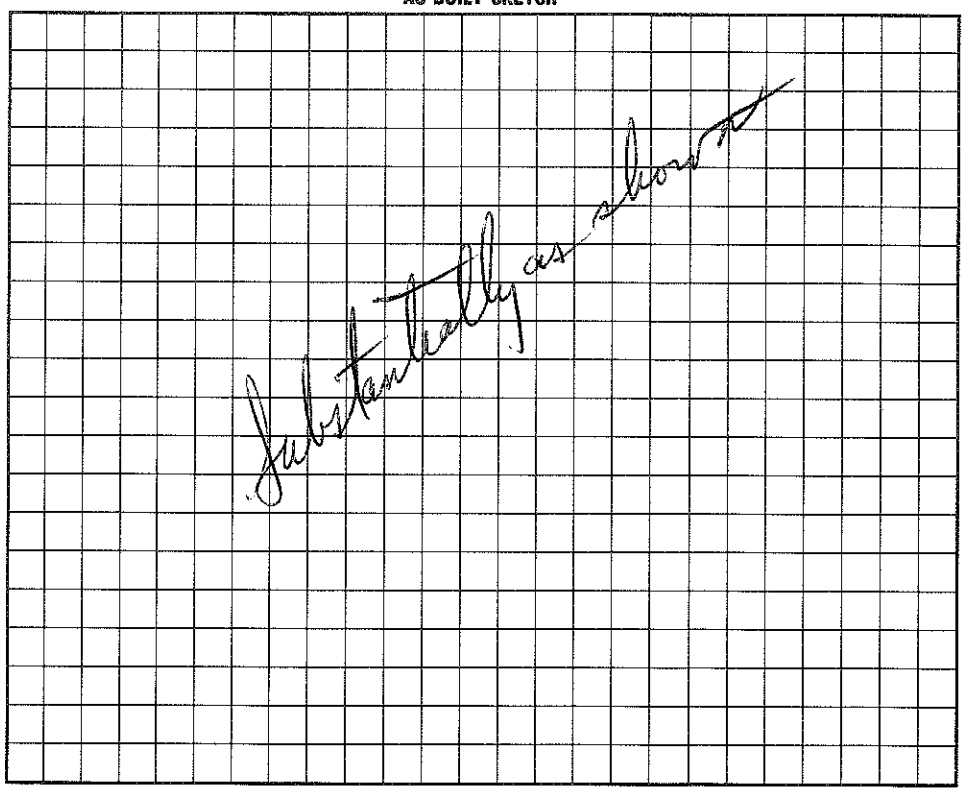

I understand that this permit can be suspended or revoked if any false information is supplied toward securing the permit/any unauthorized changes are made to the site/any unauthorized changes are made in the installation of the system. Improvement Permit is valid for 60 months from date of issuance.

Signed: James E. Stilley

Improvement Permit by: Wesley Sparks RS date 10/17/94

Existing System Inspection by: date

Installed by: Gary Mulkey / Gulf Enterprises

Certificate of Completion by: Jack Hoffman, RS date 11/4/94

Operation Permit by: date

HEALTH DEPT. COPY: WHITE INSPECTION COPY (FINAL): GREEN OWNER COPY (FINAL): YELLOW INSPECTION COPY (INITIAL): PINK OWNER COPY (INITIAL): GOLD