4750197543

IREDELL COUNTY HEALTH DEPARTMENT

STATESVILLE 704-878-5305 MOORESVILLE 704-664-5281

IMPROVEMENT PERMIT / CERTIFICATE OF COMPLETION / OPERATION PERMIT / EXISTING SYSTEM INSPECTION

PROPERTY DESCRIPTION NO. 22403 DATE 11/3/95 TAX MAP NO. 4L-3A-36 Watershed: ☐ Yes ☒ No

OWNER OR CONTRACTOR Kirkman James Baccicini PHONE: Business _____ Home 664-7447

ADDRESS 871-A Williamson Rd. 28115

LOCATION end of Lenard Lipton Ln, straight at end of cul de sac

SUBDIVISION Summerlin BLOCK / SECTION _____ LOT 36 LOT AREA ~1.34ac SITE CLASS. PS DESIGN FLOW 360 L.T.A.R. .3

Septic Tank: 1000 Gallons; STB 825 Date 9-7-95

Pump Tank: _____ Gallons; PT _____ Date _____

Pump Make: _____ Model _____ Serial No. _____

Nitrification Field: No Fields 1 Square Feet 1200 Linear Feet ~~X~~ 300

No Lines 4 Trench Width 36" Max Trench Bottom Depth 36" Gravel Depth 6" STONE

☒ New System ☐ Repair System Type: I, II, III, IV, V, VI

System Description: INFILTRATER

Repair System Description: _____

Maintenance Agreement Required: ☐ Yes ☐ No

☐ House/Mod. Home No. Bedrooms ____

☐ Mobile Home No. Bathrooms ____

☐ Business No. Employees ____

☐ Other _____


☐ Slab ☐ Crawl Space ☐ Basement w/plumbing ☐ Basement wo/plumbing

Water Supply:
☐ Individual
☐ Community
☐ Public


Comments: ~~X~~ 300 FT of gravity INFILTRATOR
Well location must conform to 2c Well Regulations
Lines on slope contours in direction shown

Comments:

INITIAL SITE SKETCH

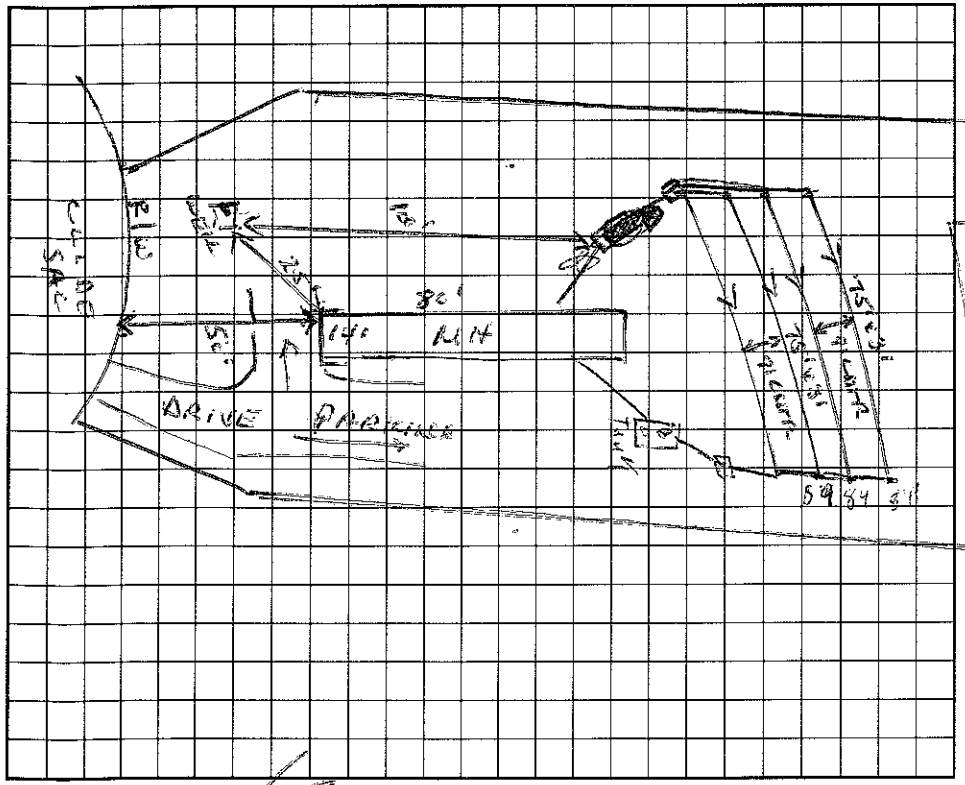

AS BUILT SKETCH

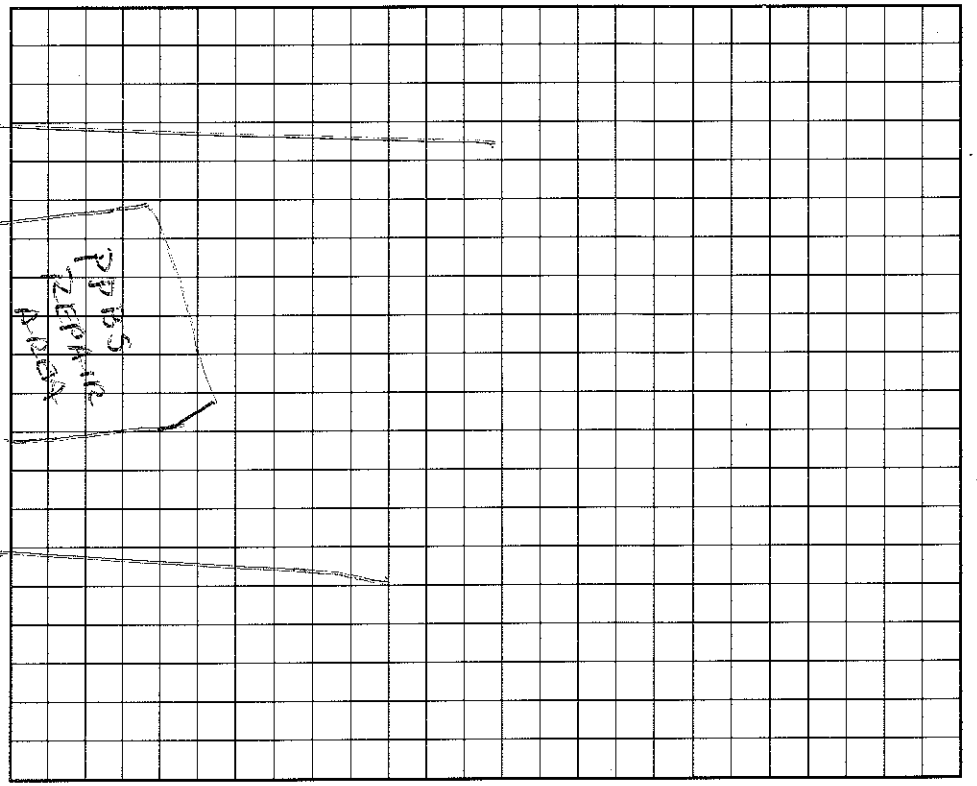

I understand that this permit can be suspended or revoked if any false information is supplied toward securing the permit/any unauthorized changes are made to the site/any unauthorized changes are made in the installation of the system.

Signed: ~~X~~

Improvement Permit by: Wesley Sparks RS date 11/3/95

Existing System Inspection by: Wesley Sparks RS date 11/3/95

Installed by: Wayne Ellis

Certificate of Completion by: Wesley Sparks RS date 12/11/95

Operation Permit by: Wesley Sparks RS date 12/11/95

HEALTH DEPT. COPY: WHITE INSPECTION COPY (FINAL): GREEN OWNER COPY (FINAL): YELLOW INSPECTION COPY (INITIAL): PINK OWNER COPY (INITIAL): GOLD

4750197543

IREDELL COUNTY HEALTH DEPARTMENT

STATESVILLE 704-878-5305 MOORESVILLE 704-664-5281

IMPROVEMENT PERMIT / CERTIFICATE OF COMPLETION / OPERATION PERMIT / EXISTING SYSTEM INSPECTION

PROPERTY DESCRIPTION NO. 16690 DATE 7/26/93 TAX MAP NO. 4L 3A 36

OWNER OR CONTRACTOR CLARENCE M BLAKELY PHONE: Business 4750197543 Home 410-453-3064

ADDRESS 208 SERENDIPITY LN TROUTMAN

LOCATION LOT 36 SUMMERTREE LN, TO END STRAIGHT OFF CUL DE SAC

SUBDIVISION SUMMERTREE BLOCK / SECTION _____ LOT 36 LOT AREA ~1.3 AC SITE CLASS. P L.T.A.R. .3

Water Supply: ☑ Individual ☐ Community ☐ Public

Septic Tank: 1000 Gallons; STB _____ Date _____

Pump Tank: _____ Gallons; PT _____ Date _____

Nitrification Field: No Fields 1 Square Feet 1200 Linear Feet 200+

No Lines 3 Trench Width 24" Trench Depth 36" Gravel Depth 12"

☑ New System ☐ Repair System Type: I, II, (III) IV, V, VI

System Description: 16" PANEL-GRAVITY

Repair System Description: 16" PANEL

Maintenance Agreement Required: ☑ Yes ☐ No 5 YR.

☑ House/Mod. Home No. Bedrooms 3 Garbage Disposal: ☐ Yes ☑ No

☐ Mobile Home No. Bathrooms 2 Auto. Dishwasher: ☑ Yes ☐ No


☐ Business No. Employees _____ Auto. Washing Machine: ☑ Yes ☐ No

☐ Other _____ Other _____

☐ Slab ☑ Crawl Space ☐ Basement w/plumbing ☐ Basement wo/plumbing

Comments TRENCHES NO DEEPER 36" TO TRENCH BOTTOM; KEEP LINES ON SLOPE CONTOUR IN DIRECTION SHOWN.

INITIAL SITE SKETCH

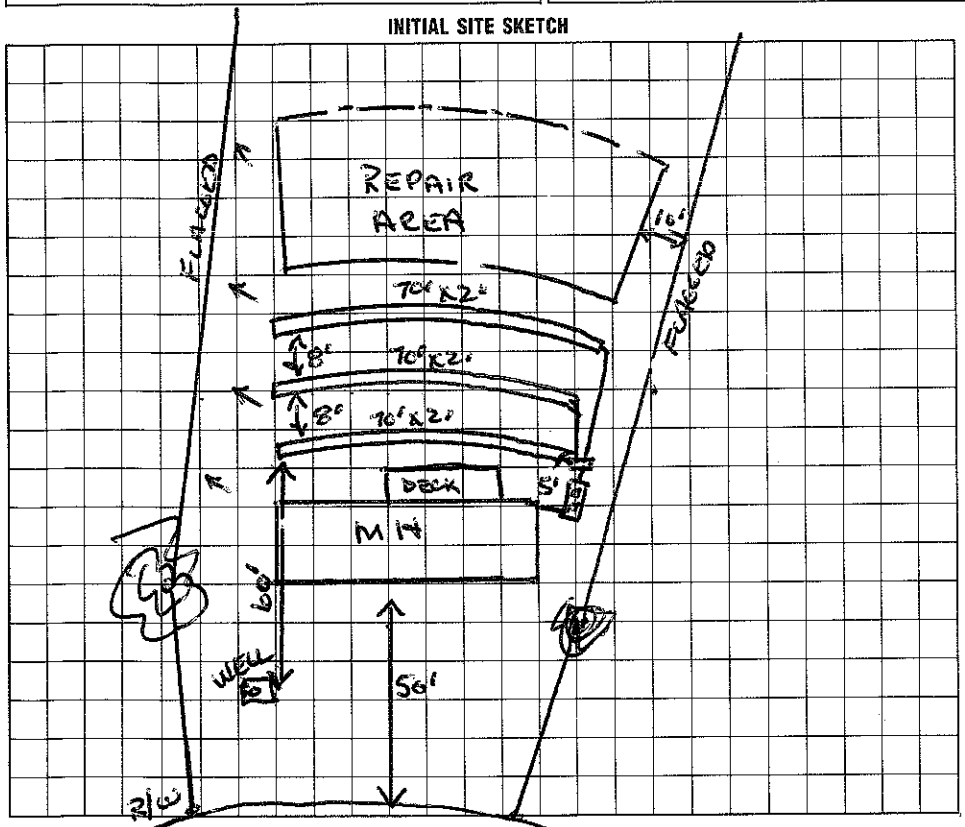

AS BUILT SKETCH

I understand that this permit can be suspended or revoked if any false information is supplied toward securing the permit/any unauthorized changes are made to the site/any unauthorized changes are made in the installation of the system. Improvement Permit is valid for 60 months from date of issuance.

Signed: CUL DE SAC Raymond Allen

Improvement Permit by: Wesley Sparks R.S. date 7/26/93

Existing System Inspection by: _____ date _____

Installed by: Wayne Eller

Certificate of Completion by: _____ date _____

Operation Permit by: Wesley Sparks R.S. date 12/11/95

HEALTH DEPT. COPY: WHITE INSPECTION COPY (FINAL): GREEN OWNER COPY (FINAL): YELLOW INSPECTION COPY (INITIAL): PINK OWNER COPY (INITIAL): GOLD