IREDELL COUNTY HEALTH DEPARTMENT

STATESVILLE 704-878-5305 4750281981 MOORESVILLE 704-664-5281

IMPROVEMENT PERMIT / CERTIFICATE OF COMPLETION / OPERATION PERMIT / EXISTING SYSTEM INSPECTION

PROPERTY DESCRIPTION NO. 18314 DATE 4/25/94 TAX MAP NO. 4L 3A 15 Watershed: ☐ Yes ☒ No

OWNER OR CONTRACTOR James Stiltner PHONE: Business _____ Home 528-5593

ADDRESS 318 Summertree Ln. Troutman, NC 28166

LOCATION Os County @ Franklin woods @ Rainwood TR Summertree to 4th lot on (L)

SUBDIVISION Summertree BLOCK / SECTION 1 LOT 15 LOT AREA .75 Ac SITE CLASS. P DESIGN FLOW 240 L.T.A.R. .3


Septic Tank: 1000 Gallons; STB 794 Date 11/11/93
Pump Tank: _____ Gallons; PT _____ Date _____
Pump Make: _____ Model _____ Serial No. _____
Nitrification Field: No Fields 1 Square Feet 800 Linear Feet 266
No Lines 2 Trench Width 3 Max. Trench Bottom Depth 36" Gravel Depth 12"

☑ New System ☐ Repair System Type: I, ☐ II, III, IV, V, VI
System Description: Conv. - Drop Boxes
Repair System Description: Same
Maintenance Agreement Required: ☐ Yes ☐ No

☑ House/Mod. Home No. Bedrooms 2
☐ Mobile Home No. Bathrooms 2
☐ Business No. Employees ____
☐ Other _____
☐ Slab ☑ Crawl Space ☐ Basement w/plumbing ☐ Basement wo/plumbing

Water Supply:
☑ Individual
☐ Community
☐ Public

Comments:

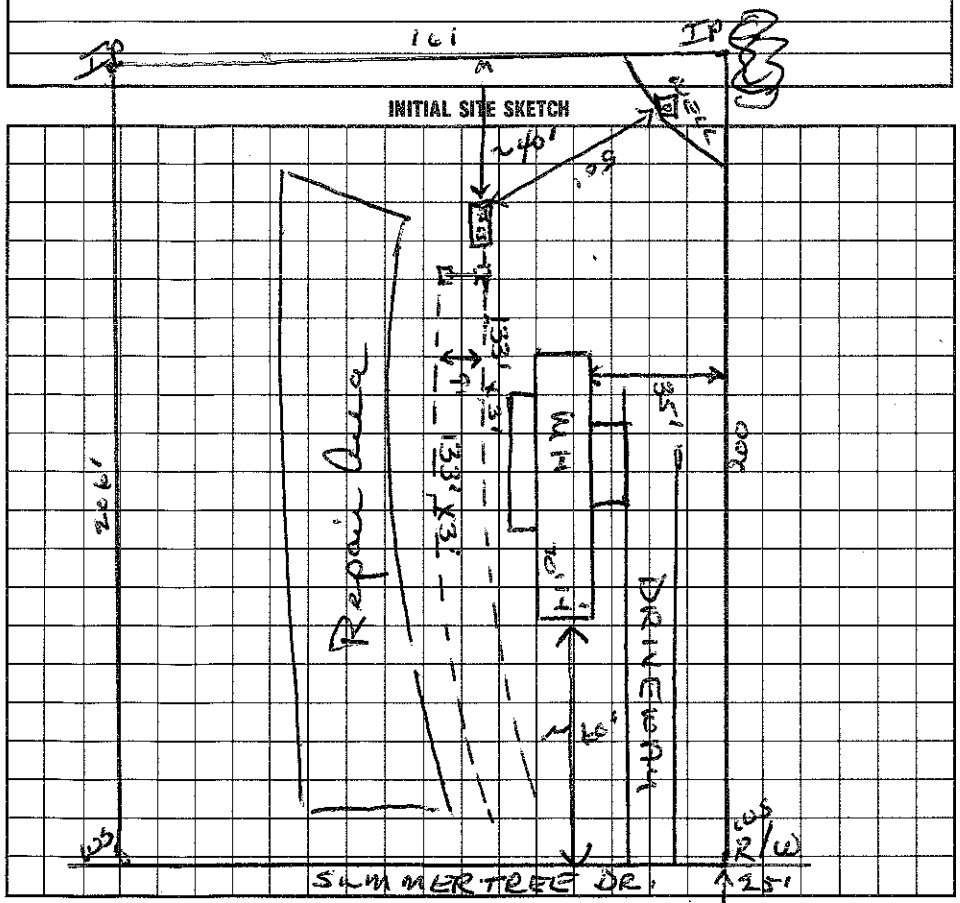

Comments:

installed as drawn.

AS BUILT SKETCH

I understand that this permit can be suspended or revoked if any false information is supplied toward securing the permit/any unauthorized changes are made to the site/any unauthorized changes are made in the installation of the system. Improvement Permit is valid for 60 months from date of issuance.

Signed: Kenneth Stiltner

Improvement Permit by: Wesley Sparks R.S. date 4/25/94

Existing System Inspection by: _____ date _____

Installed by: Dennis Gallehar - A-1 Backhoe

Certificate of Completion by: Wesley Sparks R.S. date 5/17/94

Operation Permit by: _____ date _____

HEALTH DEPT. COPY: WHITE · INSPECTION COPY (FINAL): GREEN · OWNER COPY (FINAL): YELLOW · INSPECTION COPY (INITIAL): PINK · OWNER COPY (INITIAL): GOLD