IREDELL COUNTY HEALTH DEPARTMENT

Authorization to Construct 4750372832

STATESVILLE 704-878-5305 MOORESVILLE 704-664-5281

IMPROVEMENT PERMIT / CERTIFICATE OF COMPLETION / OPERATION PERMIT / EXISTING SYSTEM INSPECTION

PROPERTY DESCRIPTION NO. 23184 DATE 4/16/96 TAX MAP NO. 4F B 85 - 110 Pt of. Watershed: ☐ Yes ☒ No

OWNER OR CONTRACTOR Chris Anthem PHONE: Business Home 528 - 5216

ADDRESS 230 Dunwoody Rd Troutman NC 28166

LOCATION 115 - 21W TR Houston TL Dunwoody to end, on (R) behind trailer

SUBDIVISION BLOCK / SECTION LOT LOT AREA 1.57 Ac. SITE CLASS PS DESIGN FLOW 480 L.T.A.R. .35

Septic Tank: 1000 Gallons; STB 1012 Date 3-5-96

Pump Tank: Gallons; PT Date

Pump Make: Model Serial No.

Nitrification Field: No Fields 1 Square Feet 1371 Linear Feet 457

No Lines 4 Trench Width 36" Max Trench Bottom Depth 36" Gravel Depth 12"

☒ New System ☐ Repair System Type: I II III IV V VI

System Description: Conventional

Repair System Description:

Maintenance Agreement Required: ☐ Yes ☒ No

☒ House/Mod. Home No. Bedrooms 4

☐ Mobile Home No. Bathrooms 2.5

☐ Business No. Employees

☐ Other


☐ Slab ☒ Crawl Space ☐ Basement w/plumbing ☐ Basement wo/plumbing

Water Supply: ☒ Individual ☐ Community ☐ Public DHS


Comments:

Comments:

INITIAL SITE SKETCH

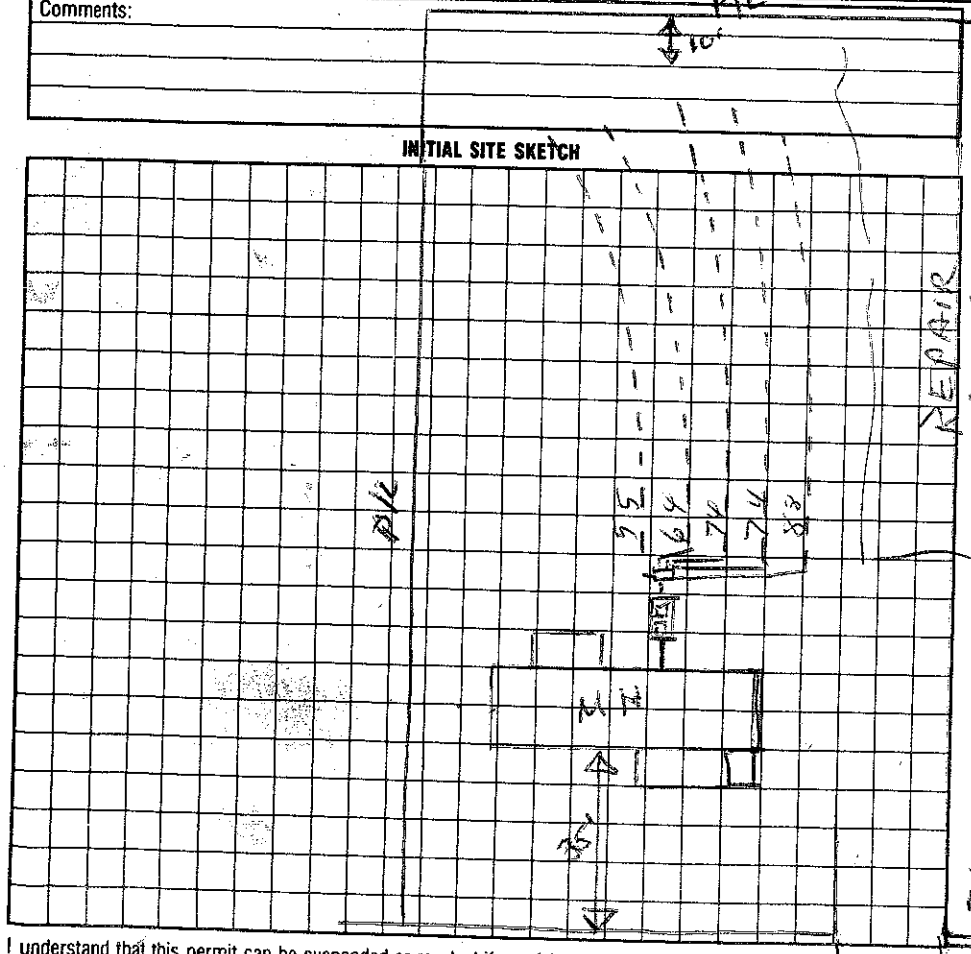

AS BUILT SKETCH

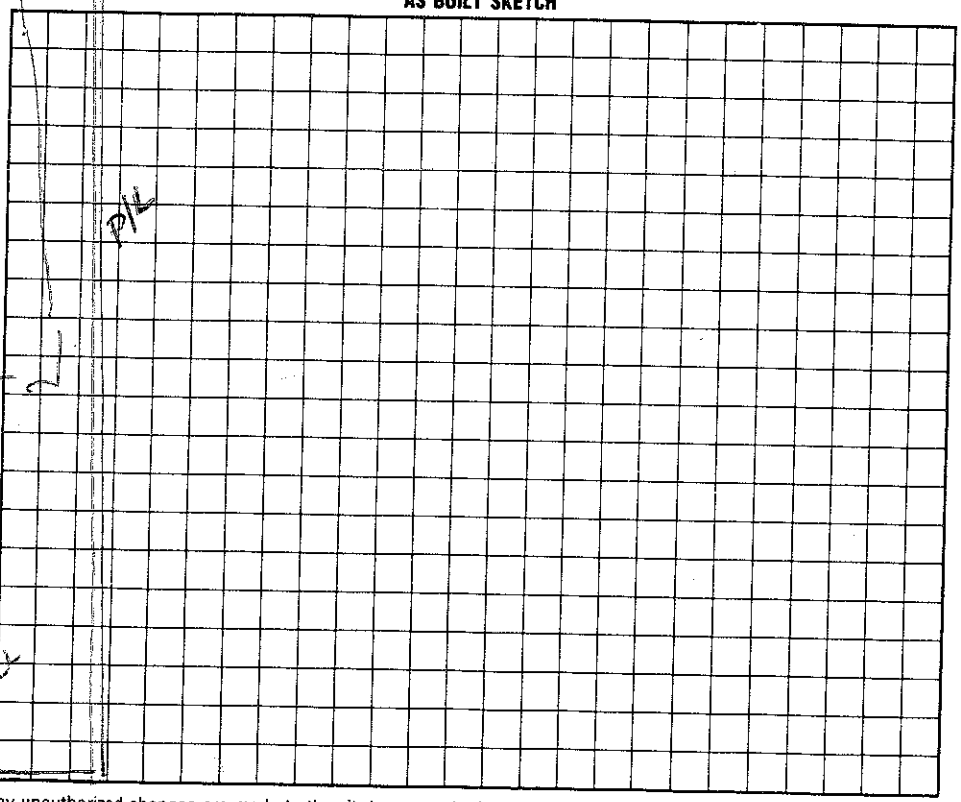

I understand that this permit can be suspended or revoked if any false information is supplied toward securing the permit/any unauthorized changes are made to the site/any unauthorized changes are made in the installation of the system.

Authorization to Construct valid for 5 years.

Signed: X Chris Anthem

Improvement Permit by: date

Existing System Inspection by: Construct Authorization Wesley Sparkman date 4/16/96

Installed by: Dale Fox Grading

Certificate of Completion by: date

Operation Permit by: C. Ruby Green EHSI date 7/26/96

HEALTH DEPT. COPY: WHITE INSPECTION COPY (FINAL): GREEN OWNER COPY (FINAL): YELLOW INSPECTION COPY (INITIAL): PINK OWNER COPY (INITIAL): GOLD