IREDELL COUNTY HEALTH DEPARTMENT

STATESVILLE 704-878-5305 MOORESVILLE 704-664-5281

IMPROVEMENT PERMIT / AUTHORIZATION TO CONSTRUCT / OPERATION PERMIT / EXISTING SYSTEM INSPECTION

PERMIT# 074434 PIN# 4750375499 4750375534 DATE 7/8/98

OWNER OR CONTRACTOR Charles & Tracie Riddle PHONE: Business# 528-1247 Home/WK/M 881-4854

ADDRESS 210 Dunwoody Rd Troutman NC 28166

LOCATION US 21 N TR Hoyston Rd ~ 1½ Mile Dirt Rd Tr Dunwoody on Rt after Curve

SUBDIVISION _____ BLOCK / SECTION _____ LOT _____ LOT AREA .77 Acre SITE CLASS. _____ DESIGN FLOW Existing L.T.A.R. _____

Septic Tank: 1000 Gallons; STB _____ Date _____

Pump Tank: _____ Gallons; PT _____ Date _____

Pump Make: _____ Model _____ Serial No. _____

Nitrification Field: No Fields 1 Square Feet _____ Linear Feet 300'

No Lines 3 at 100' Trench Width Exist Max Trench Bottom Depth _____ Gravel Depth _____

☐ New System ☐ Repair System Type: I, II, III, IV, V, VI

System Description: Existing - Installed 8-18-87

Repair System Description: _____

Maintenance Agreement Required: ☐ Yes ☐ No

☒ House/Mod. Home No. Bedrooms 3

☒ Mobile Home No. Bathrooms 2

☐ Business No. Employees _____

☐ Other _____


☐ Slab ☐ Crawl Space ☒ Basement w/plumbing ☐ Basement wo/plumbing

Water Supply: ☒ Individual ☐ Public ☐ Community

Comments:/Conditions: Existing Septic System appears to be functioning okay at time of inspection, No problems Noticeable. Keep New Home Basement Wall 25' from Septic System.

Comments:/Conditions: Install New Well at least 50' from Septic System. Okay to "Rough-In" Plumbing in Basement & Use "Grinder Pump" to lift Sewage from Basement. May Install D-Box w/Speed Levelers instead of "Drop Boxes".

INITIAL SITE SKETCH Not to Scale

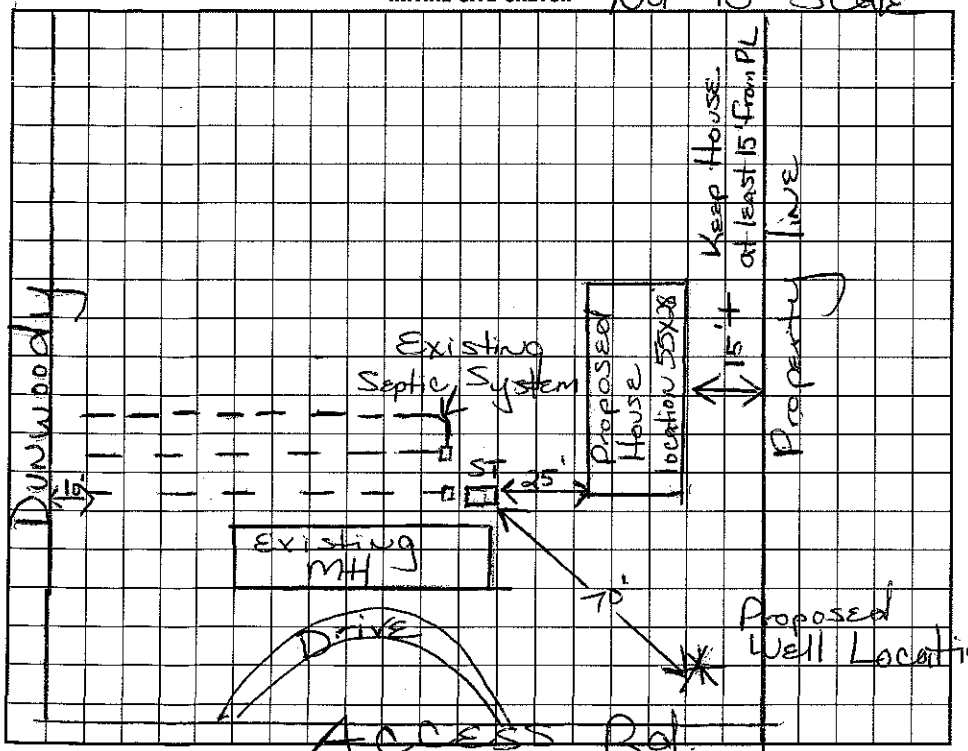

AS BUILT SKETCH

I understand that this permit can be suspended or revoked if any false information is supplied toward securing the permit/any unauthorized changes are made to the site/any unauthorized changes are made in the installation of the system. Improvement Permit with plat valid without expiration. Improvement Permit with site plan valid for sixty months. Authorization to Construct is valid for a period equal to that of Improvement Permit – not to exceed sixty months.

Signed: X Charles A Riddle date _____

Improvement Permit by: Maria H. Dotson date 7/8/98

Authorization to Construct by: Maria H. Dotson date 7/8/98

Installed by: _____

Operation Permit by: _____ date _____

Existing System Inspection by: _____ date _____

HEALTH DEPT. COPY: WHITE INSPECTION COPY (FINAL): GREEN OWNER COPY (FINAL): YELLOW INSPECTION COPY (INITIAL): PINK OWNER COPY (INITIAL): GOLD

Existing System