IREDELL COUNTY HEALTH DEPARTMENT

STATESVILLE 704-878-5305 MOORESVILLE 704-664-5281

IMPROVEMENT PERMIT / AUTHORIZATION TO CONSTRUCT / OPERATION PERMIT / EXISTING SYSTEM INSPECTION

PERMIT# 095130 PIN# 4750385561/0419/5006 DATE 7/9/01

OWNER OR CONTRACTOR Edward Masencup, Jr PHONE: Business _____ Home (704 528-3388

ADDRESS 186 Dunwoody Rd. Troutman, N.C. 28166

LOCATION Hwy 21, (L) Huston, (L) Dunwoody, Gravel drive on right past 2 story Gray house

SUBDIVISION — BLOCK / SECTION — LOT — LOT AREA 38.5 Acres SITE CLASS. #5 DESIGN FLOW 360 L.T.A.R. = 3

Septic Tank: 4000 Gallons: STB 760 Date 11-30-01

Pump Tank: _____ Gallons: PT _____ Date _____

Pump Make: _____ Model _____ Serial No _____

Nitrification Field: No Fields 1 Square Feet 1,200 Linear Feet 400

No Lines 3 Trench Width 36" Max Trench Bottom Depth (20") Gravel Depth 12"

[X] New System [ ] Repair System Type: I, II, (III) IV, V, VI

System Description: Shallow, Conventional/Gravity

Repair System Description: Pump Conventional

Maintenance Agreement Required: [ ] Yes [X] No

[X] House/Mod. Home [ ] Mobile Home [ ] Business [ ] Other

No. Bedrooms 3 No. Bathrooms 3½ No. Employees _____


[ ] Slab [ ] Crawl Space [X] Basement w/plumbing [ ] Basement wo/plumbing

Water Supply: [X] Individual [ ] Public [ ] Community


Comments/Conditions: (1) Keep System 50 ft From pond (2) Install System on Contour (3) Install risers minimum 20" deep (4) Keep well 100' From System

Comments/Conditions: - Zabel Filter Installed - Septic risers Installed

INITIAL SITE SKETCH Not to Scale

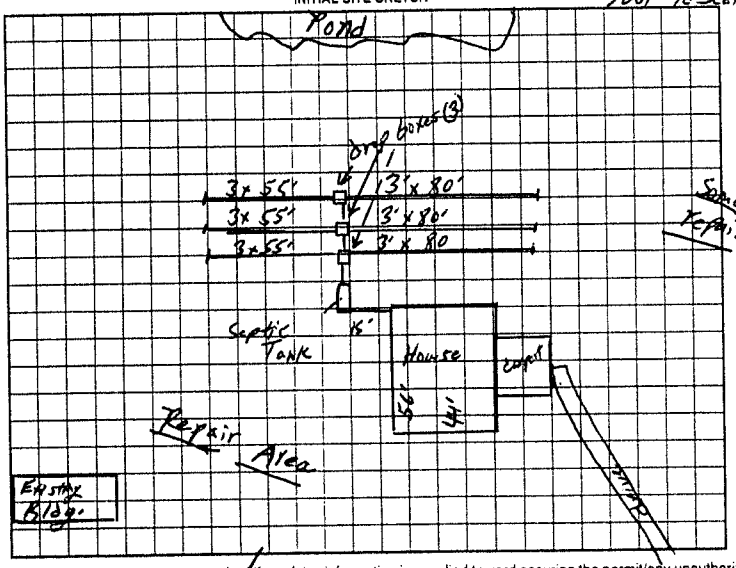

AS BUILT SKETCH

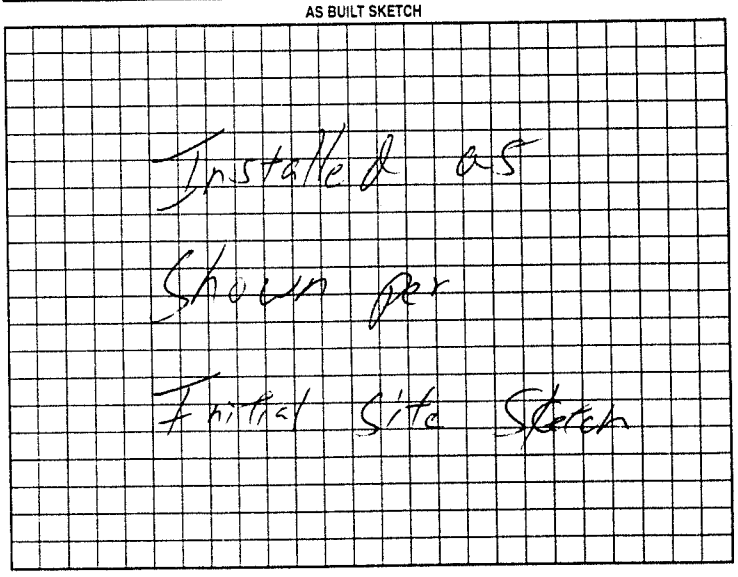

Permit can be suspended or revoked if any false information is supplied toward securing the permit/any unauthorized changes are made to the site/any unauthorized changes are made in the installation of the system. Improvement Permit with plat valid without expiration. Improvement Permit with site plan valid for sixty months. Authorization to Construct is valid for a period equal to that of Improvement Permit, not to exceed sixty months.

Signed: _____ date 7/17/01 Installed by: Donald Lakey

Improvement Permit by: William O. Johnson ROI date 7/9/01 Operation Permit by: William O. Johnson date 3/25/02

Authorization to Construct by: William O. Johnson date 7/9/01 Existing System Inspection by: _____ date _____

HEALTH DEPT. COPY WHITE OWNER COPY (FINAL) YELLOW OWNER COPY (INITIAL) PINK