IREDELL COUNTY HEALTH DEPARTMENT

STATESVILLE 704-878-5305 MOORESVILLE 704-664-5281

IMPROVEMENT PERMIT / AUTHORIZATION TO CONSTRUCT / OPERATION PERMIT / EXISTING SYSTEM INSPECTION

PERMIT# 079634 PIN# 4750 39 8732 Alt. / 4750494658 DATE 4/25/01

OWNER OR CONTRACTOR Alan Benson PHONE: Business Home 528-0025

ADDRESS 197 Arthurs Rd. Troutman, NC. 28166

LOCATION 115 N TR Oswalt Realty TR Arthurs Rd. to end straight down drive, TR last drive to house site

SUBDIVISION No BLOCK / SECTION LOT No LOT AREA 4.0 Ac SITE CLASS. AS DESIGN FLOW 360 L.T.A.R. .3

Septic Tank: 1000 Gallons; STB 1012 Date 3/3/01

Pump Tank: Gallons; PT Date

Pump Make: Model Serial No.

Nitrification Field: No Fields 1 Square Feet 1200 Linear Feet 400

No Lines 4@100' Trench Width 3' Max. Trench Bottom Depth 3' Gravel Depth 12"

[X] New System [ ] Repair System Type: I, II, III, IV, V, VI

System Description: GRAV - CONVENTIONAL

Repair System Description: SAME

Maintenance Agreement Required: [ ] Yes [X] No

[X] House/Mod. Home No. Bedrooms 3

[ ] Mobile Home No. Bathrooms 3

[ ] Business No. Employees

[ ] Other


[ ] Slab [X] Crawl Space [ ] Basement w/plumbing [ ] Basement wo/plumbing

Water Supply: [X] Individual [ ] Public [ ] Community

Comments:/Conditions:

Comments:/Conditions:

INITIAL SITE SKETCH

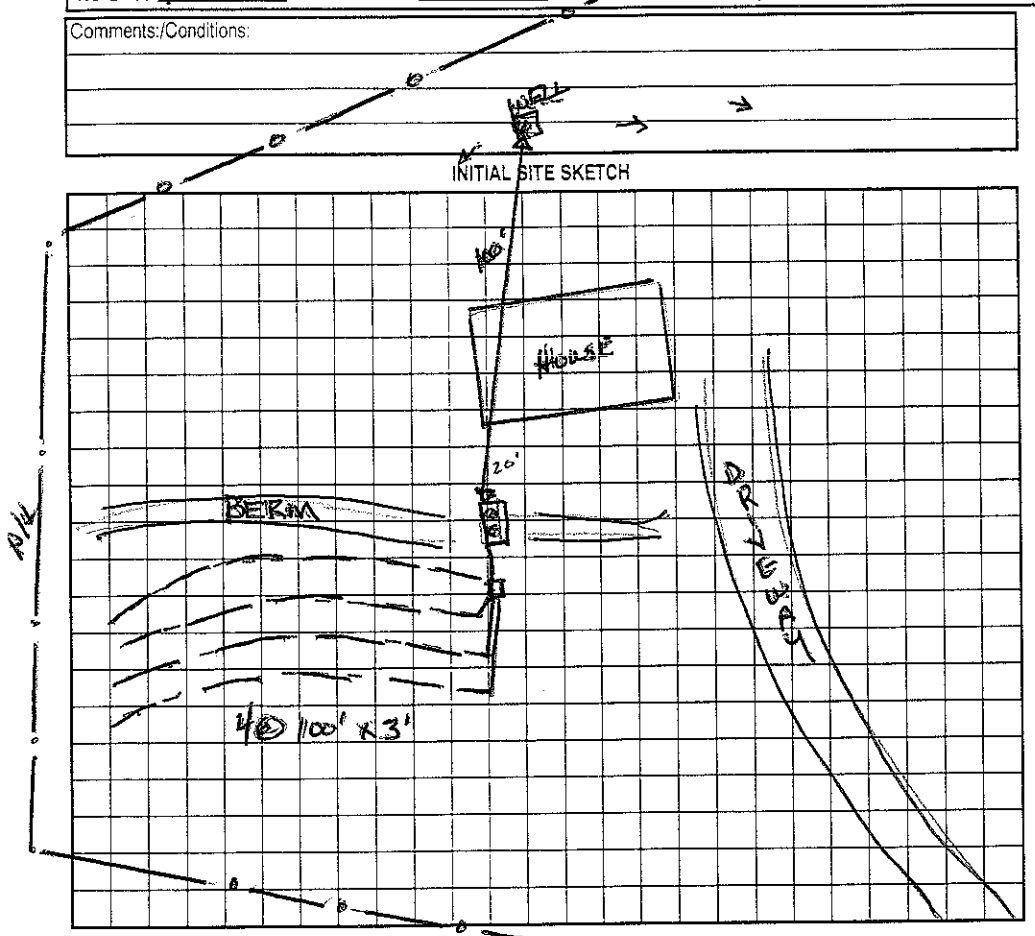

AS BUILT SKETCH

Permit can be suspended or revoked if any false information is supplied toward securing the permit/any unauthorized changes are made to the site/any unauthorized changes are made in the installation of the system. Improvement Permit with plat valid without expiration. Improvement Permit with site plan valid for sixty months. Authorization to Construct is valid for a period equal to that of Improvement Permit – not to exceed sixty months.

Signed: Angela Benson date 5/1/01

Improvement Permit by: Wesley Sparks RS. date 4/26/01

Authorization to Construct by: Wesley Sparks RS. date 4/26/01

Installed by: A-1 Backhoe

Operation Permit by: [signature] date 5/16/01

Existing System Inspection by: date

HEALTH DEPT. COPY: WHITE OWNER COPY (FINAL): YELLOW OWNER COPY (INITIAL): PINK