IREDELL COUNTY HEALTH DEPARTMENT

STATESVILLE 704-878-5305 MOORESVILLE 704-664-5281

IMPROVEMENT PERMIT / AUTHORIZATION TO CONSTRUCT / OPERATION PERMIT / EXISTING SYSTEM INSPECTION

PERMIT# 115292 PIN# ~~4750-39-43~~ 9T.001 4750 49 ~~8445~~ 7040 DATE 9/8/03

OWNER OR CONTRACTOR Mike Bowers PHONE: Business _____ Home 704-528-1065

ADDRESS 167 Bower Farm Ln Troutman NC 28166

LOCATION Oswalt Amity, TR Arthurs Rd, L on Benson Dr, on Lt

SUBDIVISION _____ BLOCK / SECTION _____ LOT _____ LOT AREA 1.5AC SITE CLASS. PS DESIGN FLOW 360 L.T.A.R. —

Septic Tank: Existing Gallons; STB _____ Date _____

Pump Tank: _____ Gallons; PT _____ Date _____

Pump Make: _____ Model _____ Serial No. _____

Nitrification Field: No Fields ____ Square Feet _____ Linear Feet ≈300'

No Lines 3 Trench Width _____ Max Trench Bottom Depth _____ Gravel Depth _____

☐ New System ☐ Repair System Type: I, (II), III, IV, V, VI

System Description: Existing Conventional

Repair System Description: _____

Maintenance Agreement Required: ☐ Yes ☒ No

☒ House/Mod. Home No. Bedrooms 3

☐ Mobile Home No. Bathrooms 3½

☐ Business No. Employees ____


☐ Other _____

☐ Slab ☒ Crawl Space ☐ Basement w/plumbing ☐ Basement wo/plumbing

Water Supply: ☒ Individual ☐ Public ☐ Community Existing

Comments:/Conditions: P/L

INITIAL SITE SKETCH

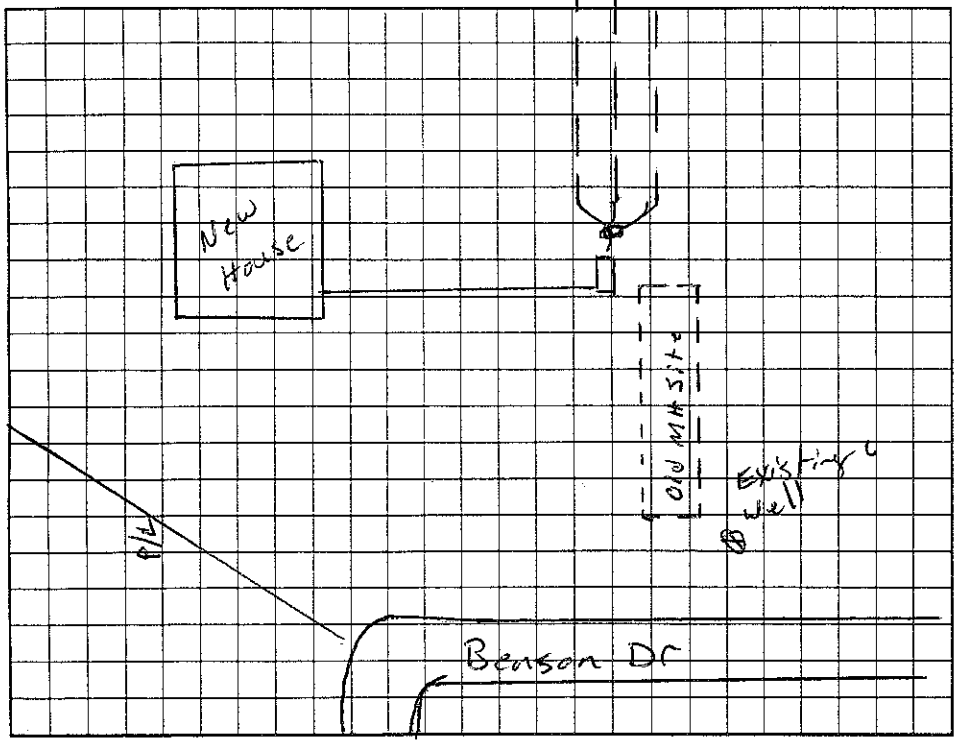

Comments:/Conditions:

Not to Scale AS BUILT SKETCH

Permit can be suspended or revoked if any false information is supplied toward securing the permit/any unauthorized changes are made to the site/any unauthorized changes are made in the installation of the system. Improvement Permit with plat valid without expiration. Improvement Permit with site plan valid for sixty months. Authorization to Construct is valid for a period equal to that of Improvement Permit – not to exceed sixty months.

Signed: James Mike Bowers date 9/8/03

Improvement Permit by: _____ date _____

Authorization to Construct by: _____ date _____

Installed by: _____

Operation Permit by: _____ date _____

Existing System Inspection by: RS date 9/8/03

HEALTH DEPT. COPY: WHITE OWNER COPY (FINAL): YELLOW OWNER COPY ~~(INITIAL)~~: PINK