IREDELL COUNTY HEALTH DEPARTMENT

STATESVILLE 704-878-5305 MOORESVILLE 704-664-5281

IMPROVEMENT PERMIT / AUTHORIZATION TO CONSTRUCT / OPERATION PERMIT / EXISTING SYSTEM INSPECTION

PERMIT# 106355 PIN# 4750 57 9744 DATE 6/6/02

OWNER OR CONTRACTOR Amy Money PHONE: Business Home 704-528-9712

ADDRESS 588 Lake Circle Trentman NC. 28166

LOCATION 115 N TR On Quinty TR Oversash TR Kendall, to end down drive to right hand drive

SUBDIVISION MILLER ESTATES BLOCK / SECTION LOT 2 LOT AREA 1.1 AC SITE CLASS PS DESIGN FLOW 360 L.T.A.R. .3

Septic Tank: 1000 Gallons; STB 794 Date 3/22/02
Pump Tank: Gallons; PT Date
Pump Make: Model Serial No.
Nitrification Field: No Fields 1 Square Feet 1200 Linear Feet 400
No Lines 5@80' Trench Width 3' Max Trench Bottom Depth 3' Gravel Depth 1'

☑ New System ☐ Repair System Type: I, (II), III, IV, V, VI
System Description: GRAVITY - CONVENTIONAL
Repair System Description: SAME
Maintenance Agreement Required: ☐ Yes ☒ No

☒ House/Mod. Home No. Bedrooms 3
☐ Mobile Home No. Bathrooms 3
☐ Business No. Employees
☐ Other
☐ Slab ☒ Crawl Space ☐ Basement w/plumbing ☐ Basement wo/plumbing


Water Supply: ☒ Individual ☐ Public ☐ Community

Comments:/Conditions:

Comments:/Conditions:

(1" = 60')

INITIAL SITE SKETCH

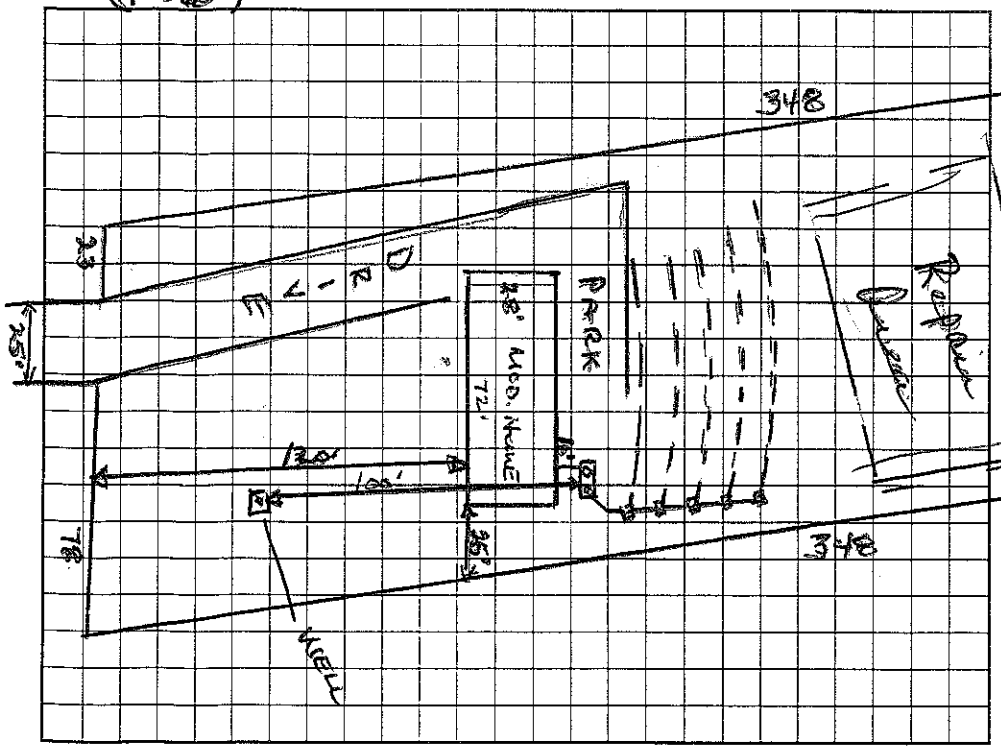

AS BUILT SKETCH

Installed as Drawn

Permit can be suspended or revoked if any false information is supplied toward securing the permit/any unauthorized changes are made to the site/any unauthorized changes are made in the installation of the system. Improvement Permit with plat valid without expiration. Improvement Permit with site plan valid for sixty months. Authorization to Construct is valid for a period equal to that of Improvement Permit – not to exceed sixty months.

Signed: Donna Miller date 6/7/2002 Installed by: Estel Elder

Improvement Permit by: Wesley Sparks R.S. date 6/6/02 Operation Permit by: [signature] R.S. date 7/15/02

Authorization to Construct by: Wesley Sparks R.S. date 6/6/02 Existing System Inspection by: date

HEALTH DEPT. COPY: WHITE OWNER COPY (FINAL): YELLOW OWNER COPY (INITIAL): PINK