IREDELL COUNTY HEALTH DEPARTMENT

STATESVILLE 704-878-5305 MOORESVILLE 704-664-5281

IMPROVEMENT PERMIT / AUTHORIZATION TO CONSTRUCT / OPERATION PERMIT / EXISTING SYSTEM INSPECTION

PERMIT# 076364 PIN# ~~4750 ~~58~~ 4750 58 0705~~ 4750 582935 DATE 9/10/98

OWNER OR CONTRACTOR Danny Stewart PHONE: Business _____ Home 528-9449

ADDRESS 1018 Charlotte Hwy Troutman, NC. 28166

LOCATION Oswalt Mill Rd. (E) TR Arthurs Rd. in forks of Tasmanian and Arthurs Rd. - 104 Tasmanian

SUBDIVISION _____ BLOCK / SECTION _____ LOT _____ LOT AREA _____ SITE CLASS. _____ DESIGN FLOW _____ L.T.A.R. _____

Septic Tank: EXIST. Gallons; STB _____ Date _____
Pump Tank: _____ Gallons; PT _____ Date _____
Pump Make: _____ Model _____ Serial No. _____
Nitrification Field: No Fields 1 Square Feet 300 Linear Feet 100
No Lines 1 Trench Width 36" Max Trench Bottom Depth 36" Gravel Depth 12"

☒ New System ☐ Repair System Type: I, (II), III, IV, V, VI
System Description: ADDITION OF 1 LINE REQ'D
Repair System Description: SAME
Maintenance Agreement Required: ☐ Yes ☒ No


☒ House/Mod. Home No. Bedrooms 3
☐ Mobile Home No. Bathrooms 2
☐ Business No. Employees _____
☐ Other _____
☐ Slab ☒ Crawl Space ☐ Basement w/plumbing ☐ Basement wo/plumbing

Water Supply: ☒ Individual ☐ Public ☐ Community

Comments:/Conditions:
BUILDING INSPECTION TO COLLECT REMAINING FEE AND INSPECTION FEE - HAS PAID $50.00 TO HD.

Comments:/Conditions:

INITIAL SITE SKETCH

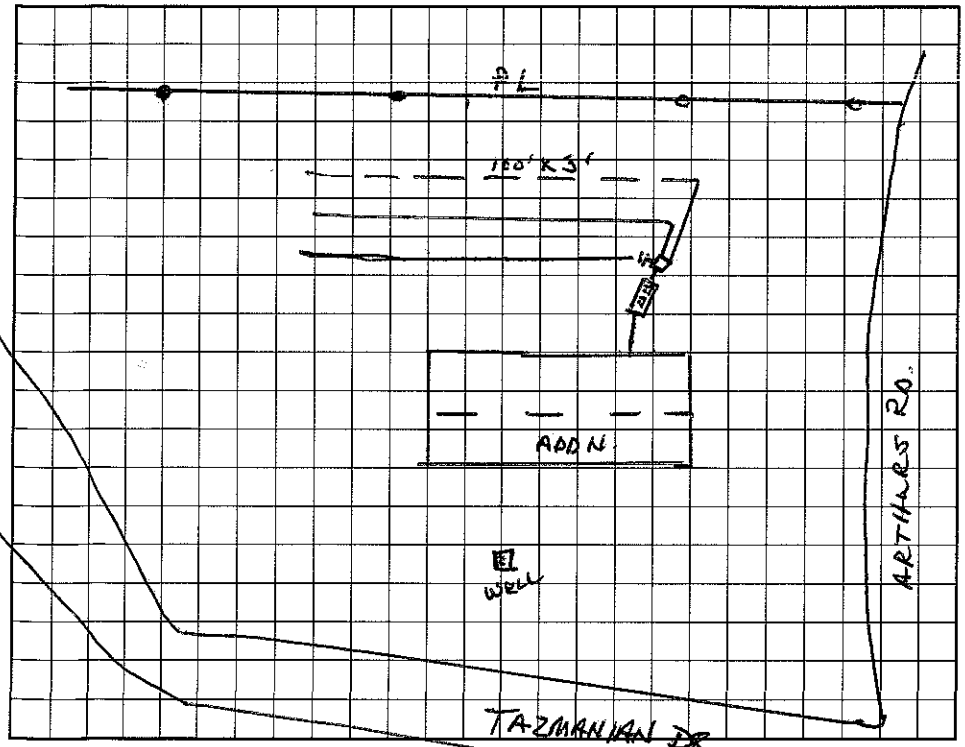

AS BUILT SKETCH

I understand that this permit can be suspended or revoked if any false information is supplied toward securing the permit/any unauthorized changes are made to the site/any unauthorized changes are made in the installation of the system. Improvement Permit with plat valid without expiration. Improvement Permit with site plan valid for sixty months. Authorization to Construct is valid for a period equal to that of Improvement Permit – not to exceed sixty months.

Signed: Danny W Stewart date 9/11/98
Improvement Permit by: Wesley Sparks RS. date 9/10/98
Authorization to Construct by: Wesley Sparks RS. date 9/10/98

Installed by: A1 BACKHOE
Operation Permit by: C date 9/18/98
Existing System Inspection by: _____ date _____

HEALTH DEPT. COPY: WHITE INSPECTION COPY (FINAL): GREEN OWNER COPY (FINAL): YELLOW INSPECTION COPY (INITIAL): PINK OWNER COPY (INITIAL): GOLD