IREDELL COUNTY HEALTH DEPARTMENT

Statesville Office (704) 878-5305 Mooresville Office (704) 660-3625 PERMIT # 216687

IMPROVEMENT PERMIT / AUTHORIZATION TO CONSTRUCT / OPERATION PERMIT / EXISTING SYSTEM

PIN # 4750-60-9600.000

APPLICANT: Superior Pools APPLICANT ADDRESS: 20315 Knox Rd.

SITE ADDRESS: 229 Mills Plantation Cir. Troutman NC PHONE: 704-896-7665 ALT. PHONE: 704-508-1243

SITE DIRECTIONS: Shinnville to W Feathers Creek, TL Houstal, TL Colonial Congress, TR Mills Plantation, 5th on R


SUBDIVISION: Georgia Mills Plantation SECTION: — LOT # 23 LOT AREA: 1.236 Acre DESIGN FLOW: Ex. 440 GPD L.T.A.R.: Existing

Septic Tank	Existing (gal)	STB		Date		☐ New System ☐ Repair ☐ Expansion	System Type: I II III (IV) V VI	☒ Residence	No. Bedrooms Ex. 4
Pump Tank	Existing (gal)	PT		Date		System Description:	Existing RP-PRBDS	☐ Business	No. Persons Ex 8
Pump Make	Ex.	Model		Serial #		Repair System Description:	Offsite LPPRBDS	☐ Other	No. Employees
# Nitrification Fields	Ex	# Lines	Ex	Linear Ft:	Ex.	Maintenance Agreement Required:	☒ YES ☐ NO	☒ Slab	☐ Crawl Space
Trench Width	Ex.	Max. Trench Bottom Depth	Ex.	Gravel Depth	Ex. (N/A)	☐ GRAVITY	☒ PRESSURE	☐ Basement w/plumbing	☐ Basement w/o plumbing


Water Supply: ☒ Private ☐ Public ☐ Community

Comments / Conditions: Existing System Appeared To Be Functioning @ Time Of Inspection. Maintain 15' Separation w/ Pool From Existing Septic.

INITIAL SITE SKETCH

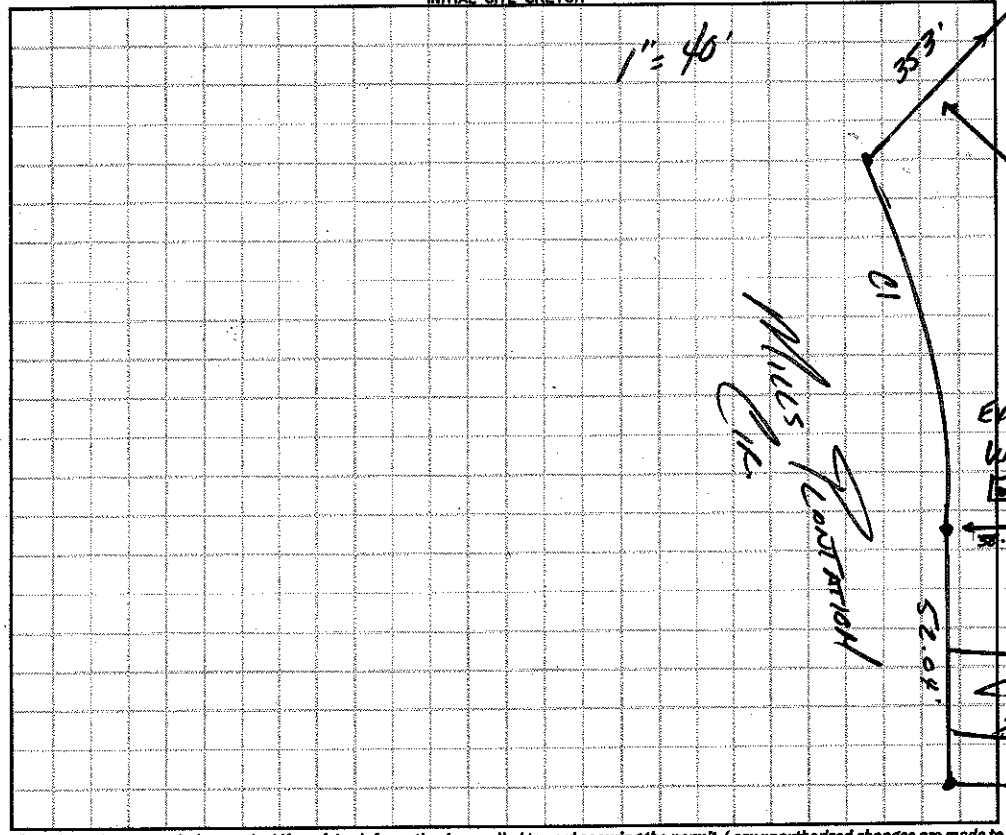

AS BUILT SKETCH

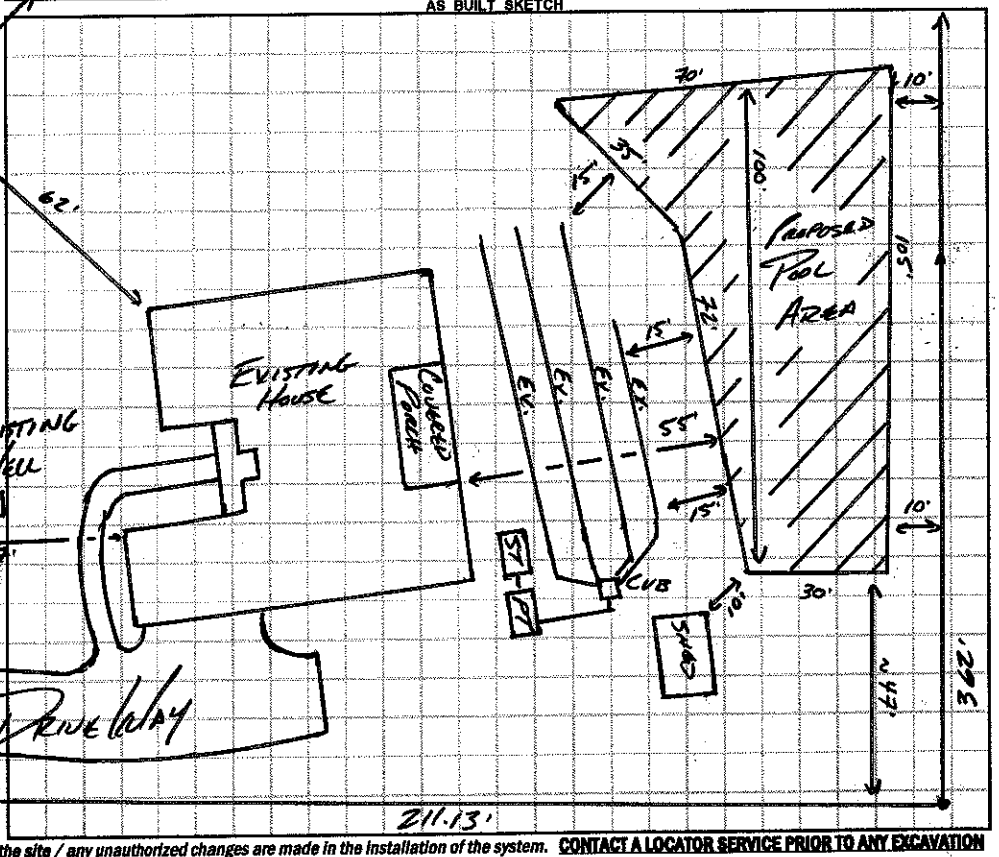

Permit can be suspended or revoked if any false information is supplied toward securing the permit / any unauthorized changes are made to the site / any unauthorized changes are made in the installation of the system. **CONTACT A LOCATOR SERVICE PRIOR TO ANY EXCAVATION**

☐ **IMPROVEMENT PERMIT** *with plat valid without expiration.* ☐ **IMPROVEMENT PERMIT** *with site plan valid for 60 mos.* ☐ **AUTHORIZATION TO CONSTRUCT** *valid for period equal to IMPROVEMENT PERMIT--not to exceed 60 mo.*

Owner / Applicant Signature: E Shaw Date: 3-17-16 Installed by:

IMPROVEMENT PERMIT by: Date: OPERATION PERMIT by: Date:

AUTHORIZATION TO CONSTRUCT by: Date: Existing System Inspected by:

APPROVED MAR 15 2016

Health Dept. Copy - WHITE Applicant (Final Approval) - YELLOW Applicant (Conditional Approval) - PINK