IREDELL COUNTY HEALTH DEPARTMENT

STATESVILLE 704-878-5305 MOORESVILLE 704-664-5281

IMPROVEMENT PERMIT / AUTHORIZATION TO CONSTRUCT / OPERATION PERMIT / EXISTING SYSTEM INSPECTION

PERMIT# 146718 PIN# 4750629130 DATE 12-20-07

OWNER OR APPLICANT Adams Homes PHONE: Business 704-202-1524 Home

ADDRESS 132 Joe V Knox Ave Suite 102 Mooresville NC 28117

LOCATION Hwy 115 N TR Shepherd TL Houston on left

SUBDIVISION Georgia Mills BLOCK / SECTION LOT 1 LOT AREA SITE CLASS. PS DESIGN FLOW 480gpd L.T.A.R. .225 gpd/ft²

Septic Tank: 1000 Gallons; STB 825 Date 8-1-10

Pump Tank: Gallons; PT Date

Pump Make: Model Serial No.

Nitrification Field: No Fields 1 Square Feet 1605 Linear Feet 535'

No Lines 5 Trench Width 36" Max Trench Bottom Depth 36"

☒ New System ☐ Repair ☐ Expansion System Type: I II III IV V VI

System Description: 25% reduction gravity

Repair System Description: LP PPBPS

Maintenance Agreement Required: ☐ Yes ☒ No

☒ House/Mod. Home ☐ Mobile Home ☐ Business ☐ Other

No. Bedrooms 4 No. Persons 8 No. Employees


Water Supply: ☒ Individual ☐ Public ☐ Community

Gravel Depth N/A ☒ Gravity ☐ Pressure ☐ Slab ☒ Crawl Space ☐ Basement w/plumbing ☐ Basement wo/plumbing


Comments:/Conditions: Well 100' from system

Comments:/Conditions: CHAMBERS LINES 1-5 / 19, 24, 28, 32, 30

INITIAL SITE SKETCH

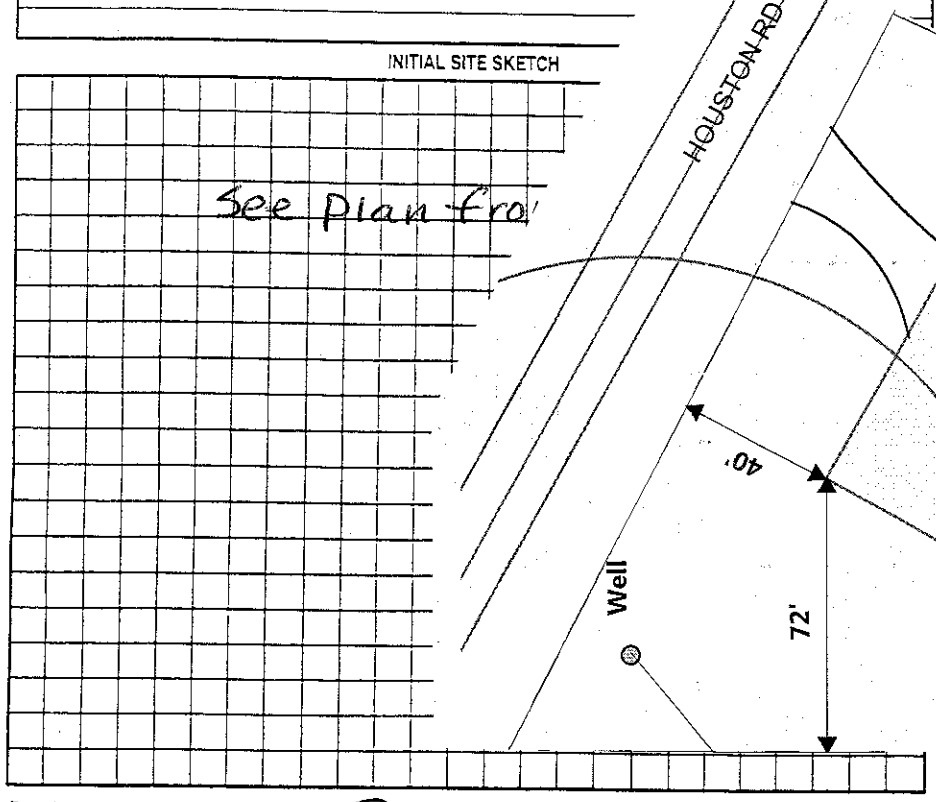

AS BUILT SKETCH

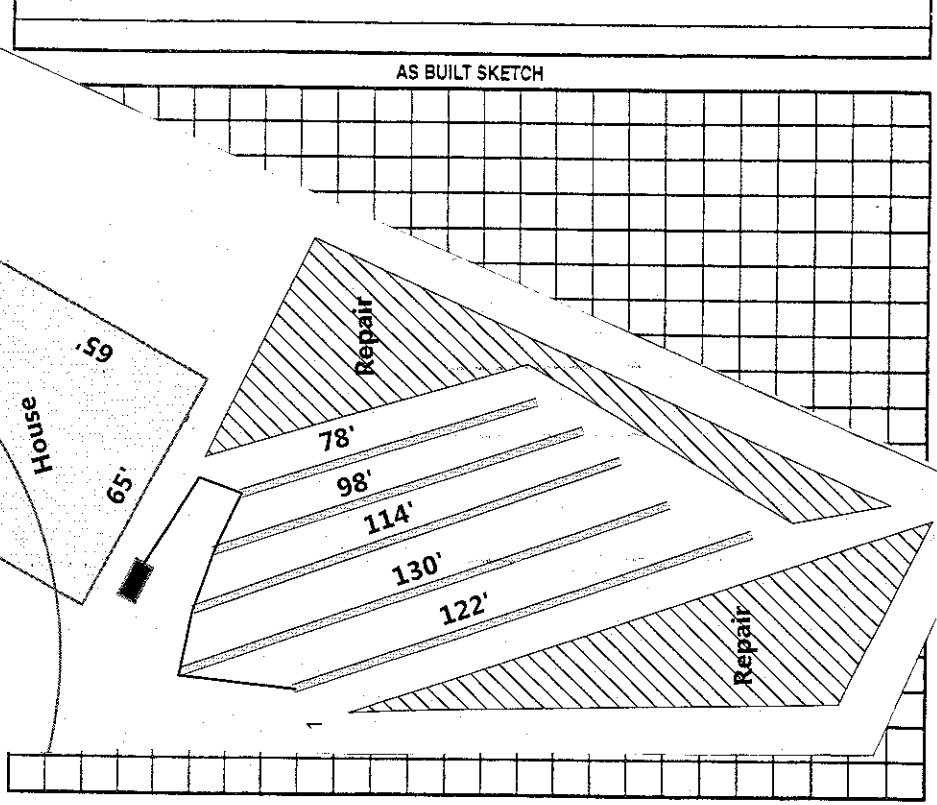

Permit can be suspended or revoked if any false information is supplied toward securing the permit/any unauthorized changes are made to the site/any unauthorized changes are made in the installation of the system. Improvement Permit with plat valid without expiration ☐ Improvement Permit with site plan valid for sixty months ☒ Authorization to Construct is valid for a period equal to that of Improvement Permit – not to exceed sixty months.

Signed: date

Improvement Permit by: Jeffrey Mitchell date 12-20-07

Authorization to Construct by: REHS date 7-7-10

Installed by: Rowan

Operation Permit by: REHS date 9-15-10

Existing System Inspection by: date

HEALTH DEPT. COPY: WHITE OWNER COPY (FINAL): YELLOW OWNER COPY (INITIAL): PINK