IREDELL COUNTY HEALTH DEPARTMENT

STATESVILLE 704-878-5305 4750 670602 MOORESVILLE 704-664-5281

IMPROVEMENT PERMIT / CERTIFICATE OF COMPLETION / OPERATION PERMIT / EXISTING SYSTEM INSPECTION

PROPERTY DESCRIPTION NO. 19136 DATE 10/21/94 TAX MAP NO. Pt of 46 B 33 Watershed: ☐ Yes ☒ No

OWNER OR CONTRACTOR Luchie L Miller PHONE: Business _____ Home 525-4657

ADDRESS Rt 1 Box 495 Troutman, NC 28166

LOCATION Kendall Rd. - On Curve TR Overleaf TR Kendall Rd. TR on drive off culde sac first lot on (L)

SUBDIVISION Miller Estates BLOCK / SECTION 1 LOT 1 LOT AREA 1.17AC SITE CLASS. P DESIGN FLOW 360 L.T.A.R. .35

Septic Tank: 1000 Gallons; STB # 794 Date 9-27-94

Pump Tank: _____ Gallons; PT _____ Date _____

Pump Make: _____ Model _____ Serial No. _____

Nitrification Field: No Fields 1 Square Feet 1028 Linear Feet 342

No Lines 4 Trench Width 36" Max Trench Bottom Depth 34" Gravel Depth 12"

☑ New System ☐ Repair System Type: I, ☒ II, III, IV, V, VI

System Description: GRAVITY CONV.

Repair System Description: SAME

Maintenance Agreement Required: ☐ Yes ☒ No

☐ House/Mod. Home ☑ Mobile Home ☐ Business ☐ Other


No. Bedrooms 3 No. Bathrooms 2 No. Employees ____

☐ Slab ☑ Crawl Space ☐ Basement w/plumbing ☐ Basement wo/plumbing

Water Supply: ☑ Individual ☐ Community ☐ Public

Comments: Well to be located toward Lot 2 and above possible house location

INITIAL SITE SKETCH

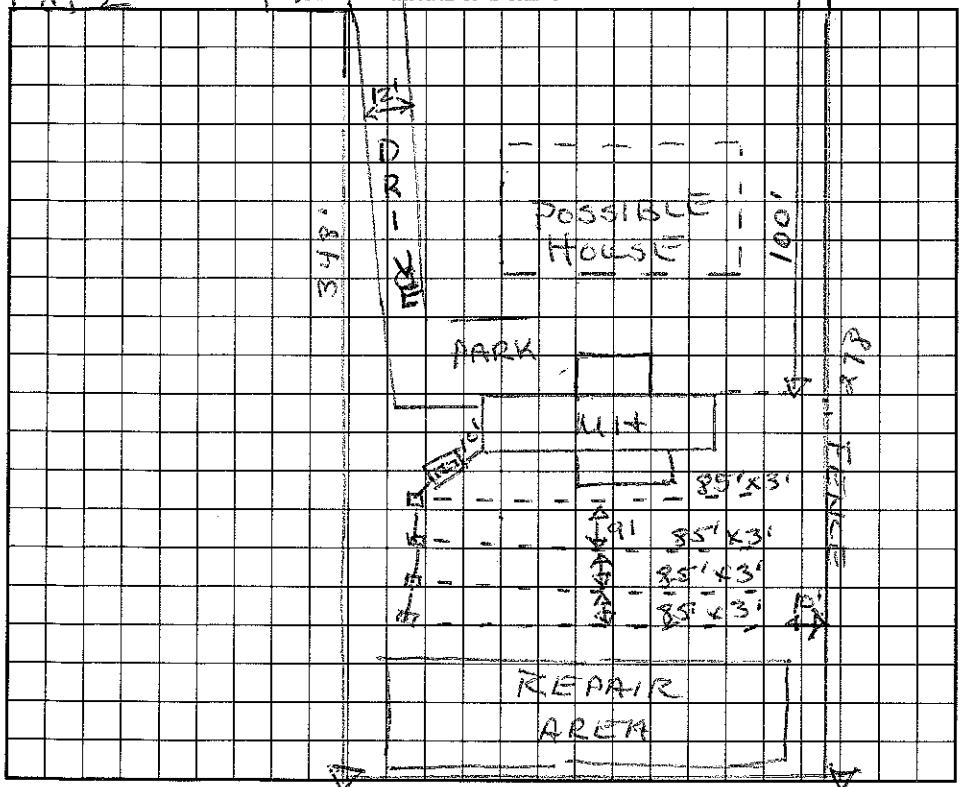

Comments: Installed essentially as drawn.

AS BUILT SKETCH

I understand that this permit can be suspended or revoked if any false information is supplied toward securing the permit/any unauthorized changes are made to the site/any unauthorized changes are made in the installation of the system. Improvement Permit is valid for 60 months from date of issuance.

Signed: Glenda J. Miller

Improvement Permit by: Wesley Sparks, RS. date 10/21/94

Existing System Inspection by: _____ date _____

Installed by: Dennis Walker

Certificate of Completion by: Wesley Sparks RS. date 11/15/94

Operation Permit by: _____ date _____

HEALTH DEPT. COPY: WHITE INSPECTION COPY (FINAL): GREEN OWNER COPY (FINAL): YELLOW INSPECTION COPY (INITIAL): PINK OWNER COPY (INITIAL): GOLD