IREDELL COUNTY HEALTH DEPARTMENT

STATESVILLE 704-878-5305 MOORESVILLE 704-664-5281 4.00

IMPROVEMENT PERMIT / CERTIFICATE OF COMPLETION / OPERATION PERMIT / EXISTING SYSTEM INSPECTION

PROPERTY DESCRIPTION NO. 17694 DATE 1/18/94 TAX MAP NO. 46-3-A-12

OWNER OR CONTRACTOR RICKY FORD Watershed: ☐ Yes ☑ No

ADDRESS PO BOX 861 TROUTMAN, NC. 28166 ~~PHONE: Business~~ 4750-69-9343 Home 528-3187

LOCATION KENDALL RD OFF OVERCASH RD. TO THE 3RD LOT ON (R)

SUBDIVISION KENDALWOOD BLOCK / SECTION ______ LOT 12 LOT AREA ______ SITE CLASS. P DESIGN FLOW 360 L.T.A.R. .25-.3

Septic Tank: 1000 Gallons; STB 358 Date 12/11/93

Pump Tank: ______ Gallons; PT ______ Date ______

Pump Make: ______ Model ______ Serial No. ______

Nitrification Field: No Fields 1 Square Feet 1200 Linear Feet 400

No Lines 4 Trench Width 3' Max Trench Bottom Depth 30" Gravel Depth 12"

☑ New System ☐ Repair System Type: I (II) III, IV, V, VI

System Description: CONV.

Repair System Description: PANEL

Maintenance Agreement Required: ☐ Yes ☐ No

☑ House/Mod. Home ☐ Mobile Home ☐ Business ☐ Other ______

No. Bedrooms 3 No. Bathrooms 2 No. Employees ______


Water Supply: ☑ Individual ☐ Community ☐ Public

☐ Slab ☑ Crawl Space ☐ Basement w/plumbing ☐ Basement wo/plumbing


Comments: KEEP TRENCHES SHALLOW, NO DEEPER THAN 30" TO TRENCH BOTTOM.

Comments:

INITIAL SITE SKETCH

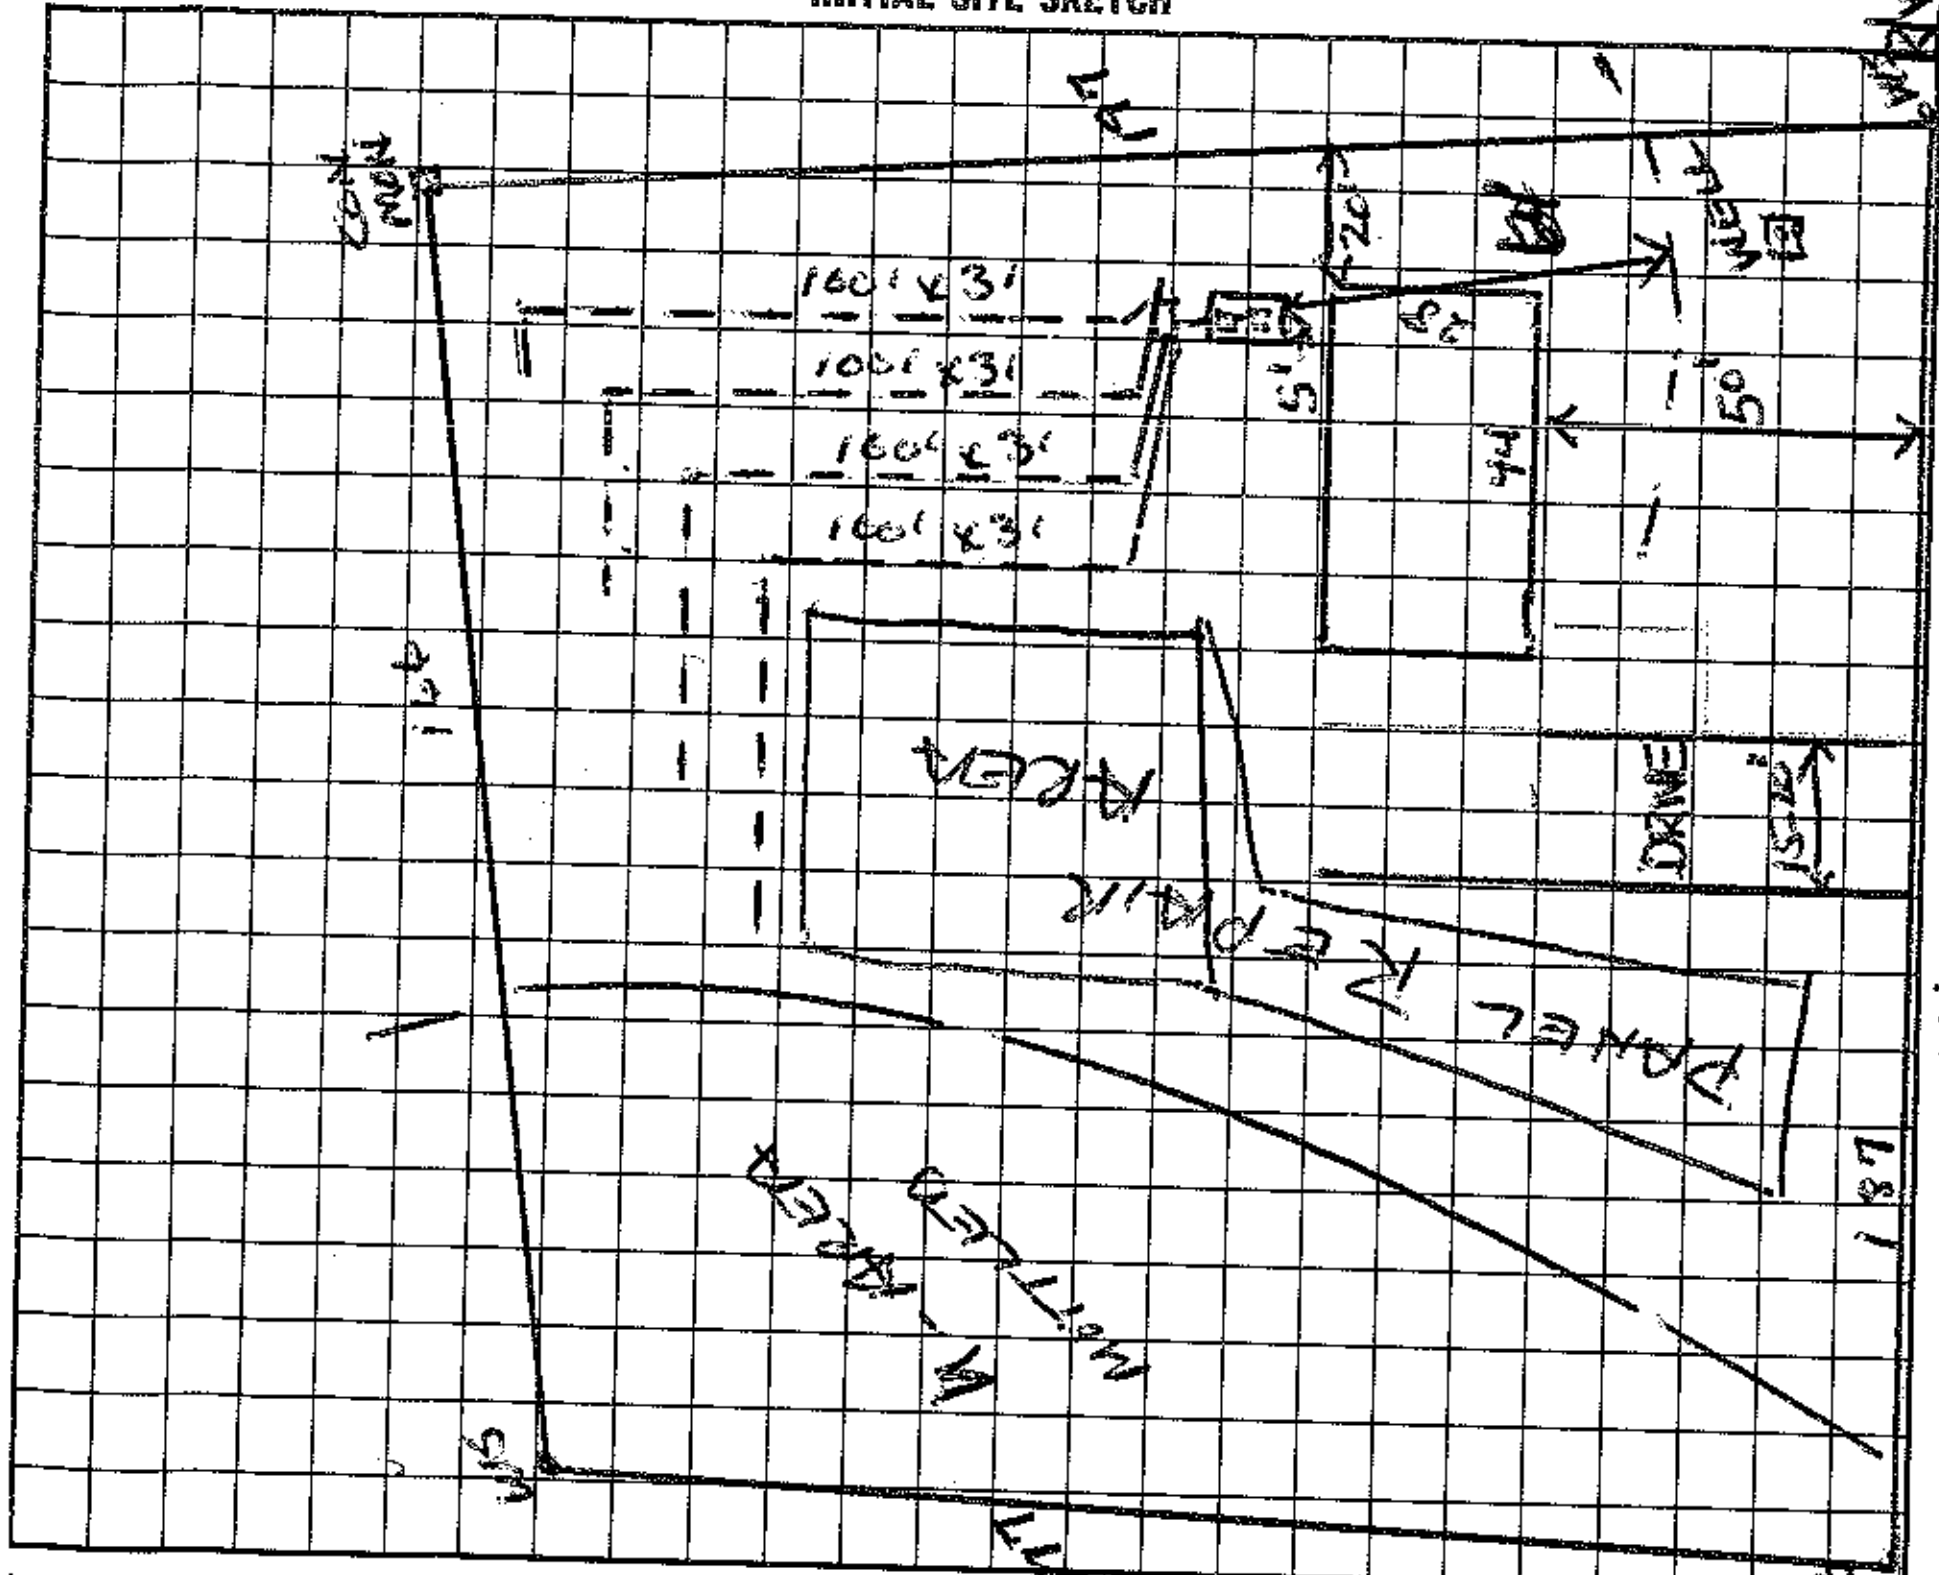

AS BUILT SKETCH

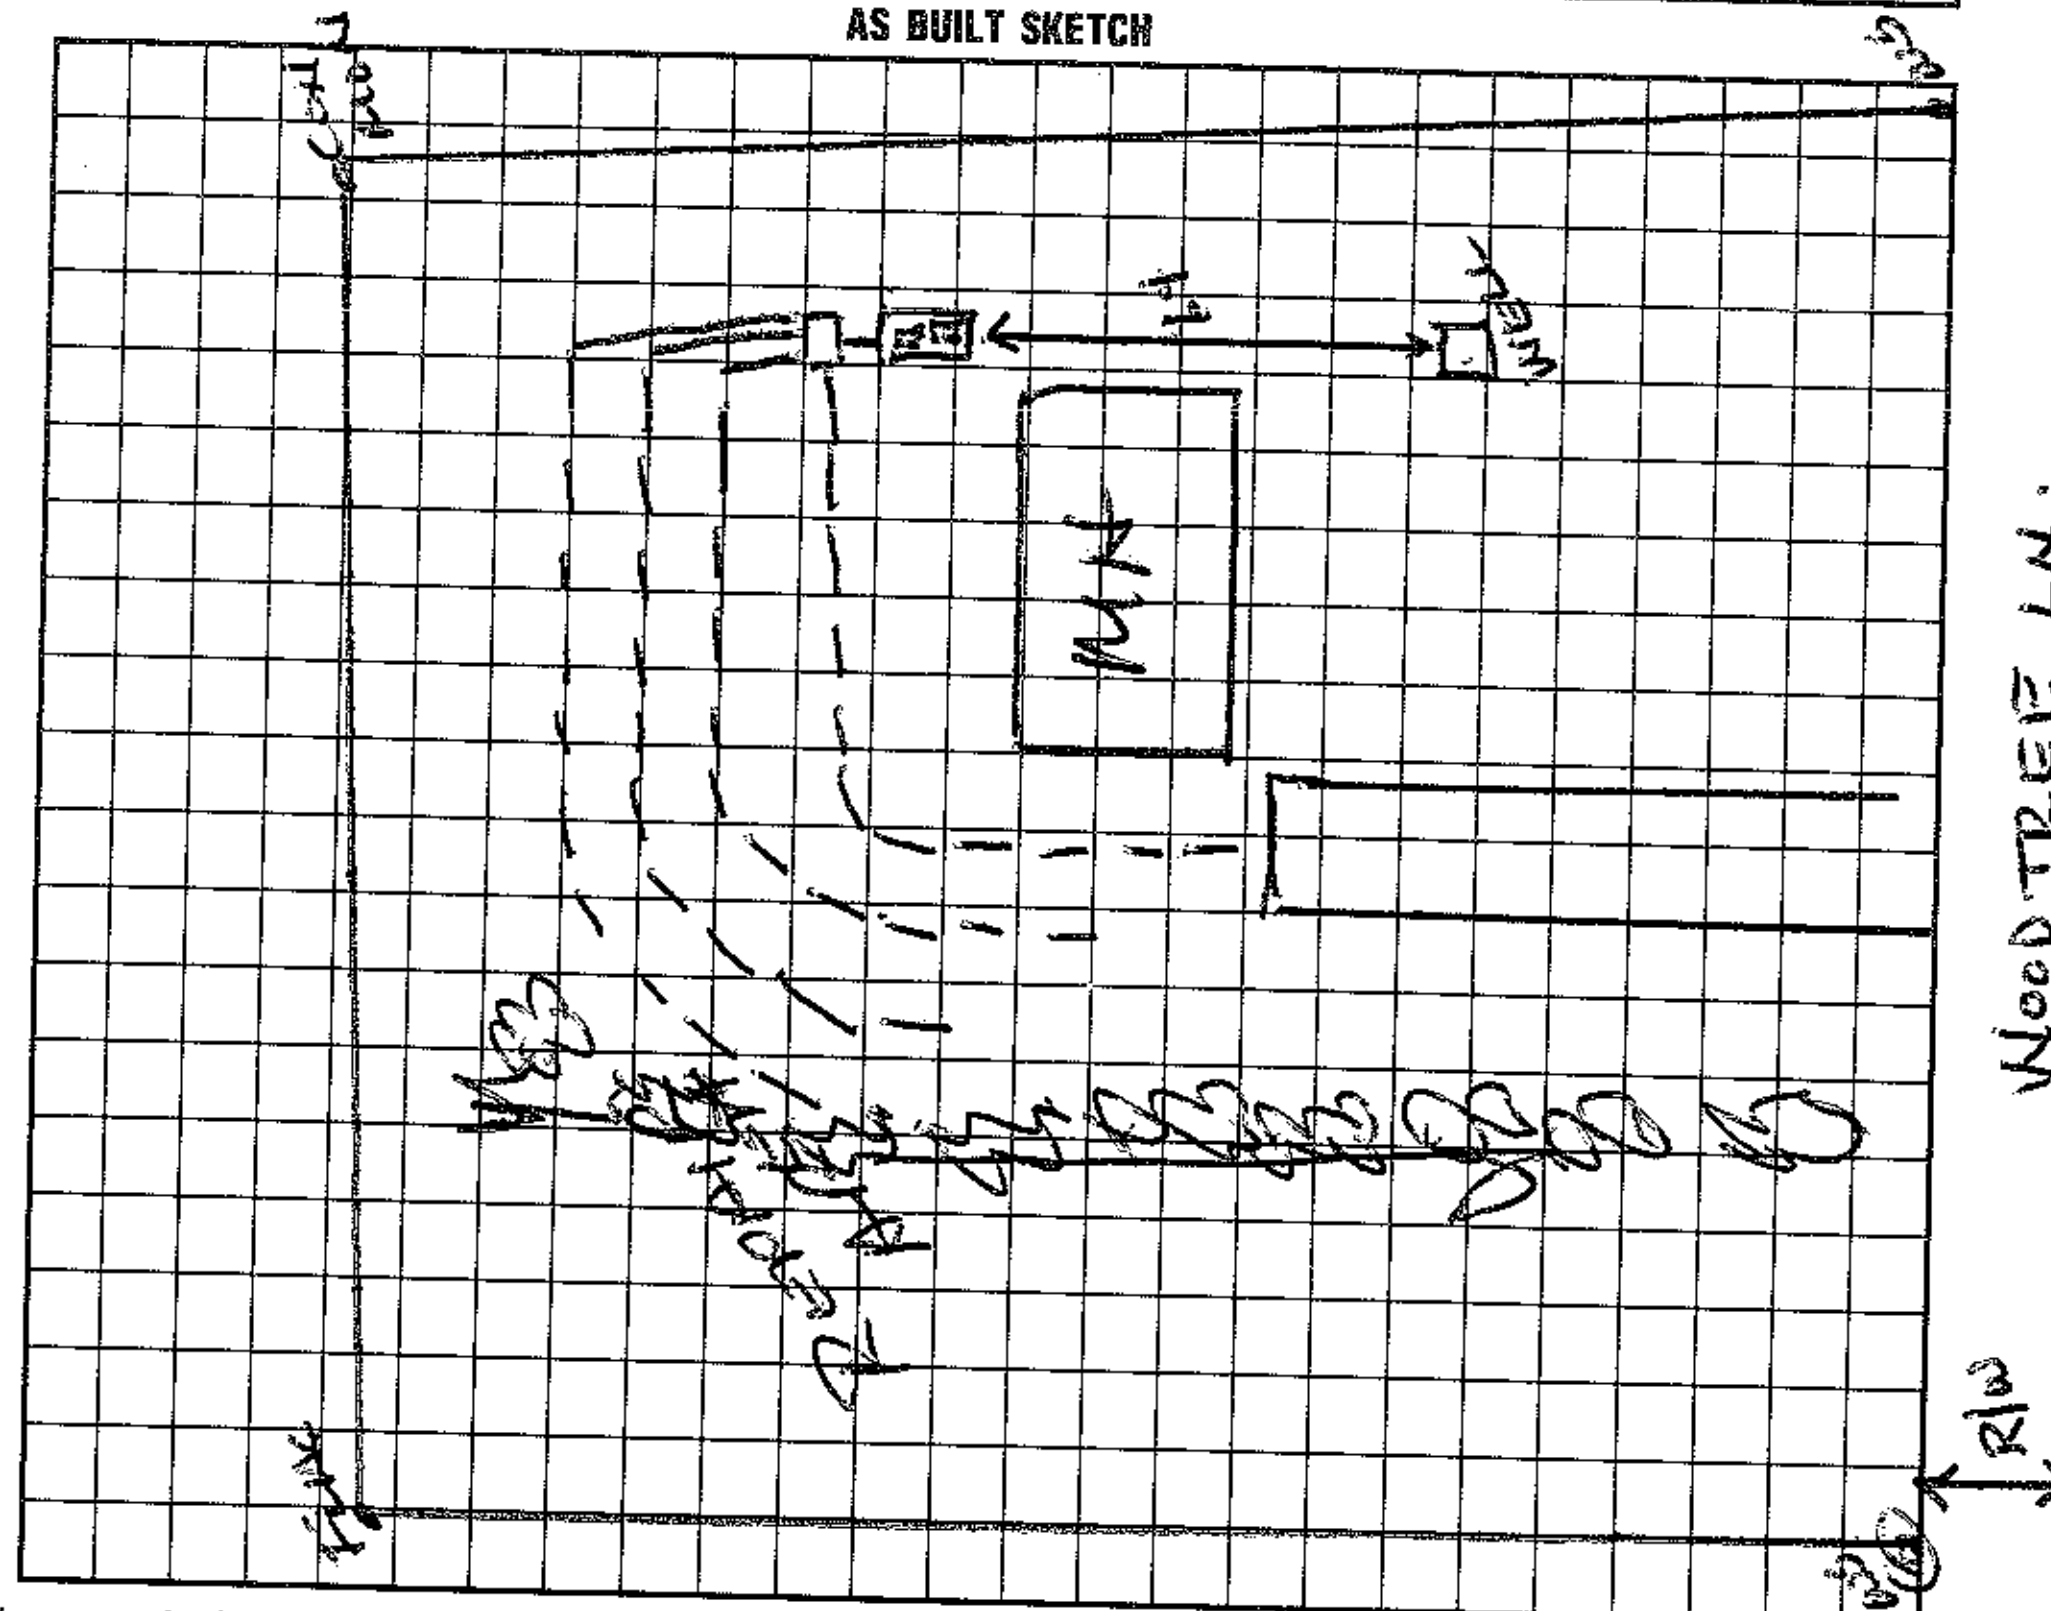

I understand that this permit can be suspended or revoked if any false information is supplied toward securing the permit/any unauthorized changes are made to the site/any unauthorized changes are made in the installation of the system. Improvement Permit is valid for 60 months from date of issuance.

Signed: JoCarol Ford

Improvement Permit by: Wesley Sparks RS. date 1/18/94

Existing System Inspection by: ______ date ______

Installed by: A-1 Backhoe

Certificate of Completion by: Wesley Sparks RS date 2/22/94

Operation Permit by: ______ date ______

HEALTH DEPT. COPY: WHITE INSPECTION COPY (FINAL): GREEN OWNER COPY (FINAL): YELLOW INSPECTION COPY (INITIAL): PINK OWNER COPY (INITIAL): GOLD