IREDELL COUNTY HEALTH DEPARTMENT

Statesville Office (704) 878-5305 Mooresville Office (704) 660-3625 PERMIT # 20150

IMPROVEMENT PERMIT / AUTHORIZATION TO CONSTRUCT / OPERATION PERMIT / EXISTING SYSTEM

PIN # 4750699690

APPLICANT: David Close APPLICANT ADDRESS: 110 Kendall Rd Troutman NC 28166

SITE ADDRESS: 110 Kendall Rd Troutman NC 28166 PHONE: 704-528-5516 ALT. PHONE: N/A

SITE DIRECTIONS: Amity Hill Rd to Oswalt Mill Rd on Overcash Rd to Kendall

SUBDIVISION: N/A SECTION: N/A LOT # N/A LOT AREA: 4 acres DESIGN FLOW: 360 L.T.A.R.: 0.3

Septic Tank 1000 (gal) STB 825 Date 2-3-14

Pump Tank (gal) PT Date

Pump Make Model Serial #

Nitrification Fields 1 # Lines 4 Linear Ft: 270

Trench Width 36" Max. Trench Bottom Depth 36" Gravel Depth N/A

☐ New System ☑ Repair ☐ Expansion System Type: I II III IV V VI

System Description: 25% Reduction

Repair System Description: N/A

Maintenance Agreement Required: ☐ YES ☒ NO

☑ GRAVITY ☐ PRESSURE


☒ Residence ☐ Business ☐ Other ☐ Slab ☒ Crawl Space ☐ Basement w/plumbing ☐ Basement w/o plumbing

No. Bedrooms 3 No. Persons 6 No. Employees


Water Supply: ☒ Private ☐ Public ☐ Community


INITIAL SITE SKETCH

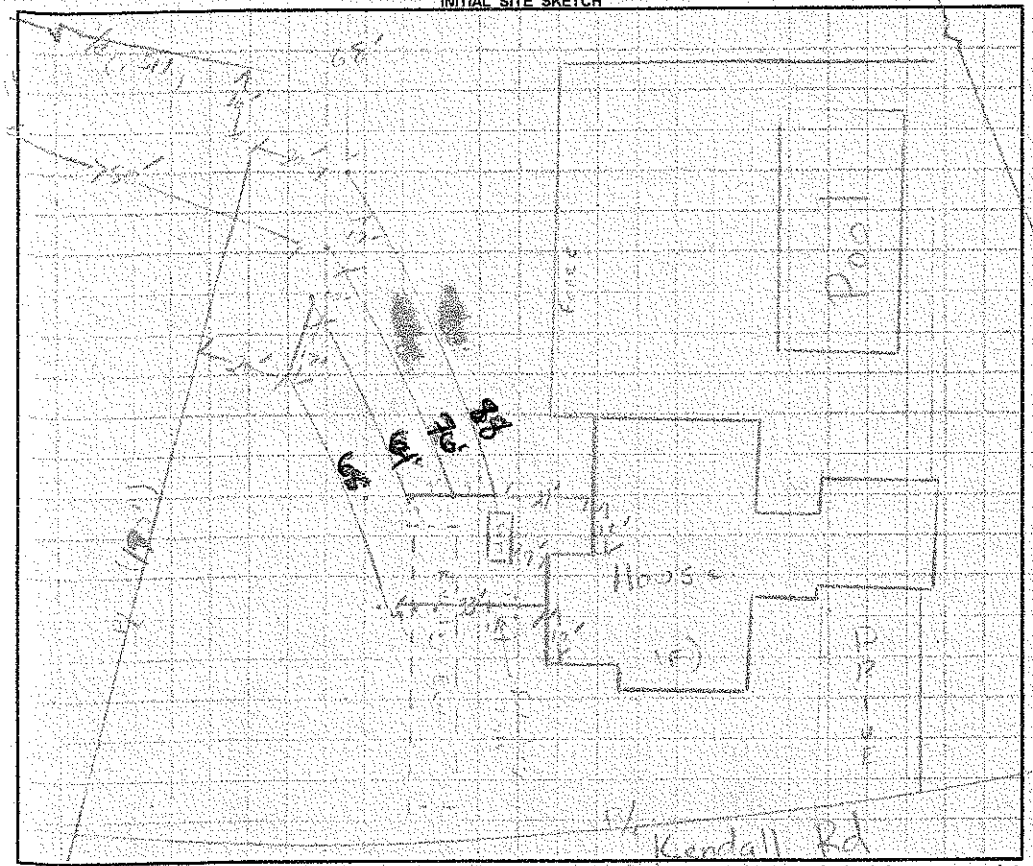

AS BUILT SKETCH

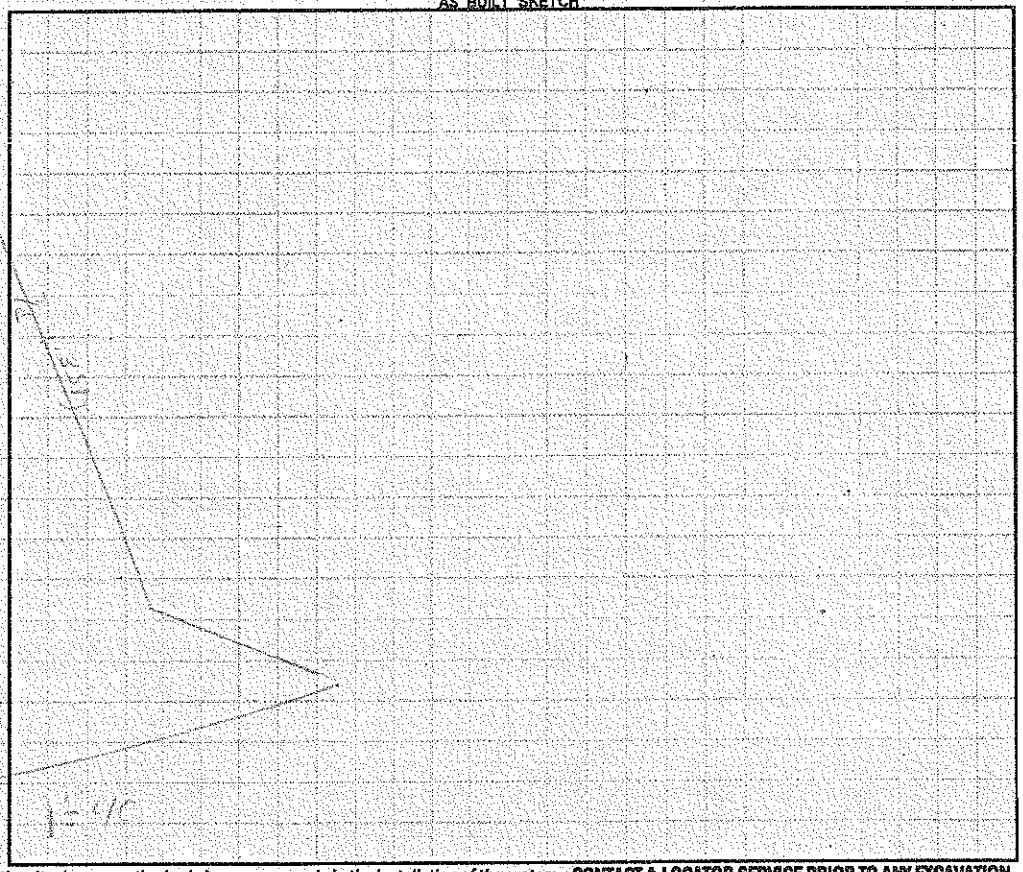

Permit can be suspended or revoked if any false information is supplied toward securing the permit / any unauthorized changes are made to the site / any unauthorized changes are made in the installation of the system. **CONTACT A LOCATOR SERVICE PRIOR TO ANY EXCAVATION**

☐ **IMPROVEMENT PERMIT** *with plat valid without expiration.* ☑ **IMPROVEMENT PERMIT** *with site plan valid for 60 mos.* ☒ **AUTHORIZATION TO CONSTRUCT** *valid for period equal to IMPROVEMENT PERMIT--not to exceed 60 mo.*

Applicant Signature: Date: 3/3/14 Installed by: Rowan Septic

IT PERMIT by: Date: 03/03/14 OPERATION PERMIT by: APPROVED APR 22 2014 Date:

AUTHORIZATION TO CONSTRUCT by: Date: 03/03/14 Existing System Inspected by: Date:

Health Dept. Copy - WHITE Applicant (Final Approval) - YELLOW Applicant (Conditional Approval) - PINK