IREDELL COUNTY HEALTH DEPARTMENT

Statesville Office (704) 878-5305 Mooresville Office (704) 660-3625 PERMIT # 211286

IMPROVEMENT PERMIT / AUTHORIZATION TO CONSTRUCT / OPERATION PERMIT / EXISTING SYSTEM

PIN # 4750-70-4377.000

APPLICANT: Superior Pools APPLICANT ADDRESS: 20315 Knox Rd. Cornelius NC 28031

SITE ADDRESS: 205 Mills Plantation Cir. Mooresville NC PHONE: 704-991-3390 ALT. PHONE: 704-896-7665

SITE DIRECTIONS: 115, R Sheppards Rd., R Houston, R Colonial Congress, L Mills Plantation, on L

SUBDIVISION: Georgia Mills SECTION: LOT # 28 LOT AREA: .79 Acre DESIGN FLOW: Ex. 450 GPD L.T.A.R.: Existing

Septic Tank Existing (gal) STB Date
Pump Tank Existing (gal) PT Date
Pump Make Ex. Model Serial #
Nitrification Fields Ex. # Lines 6s Linear Ft: Ex.
Trench Width Ex. Max. Trench Bottom Depth Ex. Gravel Depth Ex.


☐ New System ☐ Repair ☐ Expansion System Type: I II III (IV) V VI
System Description: Existing LP-PPBPS
Repair System Description:
Maintenance Agreement Required: ☒ YES ☐ NO
☐ GRAVITY ☒ PRESSURE

☒ Residence No. Bedrooms Ex 4
☐ Business No. Persons Ex 8
☐ Other No. Employees
☐ Slab ☒ Crawl Space
☐ Basement w/plumbing ☐ Basement w/o plumbing


Water Supply: ☒ Private ☐ Public ☐ Community

Comments / Conditions: System Appeared To Be Functioning @ Time Of Inspection.

INITIAL SITE SKETCH

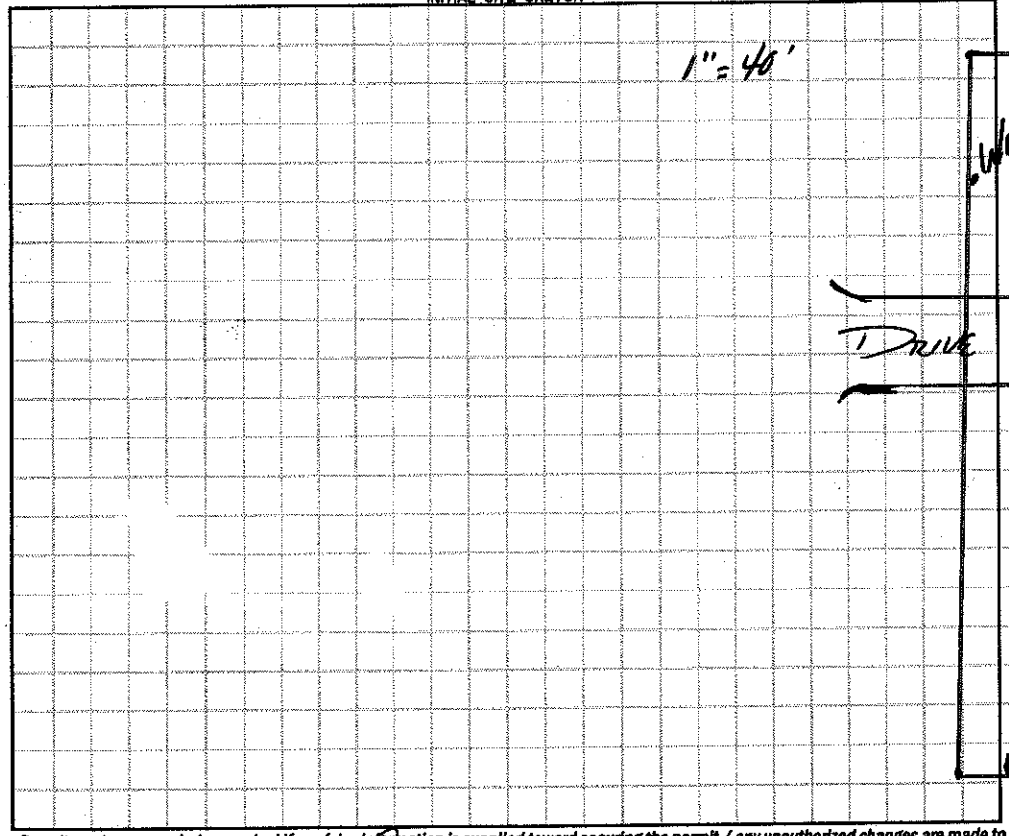

AS BUILT SKETCH

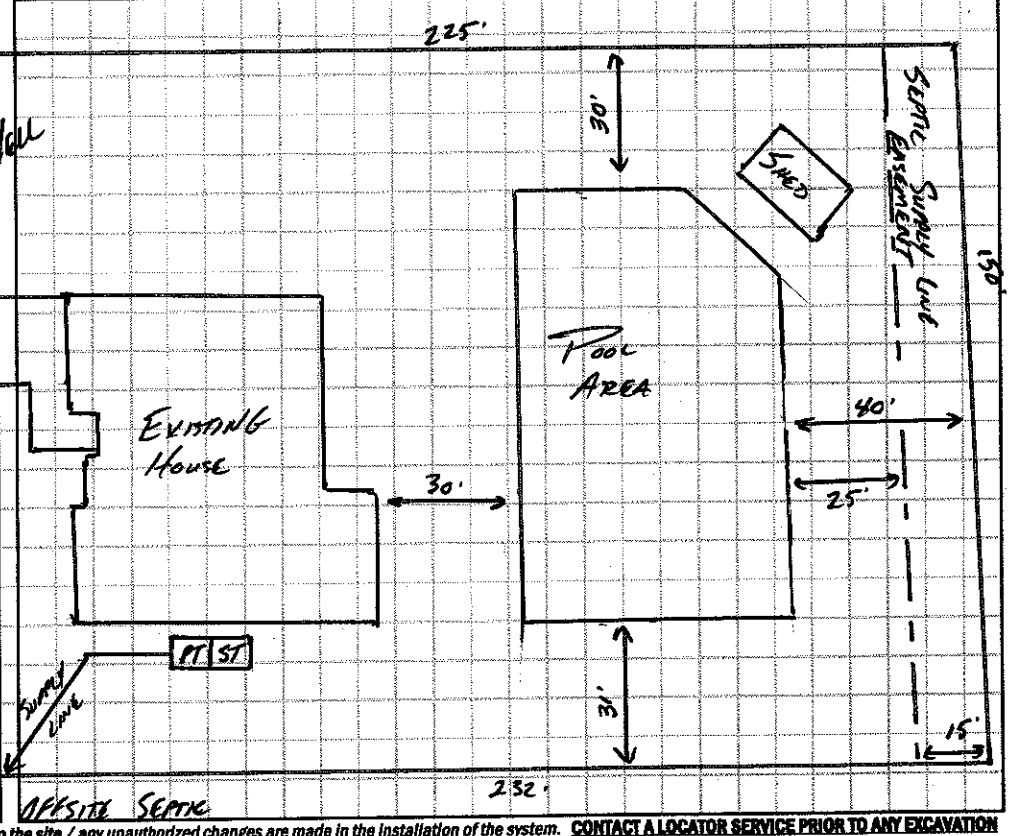

Permit can be suspended or revoked if any false information is supplied toward securing the permit / any unauthorized changes are made to the site / any unauthorized changes are made in the installation of the system. **CONTACT A LOCATOR SERVICE PRIOR TO ANY EXCAVATION**

☐ **IMPROVEMENT PERMIT** *with plat valid without expiration.* ☐ **IMPROVEMENT PERMIT** *with site plan valid for 60 mos.* ☐ **AUTHORIZATION TO CONSTRUCT** *valid for period equal to IMPROVEMENT PERMIT--not to exceed 60 mo.*

Owner / Applicant Signature: Date: 7-22-15 Installed by:

IMPROVEMENT PERMIT by: Date: OPERATION PERMIT by: Date:

AUTHORIZATION TO CONSTRUCT by: Date: Existing System Inspected by: Date: APPROVED JUN 26 2015

Health Dept. Copy - WHITE Applicant (Final Approval) - YELLOW Applicant (Conditional Approval) - PINK