Site Address: 111 Kings Mountain Court - Iredell,

IREDELL COUNTY HEALTH DEPARTMENT

STATESVILLE 704-878-5305 MOORESVILLE 704-664-5281

IMPROVEMENT PERMIT / AUTHORIZATION TO CONSTRUCT / OPERATION PERMIT / EXISTING SYSTEM INSPECTION

PERMIT# 146728 PIN# 4750704830 ✓ DATE 11-29-07

OWNER OR APPLICANT ADAMS HOMES LLC PHONE: Business 704-202-1524 Home

ADDRESS 132 Joe V. Knox Ave. Suite 102 Mooresville NC 28117

LOCATION Hwy 115 N TR Shepherds TL Houston TL Colonial Congress TR Kings Mtn. Ct on left TL Mills Plantation

SUBDIVISION Georgia Mills BLOCK / SECTION - LOT 50 LOT AREA .764 AC SITE CLASS. PS DESIGN FLOW 480 L.T.A.R. .3 gpd/Ft²

Septic Tank: 1000 Gallons; STB 875 Date 3-19-10

Pump Tank: 1000 Gallons; PT 502 Date 3-2-10

Pump Make: ZOELLER Model M152 Serial No. 4HP

Nitrification Field: No Fields 1 Square Feet _____ Linear Feet 280

No Lines 4 Trench Width 24" min. Max Trench Bottom Depth 36" Gravel Depth NA ☐ Gravity ☒ Pressure

☒ New System ☐ Repair ☐ Expansion System Type: I II III (IV) V VI

System Description: LPPPBPS

Repair System Description: LPPPBPS

Maintenance Agreement Required: ☒ Yes ☐ No

☒ House/Mod. Home ☐ Mobile Home ☐ Business ☐ Other

No. Bedrooms 4 No. Persons 8 No. Employees ____

Water Supply: ☒ Individual ☐ Public ☐ Community

☐ Slab ☒ Crawl Space ☐ Basement w/plumbing ☐ Basement wo/plumbing

Comments:/Conditions:

System 100'+ from well
Fill gullies

Comments:/Conditions:

INITIAL SITE SKETCH

See Plan from S&ME

AS BUILT SKETCH

2' Pressure Head Set

Permit can be suspended or revoked if any false information is supplied toward securing the permit/any unauthorized changes are made to the site/any unauthorized changes are made in the installation of the system. Improvement Permit with plat valid without expiration ☐ Improvement Permit with site plan valid for sixty months ☒ Authorization to Construct is valid for a period equal to that of Improvement Permit – not to exceed sixty months.

Signed: _____ date _____

Improvement Permit by: _____ date 12-6-07

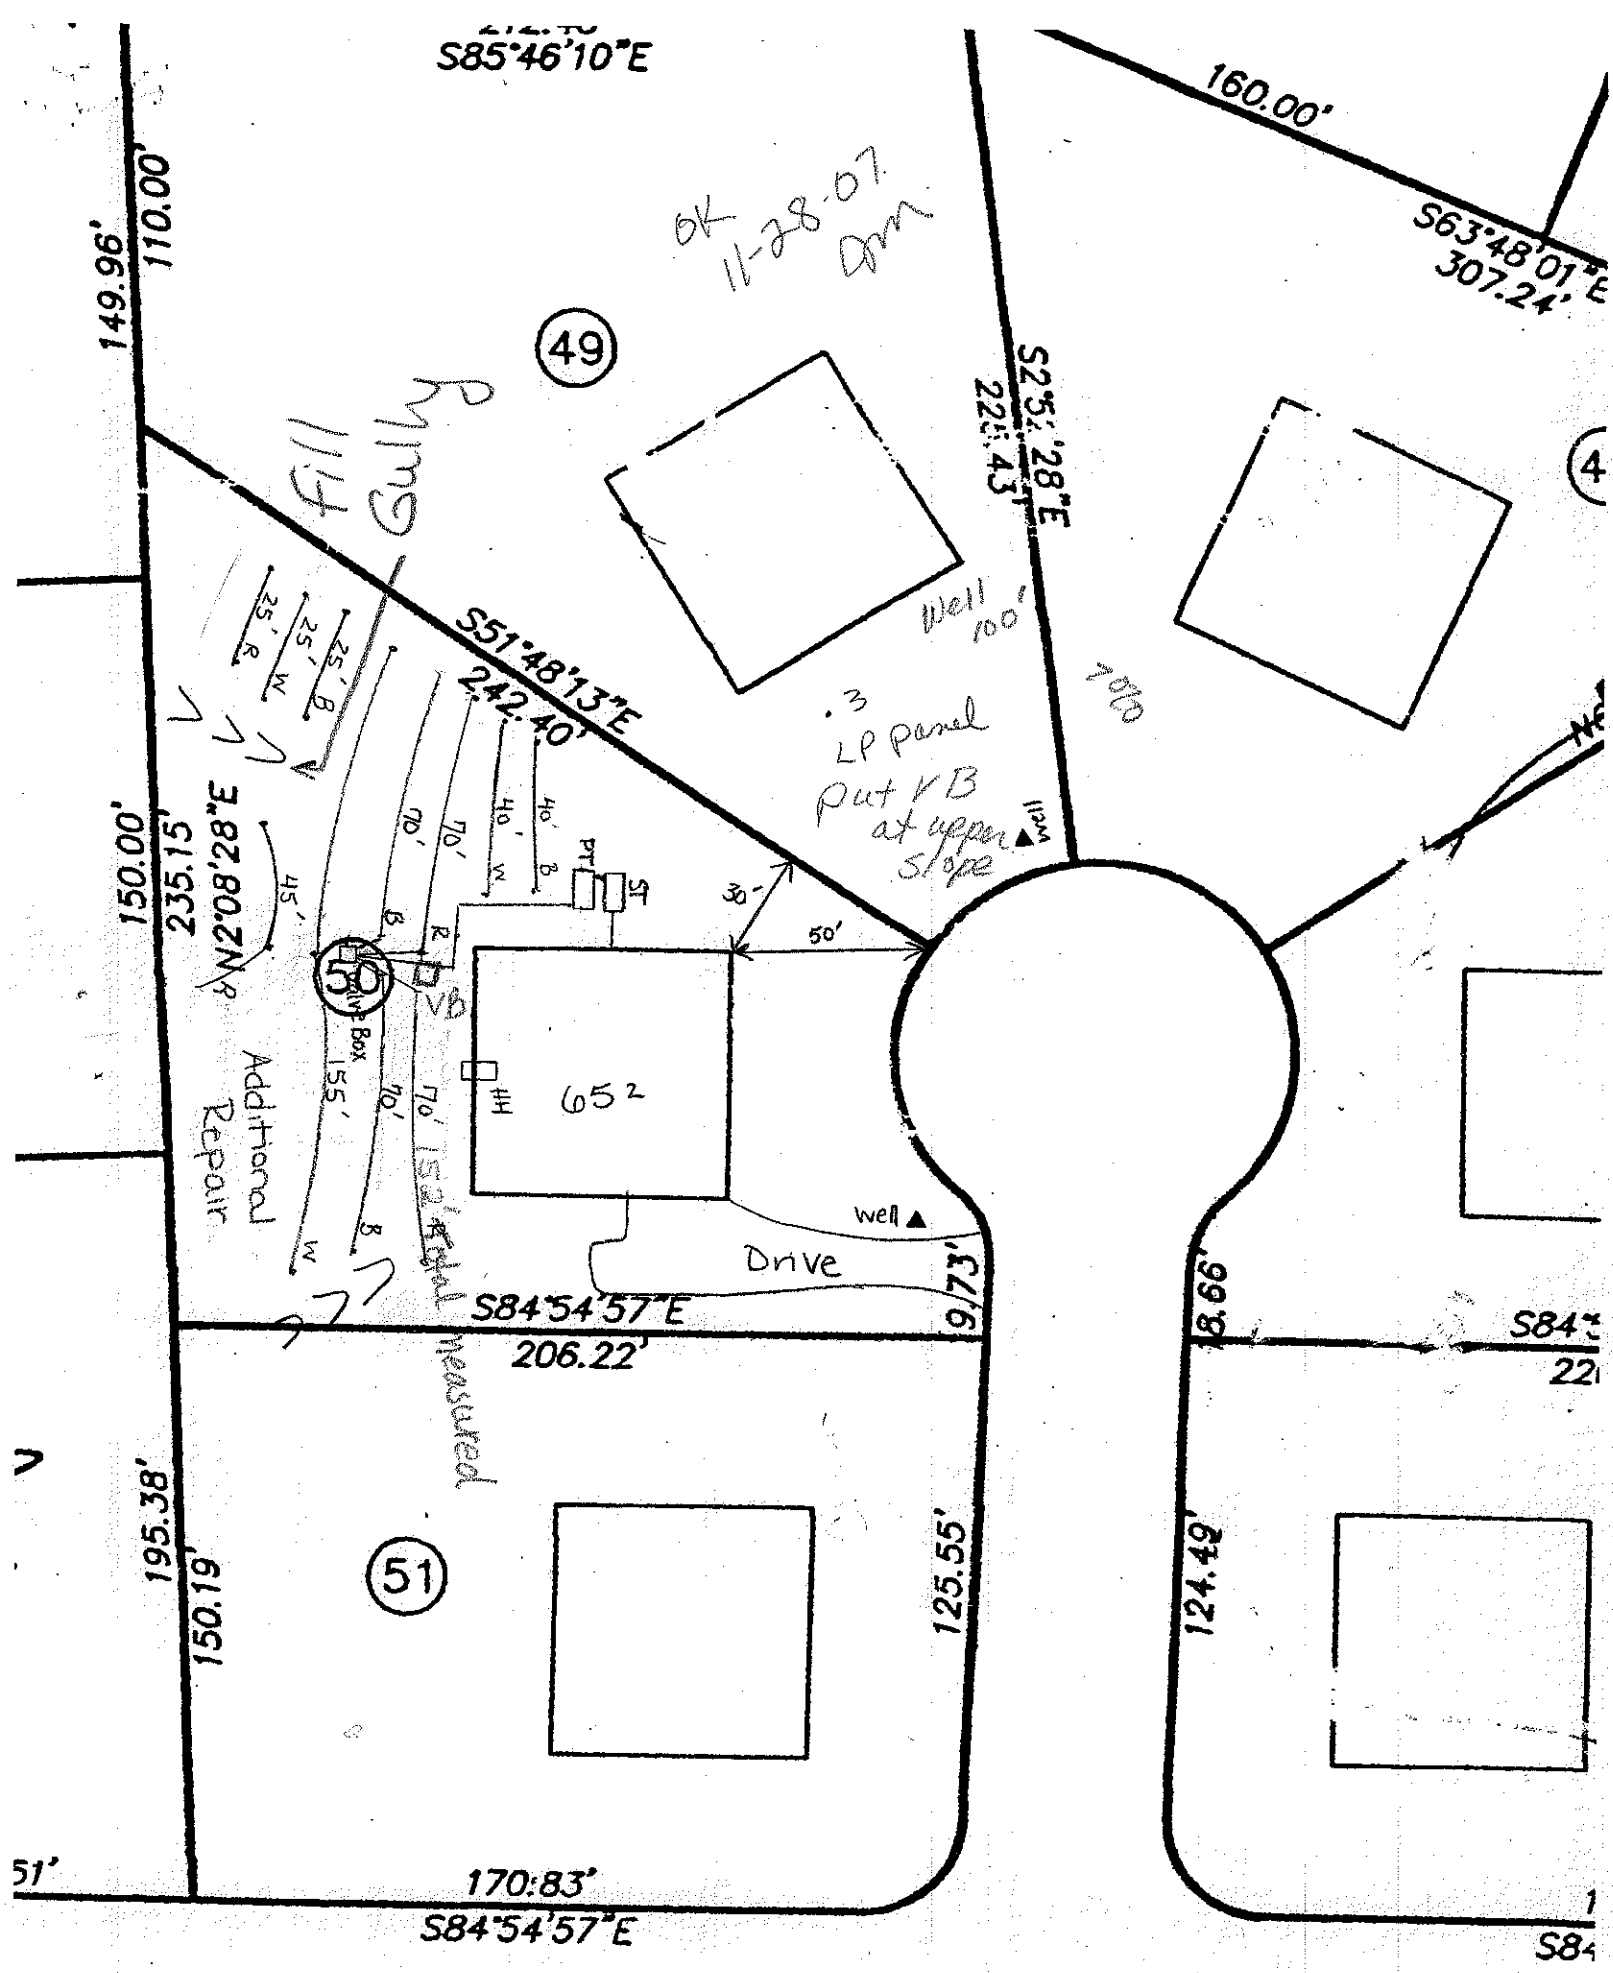
Authorization to Construct by: _____ REHS date 4-8-10

Installed by: Rowan Septic

Operation Permit by: _____ REHS date 6-30-10

Existing System Inspection by: _____ date _____

HEALTH DEPT. COPY: WHITE OWNER COPY (FINAL): YELLOW OWNER COPY (INITIAL): PINK


S85°46'10"E
160.00'
S63°48'01"E
307.24'
149.96'
110.00'
OK 11-28-07 DRM
49
Fill
Gully
S25°43'28"E
225.43'
S51°48'13"E
242.40'
Well 100'
.3 LP panel
Put KB at upper slope
Well
70'
40'
PT
LP
30'
50'
150.00'
235.15'
N2°08'28"E
45°
50
Drive Box
155'
Additional Repair
652
Well
Drive
S84°54'57"E
206.22'
9.73'
8.66'
S84°
22
Actual Measured
195.38'
150.19'
51
125.55'
124.49'
170.83'
S84°54'57"E
S84