IREDELL COUNTY HEALTH DEPARTMENT

ST[illegible]VILLE 704-878-5305 MOORESVILLE 704-664-5281

IMPROVEMENT PERMIT / AUTHORIZATION TO CONSTRUCT / OPERATION PERMIT / EXISTING SYSTEM INSPECTION

PERMIT# 146726 PIN# 4750704968 DATE 11-29-07

OWNER OR APPLICANT Pilot Developers PHONE: Business 704-202-1524 Home

ADDRESS 132 Joe V. Knox Ave, Suite 102 Mooresville NC 28117

LOCATION Hwy 115 N TR Shepherds TL Houston TL Colonial Congress Th Mills Plantation cir. TR Kings Mtn.

SUBDIVISION Georgia Mills BLOCK / SECTION LOT 49 LOT AREA .93Ac SITE CLASS. PS DESIGN FLOW 480gpd L.T.A.R. .3gpd/ft²

Septic Tank: 1000 Gallons: STB Date

Pump Tank: Gallons: PT Date

Pump Make: Model Serial No.

Nitrification Field: No Fields 1 Square Feet 1206 Linear Feet 402

No Lines 3@134' Trench Width 36" Max Trench Bottom Depth 36" Gravel Depth n/a ☒ Gravity ☐ Pressure

☒ New System ☐ Repair ☐ Expansion System Type: I II III IV V VI

System Description: 25% reduction gravity

Repair System Description: LP PPBPS

Maintenance Agreement Required: ☐ Yes ☒ No

☒ House/Mod. Home No. Bedrooms 4

☐ Mobile Home No. Persons 8

☐ Business No. Employees

☐ Other


Water Supply: ☒ Individual ☐ Public ☐ Community

☐ Slab ☒ Crawl Space ☐ Basement w/plumbing ☐ Basement wo/plumbing


Comments:/Conditions: Fill all gullies

Comments:/Conditions:

INITIAL SITE SKETCH

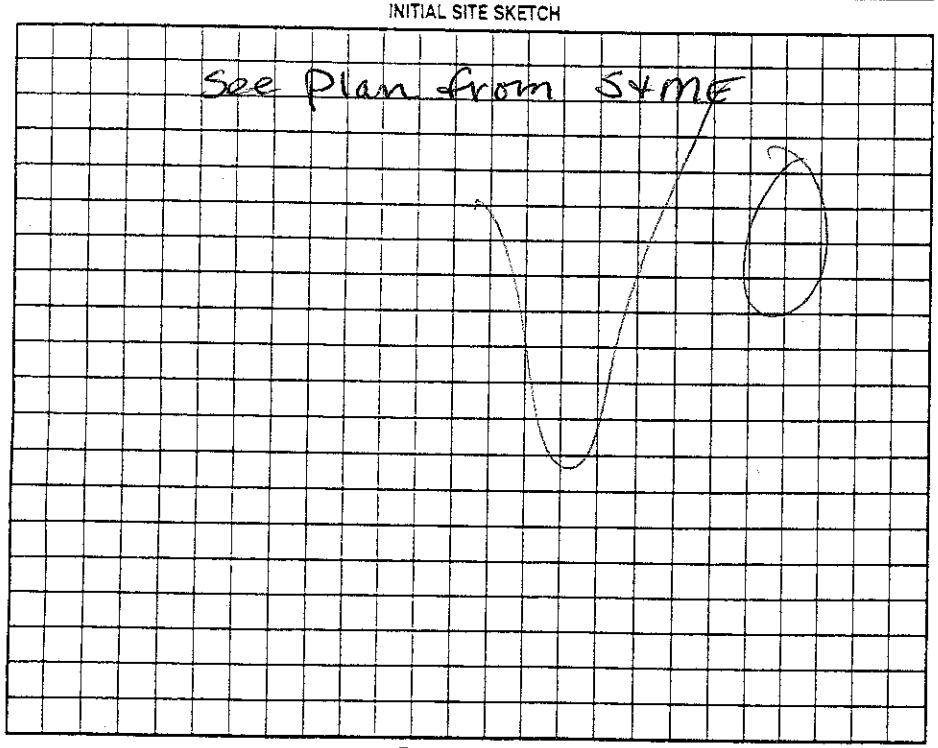

AS BUILT SKETCH

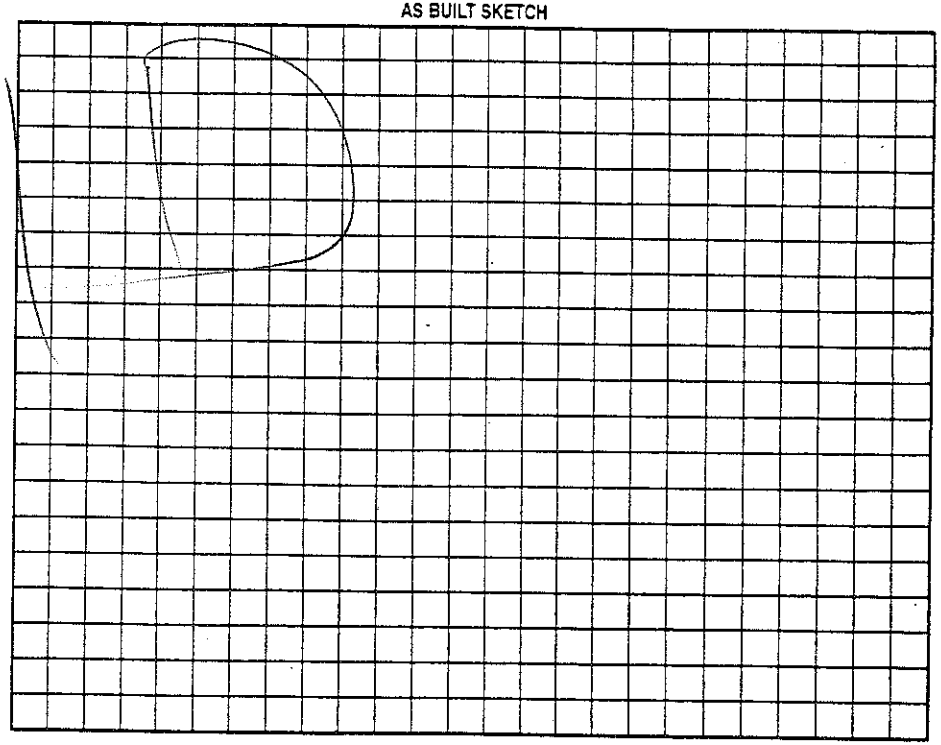

Permit can be suspended or revoked if any false information is supplied toward securing the permit/any unauthorized changes are made to the site/any unauthorized changes are made in the installation of the system. Improvement Permit with plat valid without expiration ☐ Improvement Permit with site plan valid for sixty months ☒ Authorization to Construct is valid for a period equal to that of Improvement Permit – not to exceed sixty months.

Signed: date

Improvement Permit by: Cindy McKillip date 11-29-07

Authorization to Construct by: date

Installed by:

Operation Permit by: date

Existing System Inspection by: date

HEALTH DEPT. COPY: WHITE OWNER COPY (FINAL): YELLOW OWNER COPY (INITIAL): PINK