IREDELL COUNTY HEALTH DEPARTMENT STATESVILLE 704-878-5305 MOORESVILLE 704-664-5281

IMPROVEMENT PERMIT / AUTHORIZATION TO CONSTRUCT / OPERATION PERMIT / EXISTING SYSTEM INSPECTION

PERMIT # 150354 PIN # ~~4750-70-6881~~ 4750706791 DATE 3-23-11

OWNER or APPLICANT: ADAMS HOMES LLC PHONE: Business 704-947-6118 Home:

OWNER or APPLICANT ADDRESS: 10115 KINCEY AVE #160 HUNTERSVILLE NC 28078

LOCATION / DIRECTIONS: 21N, SHEPHERD, TL HOUSTON, TL GA MILLS

SUBDIVISION: GA MILLS BLOCK / SECTION: LOT # 47 LOT AREA 1.55 AC DESIGN FLOW 480 L.T.A.R. .25

Septic Tank 1000 Gallons: STB 302 Date 2-17-11
Pump Tank 1000 Gallons: PT 825 Date 2-10-11
Pump Make Model Serial #
Nitrification Field No Fields 1 No Lines 8 Linear Feet 640'
Trench Width 36" Trench Bottom Depth 60" Gravel Depth 17" ☐ GRAVITY ☒ PRESSURE

☒ New System ☐ Repair ☐ Expansion System Type I II III IV (V) VI
System Description: LP. DEEP SAND LINED
Repair System Description: SAME
Maintenance Agreement Required ☒ YES ☐ NO

☒ Residence No. Bedrooms 4
☐ Business No. Persons
☐ Other No. Employees
☒ Slab ☐ Crawl Space
☐ Basement w/plumbing ☐ Basement w/o plumbing


Water Supply ☒ Private ☐ Public ☐ Community

* PICTURES ATTACHED

Comments / Conditions

Comments / Conditions: 1ST LINE TO BE MOVED BELOW KINGS MTN.

INITIAL SITE SKETCH AS BUILT SKETCH

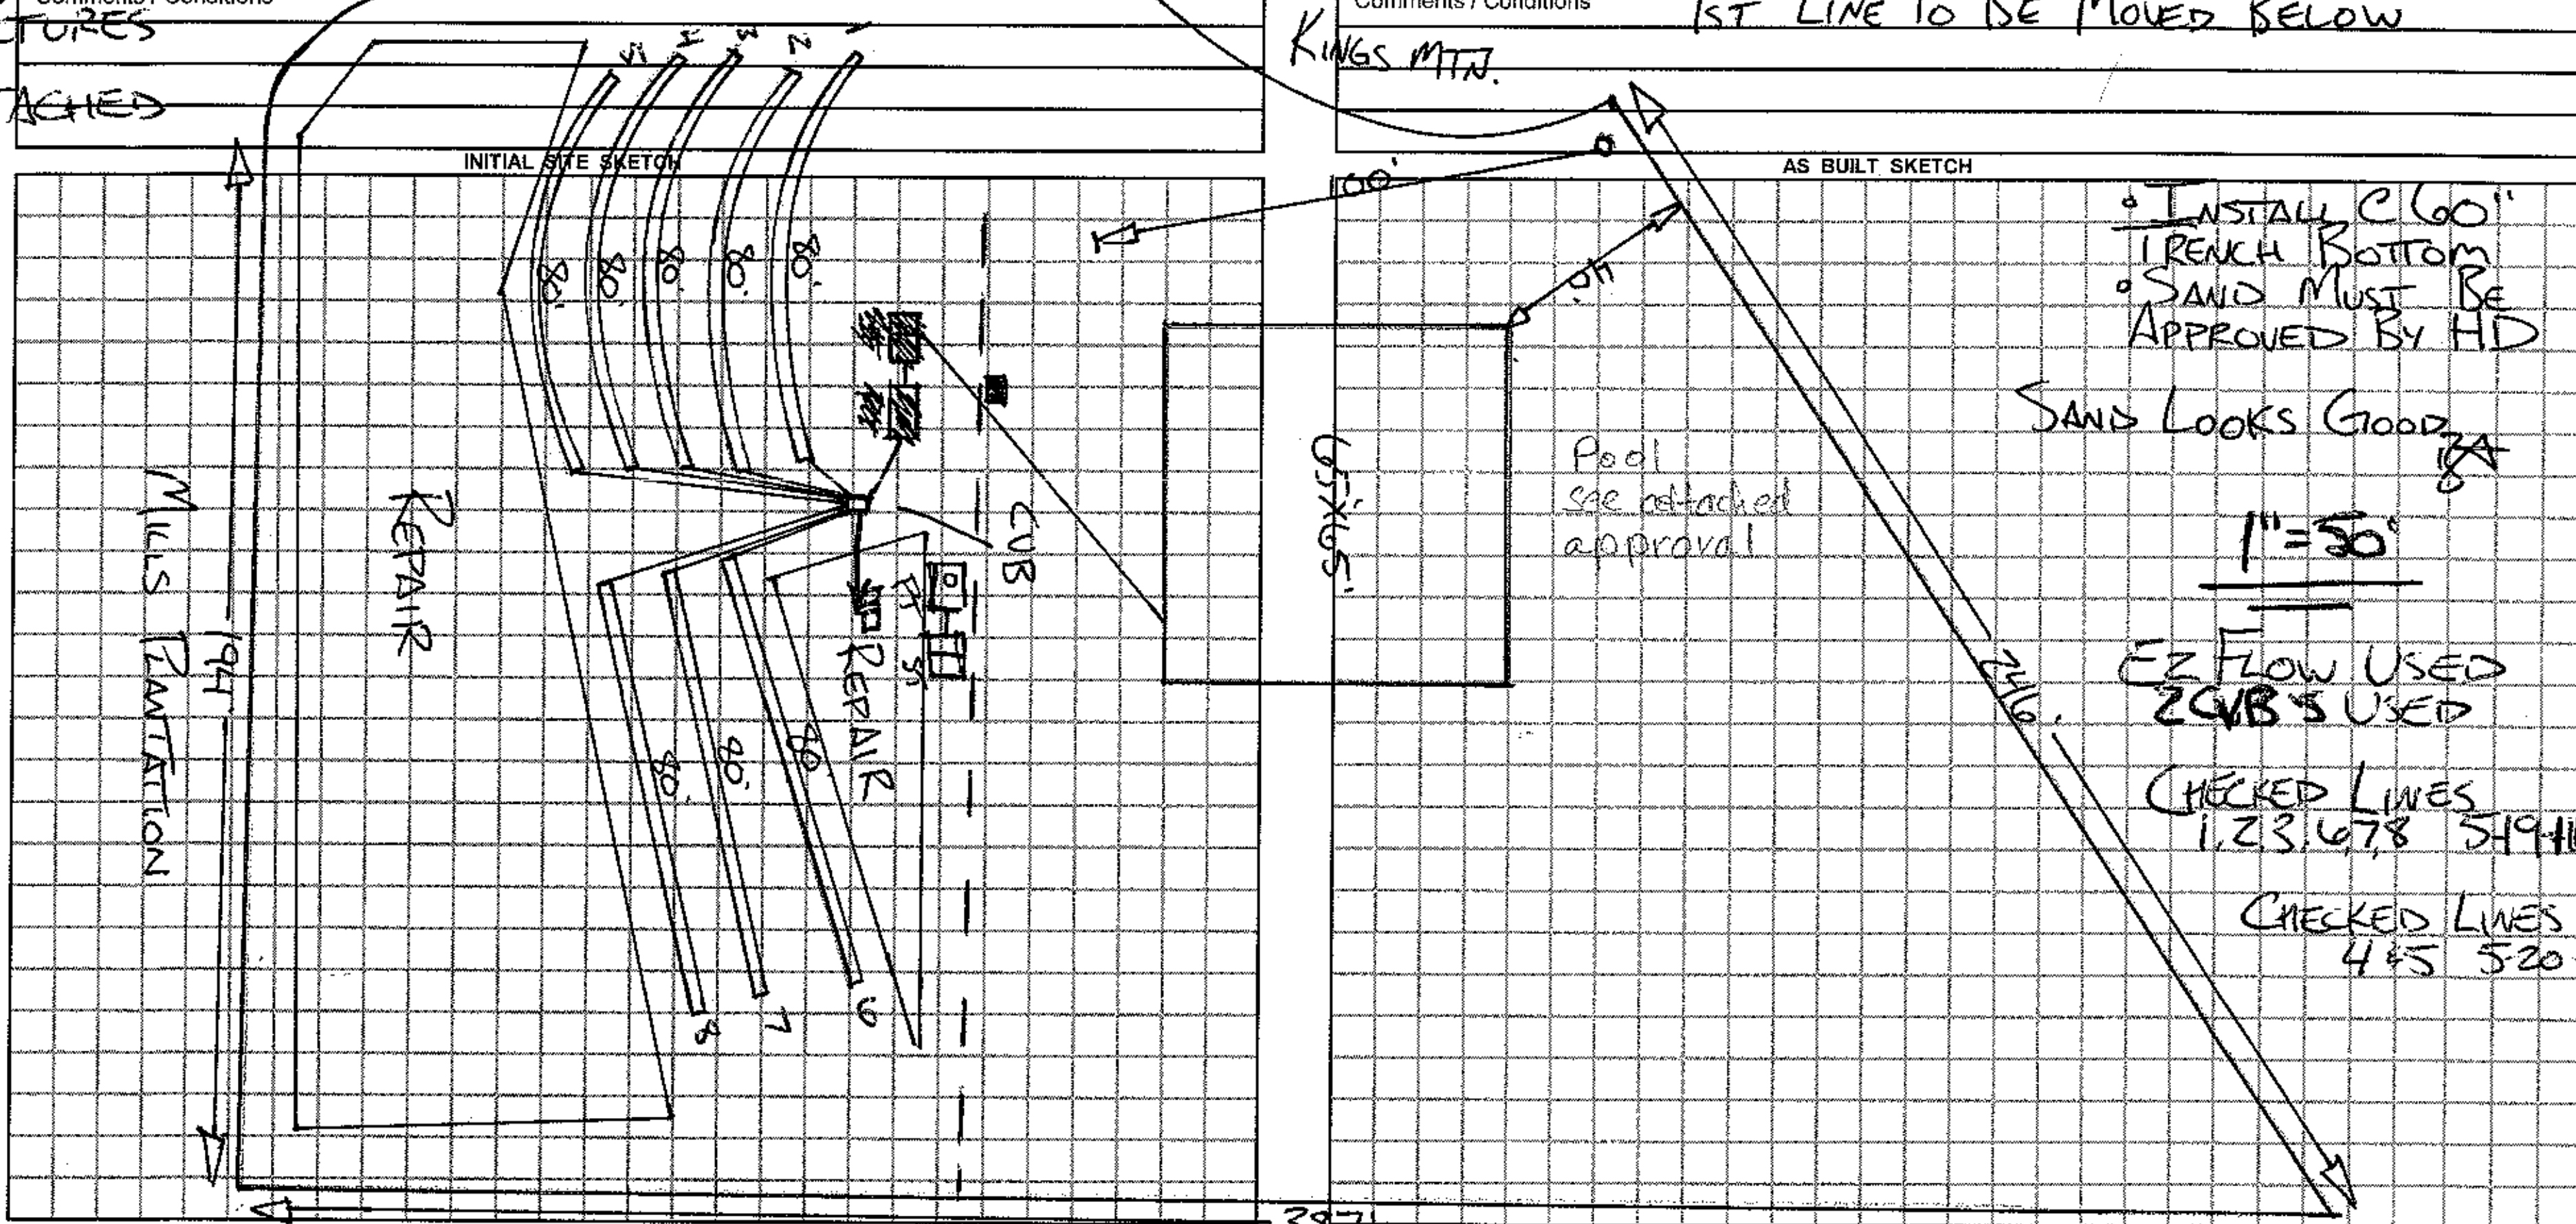

Permit can be suspended or revoked if any false information is supplied toward securing the permit / any unauthorized changes are made to the site / any unauthorized changes are made in the installation of the system.

☐ IMPROVEMENT PERMIT w / plat valid without expiration ☐ IMPROVEMENT PERMIT w / site plan valid for 60 mos. ☒ AUTHORIZATION TO CONSTRUCT valid for period equal to IMPROVEMENT PERMIT-not to exceed 60 mos.

Owner / Applicant Signature: [signature] Date 3/29/11
Improvement Permit by: [signature] REHS Date 3-24-11
Authorzation to Construct by: [signature] REHS Date 3-24-11

Installed by: ROWAN SEPTIC
Operation Permit by: [signature] REHS Date: 6-20-11
Existing System Inspected by: Date:

YOU SHOULD CONTACT A LOCATOR SERVICE PRIOR TO ANY EXCAVATION.

WHITE COPY Environmental Health YELLOW COPY (Final) Owner / Applicant PINK COPY (Initial) Owner / Applicant

IREDELL COUNTY HEALTH DEPARTMENT

STATESVILLE 704-878-5305 MOORESVILLE 704-664-5281

IMPROVEMENT PERMIT / AUTHORIZATION TO CONSTRUCT / OPERATION PERMIT / EXISTING SYSTEM INSPECTION

PERMIT # 150354 PIN # 4750-70-6881 DATE 3-25-11

OWNER or APPLICANT ADAMS HOMES LLC PHONE: Business 704-947-6118 Home:

OWNER or APPLICANT ADDRESS 10115 KINCEY AVE #1160 HUNTERSVILLE NC 28078

LOCATION / DIRECTIONS 21N, SHEPHERD, TL HOUSTON, TL GA MILLS

SUBDIVISION GA MILLS BLOCK / SECTION LOT # 47 LOT AREA 1.55 AC DESIGN FLOW 480 L.T.A.R. .25

Septic Tank 1000 Gallons: STB 302 Date 2-17-11
Pump Tank 1000 Gallons: PT 825 Date 2-10-11
Pump Make Model Serial #
Nitrification Field No Fields 1 No Lines 6 Linear Feet 60'
Trench Width 36" Trench Bottom Depth 60" Gravel Depth 12"

☒ New System ☐ Repair ☐ Expansion System Type I II III IV V VI
System Description: LP. DEEP SAND LINED
Repair System Description: SAME
Maintenance Agreement Required ☒ YES ☐ NO
☐ GRAVITY ☒ PRESSURE


☒ Residence No. Bedrooms 4
☐ Business No. Persons
☐ Other No. Employees
☒ Slab ☐ Crawl Space
☐ Basement w/plumbing ☐ Basement w/o plumbing

Water Supply: ☒ Private ☐ Public ☐ Community

* PICTURES ATTACHED


Comments / Conditions

INITIAL SITE SKETCH

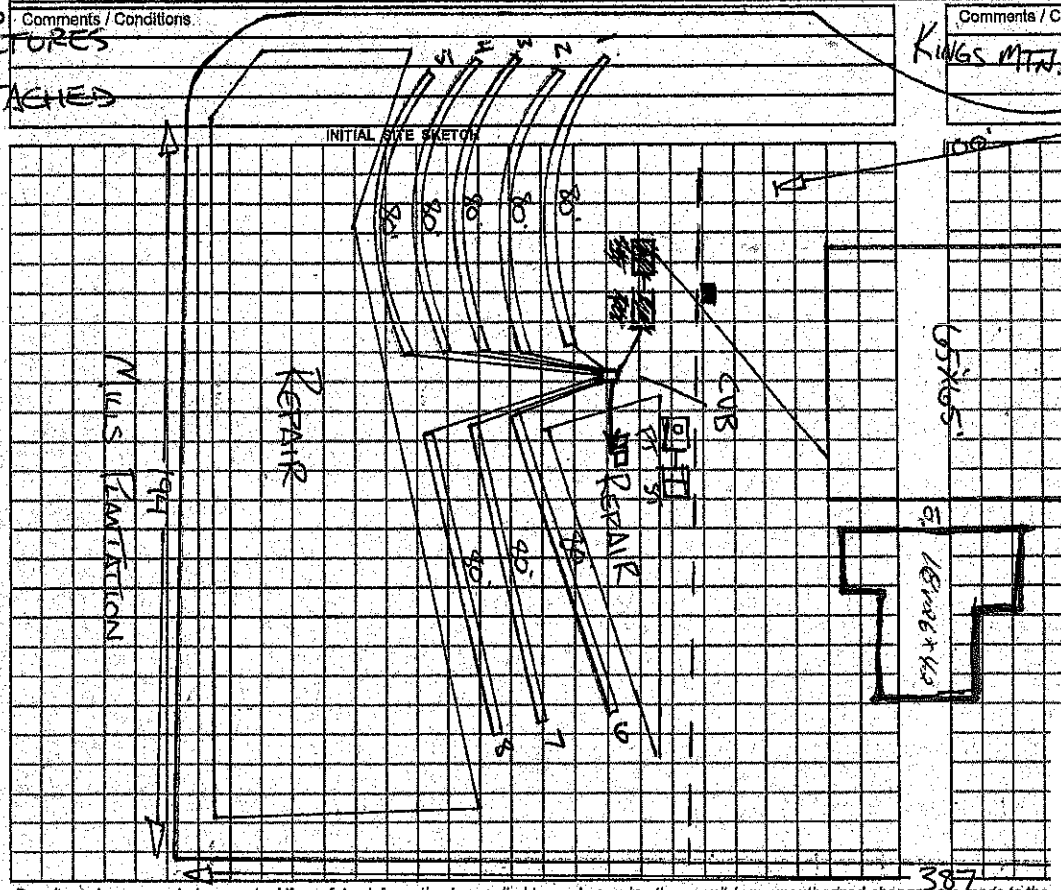

Comments / Conditions 1ST LINE TO BE MOVED BELOW KINGS MTN.

AS BUILT SKETCH

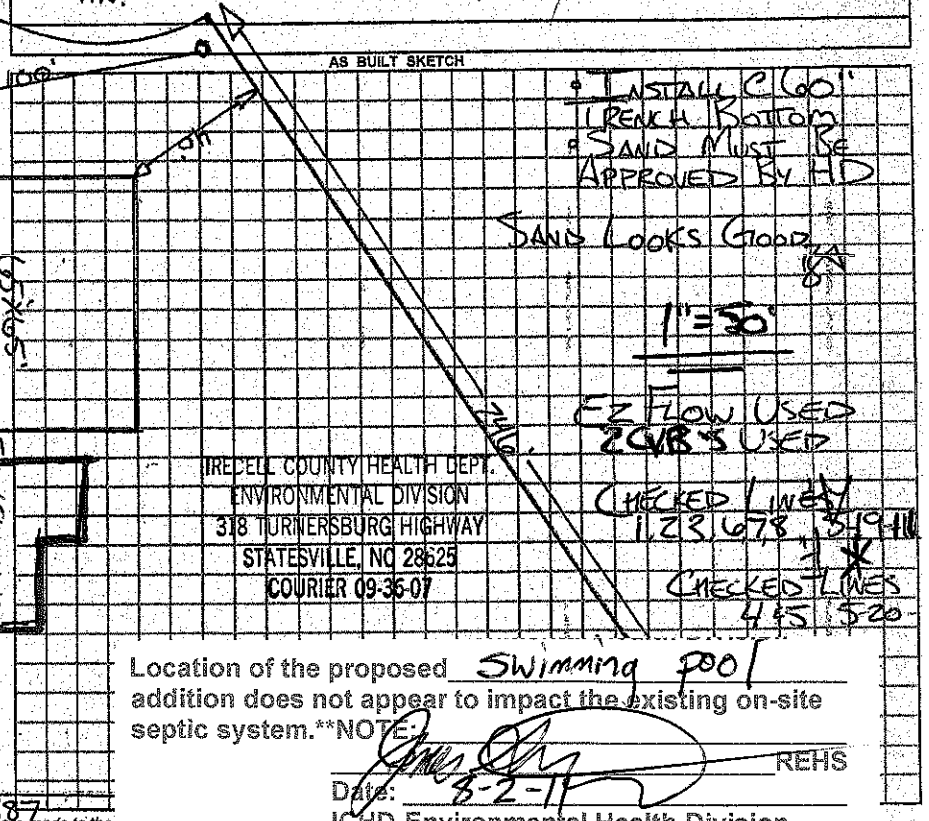

- INSTALL @ 60" TRENCH BOTTOM
- SAND MUST BE APPROVED BY HD

SAND LOOKS GOOD

1"=30'

EZ FLOW USED
2 CVB'S USED


Location of the proposed Swimming pool addition does not appear to impact the existing on-site septic system.**NOTE:

REHS


ICHD-Environmental Health Division

Permit can be suspended or revoked if any false information is supplied toward securing the permit / any unauthorized changes are made to the

☐ IMPROVEMENT PERMIT w / plat valid without expiration ☐ IMPROVEMENT PERMIT w / site plan valid for 60 mos. ☒ AUTHORIZATION TO CONSTRUCT valid for period equal to IMPROVEMENT PERMIT-not to exceed 60 mos

Owner / Applicant Signature: Date 3/29/11

Improvement Permit by: REHS Date 3-24-11

Authorization to Construct by: REHS Date 3-24-11

Installed by: ROWAN SEPTIC

Operation Permit by: REHS Date: 6-20-11

Existing System Inspected by: Date:

YOU SHOULD CONTACT A LOCATOR SERVICE PRIOR TO ANY EXCAVATION.

WHITE COPY Environmental Health YELLOW COPY (Final) Owner / Applicant PINK COPY (Initial) Owner / Applicant