IREDELL COUNTY HEALTH DEPARTMENT

STATESVILLE 704-878-5305 MOORESVILLE 704-664-5281

IMPROVEMENT PERMIT / AUTHORIZATION TO CONSTRUCT / OPERATION PERMIT / EXISTING SYSTEM INSPECTION

PERMIT # 146712 PIN # 4750706913 DATE 11/4/08

OWNER or APPLICANT Adams Homes PHONE: Business 704-202-1524 Home: 704-947-6118

OWNER or APPLICANT ADDRESS ~~132 Joe V. Knox~~ 3000 Gulfbreeze Pkwy Gulfbreeze, FL 32563

LOCATION / DIRECTIONS Shepards Rd. TL Houston, TL Colonial Congress, TL Mills Plantation, TR Kings Mtn. at end

SUBDIVISION Georgia Mills BLOCK / SECTION LOT # 48 LOT AREA 0.82 ac DESIGN FLOW 480 gal/d L.T.A.R. 0.3

Septic Tank 1000 Gallons: STB 825 Date 9-30-08

Pump Tank 1000 Gallons: PT 302 Date 9-30-08

Pump Make Zoeller Model N152 Serial #

Nitrification Field No Fields 1 No Lines 7 Linear Feet 280'

Trench Width 24" Max. Trench Bottom Depth 36" Gravel Depth —

☑ New System ☐ Repair ☐ Expansion System Type I II III IV V VI

System Description: LP PPBPS

Repair System Description: Sand

Maintenance Agreement Required ☑ YES ☐ NO

☐ GRAVITY ☑ PRESSURE

☑ Residence No. Bedrooms 4

☐ Business No. Persons

☐ Other No. Employees

☑ Slab ☐ Crawl Space


☐ Basement w/plumbing ☐ Basement w/o plumbing

Water Supply: ☑ Private ☐ Public ☐ Community


Comments / Conditions
* This permit replaces previous permit which is void b/c of changes to septic area
* Maintain all setbacks, Install on contour

Comments / Conditions
* Call Health Dept. before any grading is to be done

INITIAL SITE SKETCH

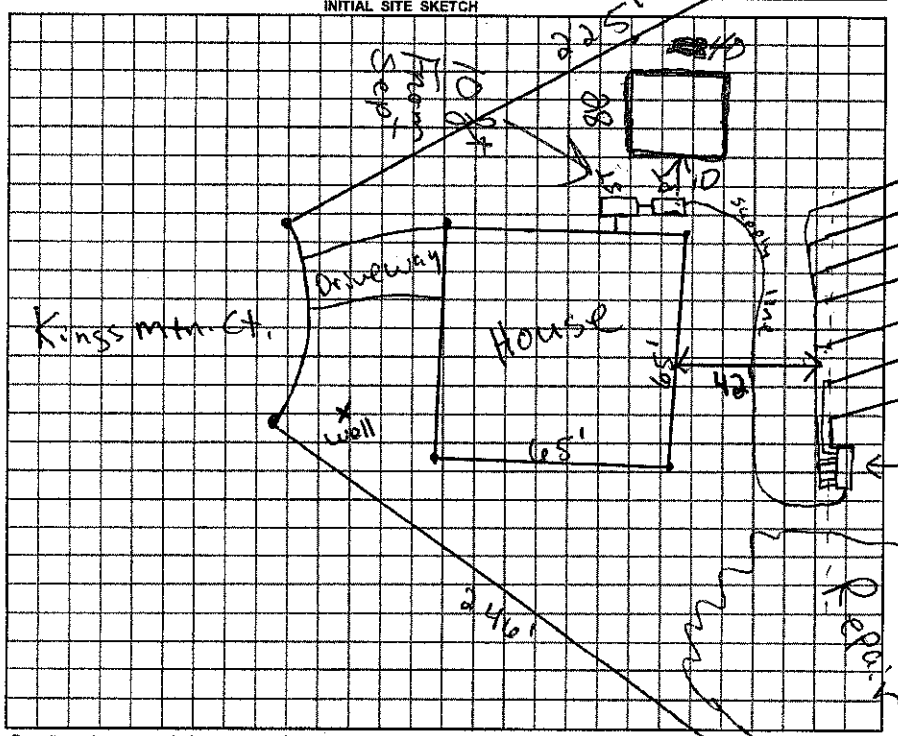

AS BUILT SKETCH

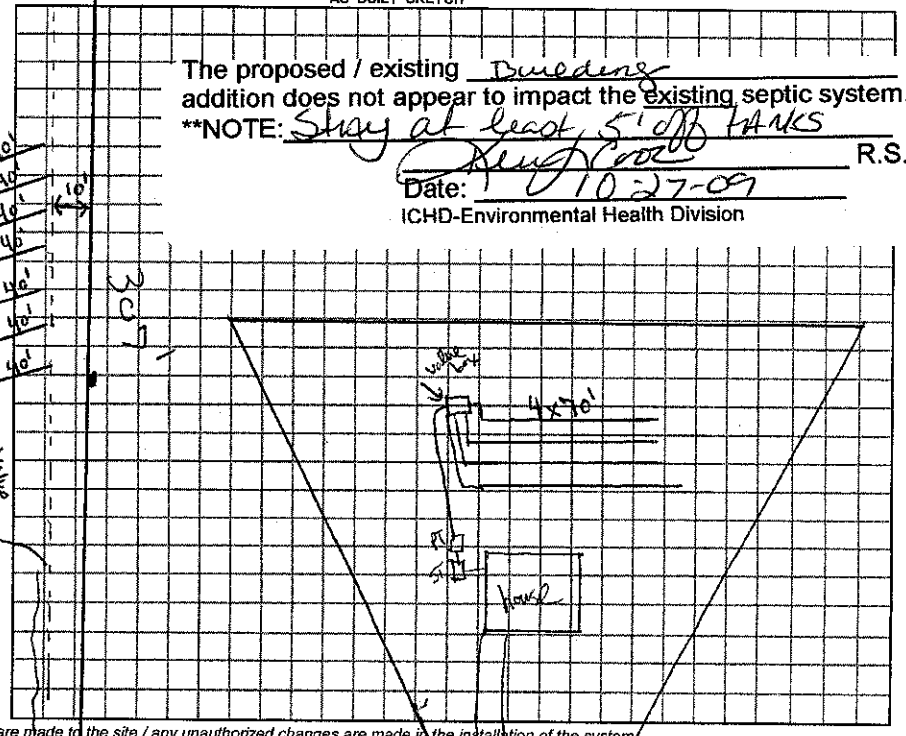

The proposed / existing Dwelling addition does not appear to impact the existing septic system.

**NOTE: Stay at least 5' off banks

R.S.

Date: 10-27-09

ICHD-Environmental Health Division

Permit can be suspended or revoked if any false information is supplied toward securing the permit / any unauthorized changes are made to the site / any unauthorized changes are made in the installation of the system.

☐ *IMPROVEMENT PERMIT w / plat valid without expiration.* ☑ *IMPROVEMENT PERMIT w / site plan valid for 60 mos.* ☑ *AUTHORIZATION TO CONSTRUCT valid for period equal to IMPROVEMENT PERMIT-not to exceed 60 mo.*

Owner / Applicant Signature: [signature] Date 11/12/08

Improvement Permit by: [signature] Date 11/4/08

Authorization to Construct by: [signature] Date 11/4/08

YOU SHOULD CONTACT A LOCATOR SERVICE PRIOR TO ANY EXCAVATION.

Installed by: Rowan

Operation Permit by: [signature] Date: 4/20/09

Existing System Inspected by: Date:

WHITE COPY Environmental Health YELLOW COPY (Final) Owner / Applicant PINK COPY (Initial) Owner / Applicant