IREDELL COUNTY HEALTH DEPARTMENT - *ENVIRONMENTAL HEALTH* ☐ STATESVILLE OFFICE 704-878-5305 ☒ MOORESVILLE OFFICE 704-664-3201

IMPROVEMENT PERMIT / AUTHORIZATION TO CONSTRUCT / OPERATION PERMIT / EXISTING SYSTEM INSPECTION

PERMIT # 146396 PIN # ~~4750-70-8664~~ 4750709615 DATE 8-10-11

OWNER ADAMS HOMES APPLICANT: SAME PHONE: Home/Cell # 704-947-6118 Business #

SITE ADDRESS 172 MILLS PLANTATION CR OWNER / APPLICANT ADDRESS 10115 KINCEY AVE HUNTERSVILLE

SITE DIRECTIONS 21N, SHEPHERD, TL HOUSTON, TL COLONIAL CONGRESS, TL M. PLANTATION CR, ON R

SUBDIVISION GA MILLS BLOCK / SECTION LOT # 45 LOT AREA .88AC DESIGN FLOW 480 L.T.A.R. .35 (ESR)

Septic Tank 1000 Gallons: STB 325 Date 7-8-11

Pump Tank 1000 Gallons: PT 902 Date 6-5-11

Pump Make ZOELLER Model N152 Serial #

No. Nitrification Fields: 1 No. Lines 5 Linear Feet 235'

Trench Width 24-36" Max. Trench Bottom Depth 36"

☒ New System ☐ Repair ☐ Expansion System Type I II III IV V VI

System Description: PM - PANEL BLOCK

Repair System Description: LP - PANEL BLOCK

Maintenance Agreement Required ☐ YES ☒ NO INITIALLY

Gravel Depth SAND ☐ GRAVITY ☒ PRESSURE

☒ Residence No. Bedrooms 4

☐ Business No. Persons

☐ Other No. Employees


☒ Slab ☐ Crawl Space

☐ Basement w/plumbing ☐ Basement w/o plumbing

Water Supply: ☒ Private ☐ Public ☐ Community


Comments / Conditions ① MEET ALL SET BACKS ② 100' FROM WELL SITE
② BE SURE OF PROPERTY CORNERS / LINES BEFORE INSTALLATION

INITIAL SITE SKETCH

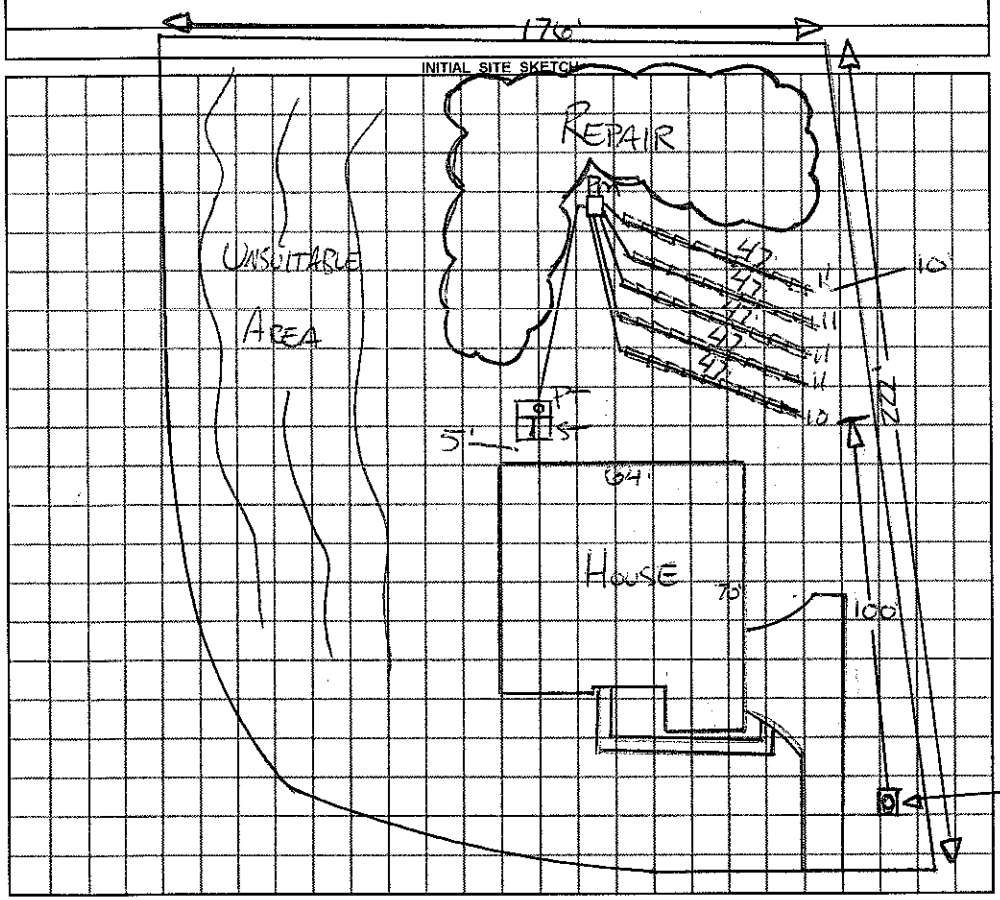

AS BUILT SKETCH

SET 2' P+T 9-1-11
CHECKED PANELS & LINES 9-1-11
103' FROM WELL
11 PANELS IN 1ST 4 LINES
10 IN LAST

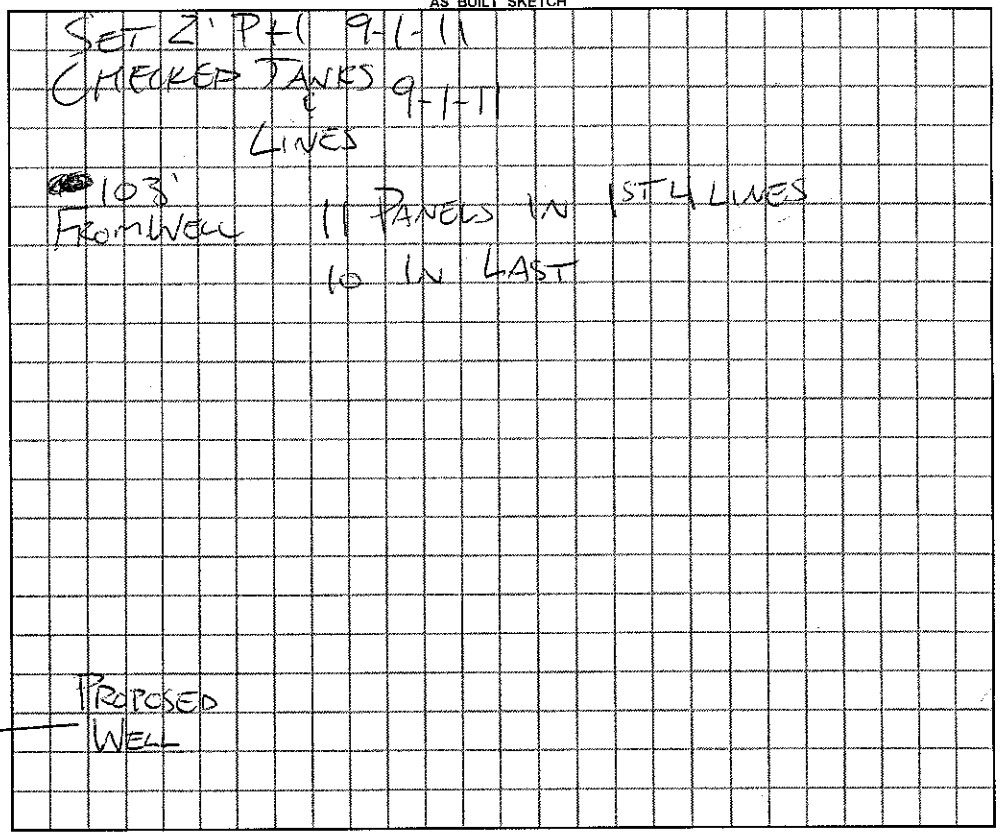

Permit can be suspended or revoked if any false information is supplied toward securing the permit / any unauthorized changes are made to the site / any unauthorized changes are made in the installation of the system.

☐ *IMPROVEMENT PERMIT* with plat valid without expiration. ☐ *IMPROVEMENT PERMIT* with ~~plat valid without expiration~~ site plan valid 60 mo. ☒ ~~*AUTHORIZATION TO CONSTRUCT*~~ valid for period equal to IMPROVEMENT PERMIT--not to exceed 60 mo.

Owner / Applicant Signature: Matt Calhoun Date

IMPROVEMENT PERMIT by: REHS Date 8-10-11

AUTHORIZATION TO CONSTRUCT by: REHS Date 8-10-11

Installed by: ROWAN

OPERATION PERMIT by: REHS Date 11-14-11

Existing System Inspected by: REHS Date

YOU SHOULD CONTACT A LOCATOR SERVICE PRIOR TO ANY EXCAVATION

White Copy – Environmental Health YELLOW COPY (Final) Owner / Applicant PINK COPY (Initial) Owner / Applicant