George Kincpatrick 704 202-5045 2:00pm 9-25

IREDELL COUNTY HEALTH DEPARTMENT

STATESVILLE 704-878-5305 MOORESVILLE 704-664-5281

IMPROVEMENT PERMIT / AUTHORIZATION TO CONSTRUCT / OPERATION PERMIT / EXISTING SYSTEM INSPECTION

PERMIT# 146393 PIN# 4756709918 DATE 7-11-2008

OWNER OR APPLICANT Adams Homes PHONE: Business (704) - 947 - 6118 Home

ADDRESS 10115 Kincey Ave. #160 Huntersville, NC 28078

LOCATION Hwy 115 N TR Shepherd TL Houston TL Colonial Congress TL Mills Plantation, on RT

SUBDIVISION Georgia Mills BLOCK / SECTION LOT 43 LOT AREA .89 ac SITE CLASS. PS DESIGN FLOW 480 L.T.A.R. .25 GPD/FT2

Septic Tank: 1000 Gallons: STB 825 Date 6-3-08

Pump Tank: 1000 Gallons: PT 307 Date 7-20-08

Pump Make: Zoeller Model N152 Serial No. .4 HP

Nitrification Field: No Fields 1 Square Feet Linear Feet 320

No Lines 8 Trench Width 24" min. Max Trench Bottom Depth 36" Gravel Depth

☒ New System ☐ Repair ☐ Expansion System Type: I II III IV V VI

System Description: 2x PPDPS - 4P IV

Repair System Description: LP PPDPS

Maintenance Agreement Required: ☒ Yes ☐ No

☒ House/Mod. Home ☐ Mobile Home ☐ Business ☐ Other

No. Bedrooms 4 No. Persons No. Employees


Water Supply: ☒ Individual ☐ Public ☐ Community

☐ Gravity ☒ Pressure ☒ Slab ☒ Crawl Space ☐ Basement w/plumbing ☐ Basement wo/plumbing

Comments:/Conditions:

SHAVE TERRACES TO SHED WATER IN SYSTEM AREA.

INITIAL SITE SKETCH

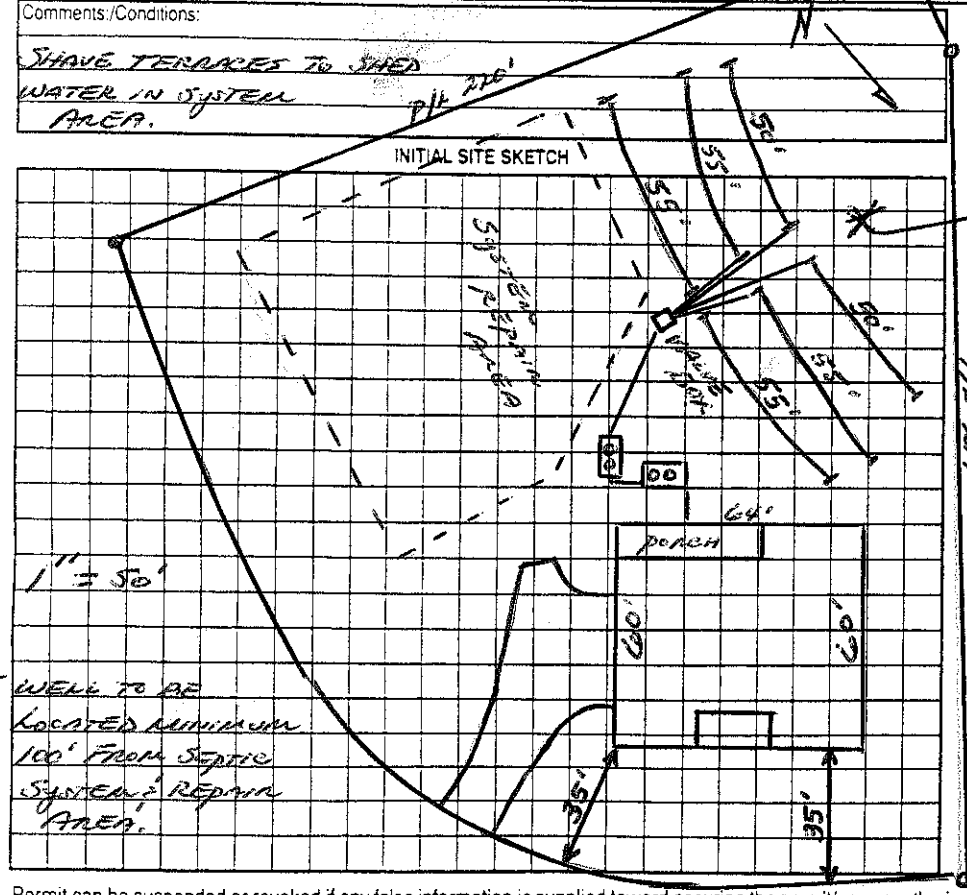


* WELL TO BE LOCATED MINIMUM 100' FROM SEPTIC SYSTEM & REPAIR AREA.

Comments:/Conditions: THIS PERMIT REPLACES VOIDED PERMIT DATED 11-26-07.

* OK TO DO 8 - 40's W/ PRESSURE MANIFOLD 9-18-08 CTH

AS BUILT SKETCH

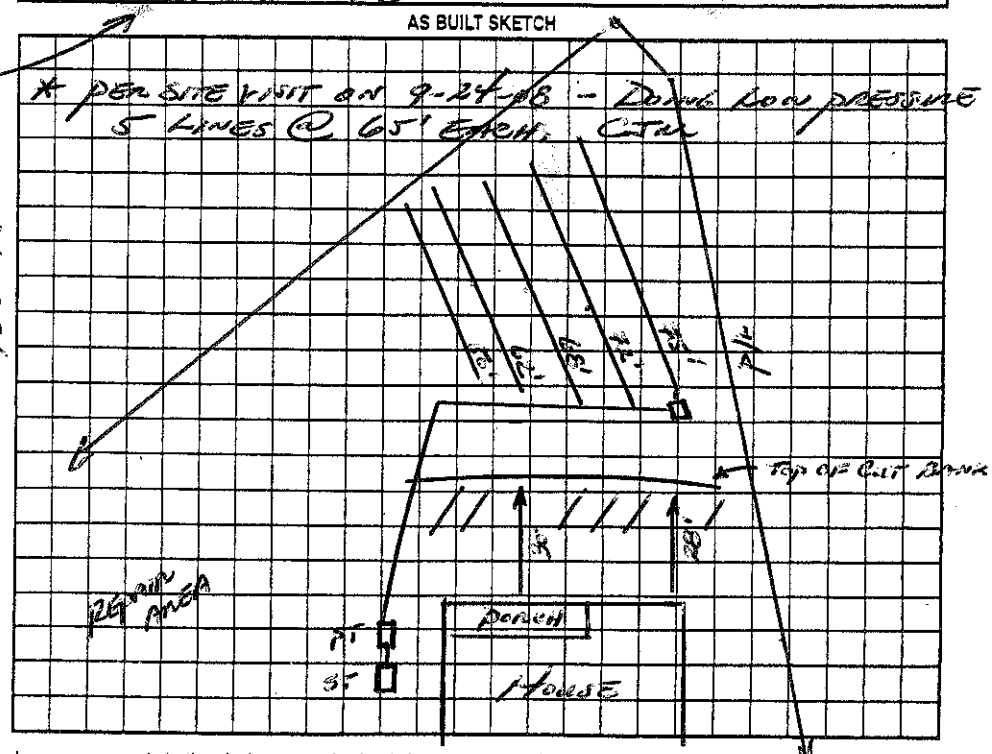

Permit can be suspended or revoked if any false information is supplied toward securing the permit/any unauthorized changes are made to the site/any unauthorized changes are made in the installation of the system. Improvement Permit with plat valid without expiration ☐ Improvement Permit with site plan valid for sixty months ☒ Authorization to Construct is valid for a period equal to that of Improvement Permit – not to exceed sixty months.

Signed: _____ date _____

Improvement Permit by: E. M. Wilson, R.S. date 7-11-08

Authorization to Construct by: E. M. Wilson, R.S. date 7-11-08

Installed by: Raven Septic Tank

Operation Permit by: Wesley Upchurch RS date 10/3/08

Existing System Inspection by: _____ date _____

HEALTH DEPT. COPY: WHITE OWNER COPY (FINAL): YELLOW OWNER COPY (INITIAL): PINK