IREDELL COUNTY HEALTH DEPARTMENT STATESVILLE 704-878-5305 MOORESVILLE 704-664-5281

IMPROVEMENT PERMIT / AUTHORIZATION TO CONSTRUCT / OPERATION PERMIT / EXISTING SYSTEM INSPECTION

PERMIT # 165882 PIN # 4750712404 DATE 5-3-2011

OWNER or APPLICANT Steven Nail PHONE: Business 704 645-5368 Home: 704 528-5398

OWNER or APPLICANT ADDRESS 268 Mills Plantation Cir. Troutman, NC 28166

LOCATION / DIRECTIONS Hwy 115/ US21 N TR Shepherd Rd TL Houston TL Colonial Congress TR Mills Plantation on right

SUBDIVISION CA Mills Plantation BLOCK / SECTION LOT # 13 LOT AREA .75Ac. DESIGN FLOW 480gpd L.T.A.R. .3

Septic Tank 1000 Gallons: STB Date

Pump Tank 1000 Gallons: PT Date

Pump Make Model Serial #

Nitrification Field No Fields 1 No Lines 5 Linear Feet 270'

Trench Width 24" Max. Trench Bottom Depth 36" Gravel Depth N/A ☐ GRAVITY ☒ PRESSURE

☐ New System ☐ Repair ☐ Expansion System Type I II III IV V VI

System Description: Existing Pump-LP-Panel Block

Repair System Description: Same

Maintenance Agreement Required ☒ YES ☐ NO

☒ Residence No. Bedrooms 4

☐ Business No. Persons

☐ Other No. Employees

☒ Slab raised ☐ Crawl Space


☐ Basement w/plumbing ☐ Basement w/o plumbing

Water Supply: ☒ Private ☐ Public ☐ Community

Comments / Conditions: Existing Septic System appears to be functioning okay at time of inspection.

Scale 1:50

INITIAL SITE SKETCH

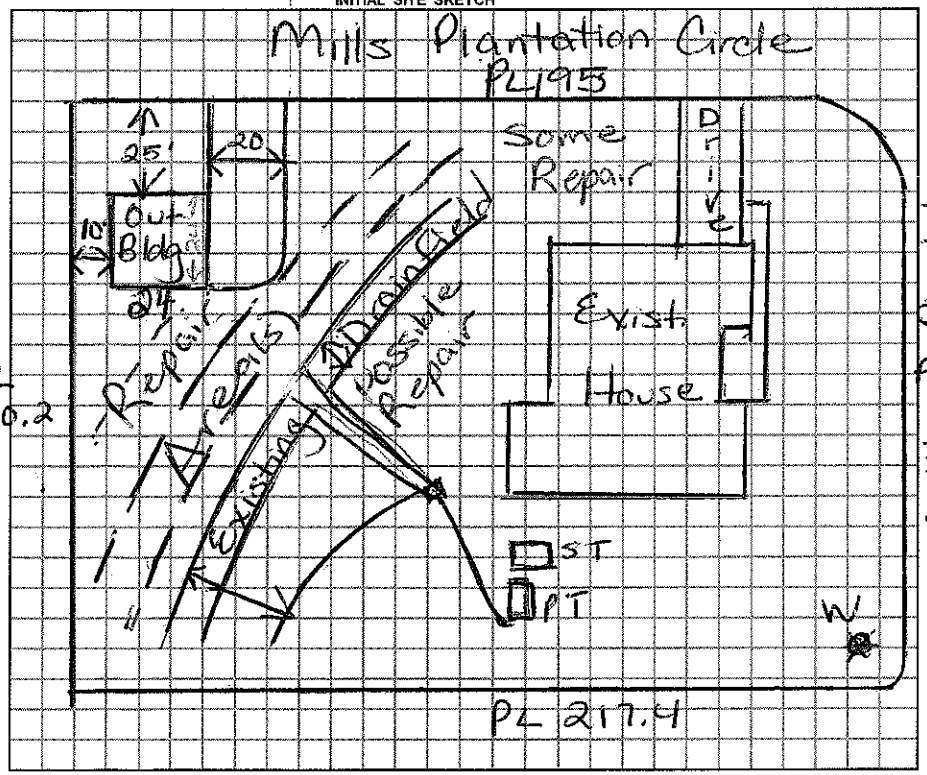

Comments / Conditions: (Note: House was occupied prior to final inspection on Septic System.) Septic System should not be impacted if Out Bldg is built as drawn.

AS BUILT SKETCH

Permit can be suspended or revoked if any false information is supplied toward securing the permit / any unauthorized changes are made to the site / any unauthorized changes are made in the installation of the system.

☐ *IMPROVEMENT PERMIT w / plat valid without expiration.* ☐ *IMPROVEMENT PERMIT w / site plan valid for 60 mos.* ☐ *AUTHORIZATION TO CONSTRUCT valid for period equal to IMPROVEMENT PERMIT-not to exceed 60 mo.*

Owner / Applicant Signature: Steven Nail Date 5/3/11

Improvement Permit by: Date

Authorzation to Construct by: Date

Installed by: Rowan Septic 5-22-08

Operation Permit by: Date:

Existing System Inspected by: Marian Johnson RS. Date: 5/3/11

YOU SHOULD CONTACT A LOCATOR SERVICE PRIOR TO ANY EXCAVATION.

WHITE COPY Environmental Health YELLOW COPY (Final) Owner / Applicant PINK COPY (Initial) Owner / Applicant