IREDELL COUNTY HEALTH DEPARTMENT - *ENVIRONMENTAL HEALTH* ☑ STATESVILLE OFFICE 704-878-5305 ☐ MOORESVILLE OFFICE 704-664-5281

IMPROVEMENT PERMIT / AUTHORIZATION TO CONSTRUCT / OPERATION PERMIT / EXISTING SYSTEM INSPECTION

PERMIT # 173550 PIN # 4750712574 DATE 7-12-12

OWNER Lee Rhyne APPLICANT: Rick Zylak PHONE: Home/Cell # 704-508-1175 Business # N/A

SITE ADDRESS 272 Mills Plantation Cir. OWNER / APPLICANT ADDRESS 122 Mills Plantation Circle Troutman NC 28166

SITE DIRECTIONS Hwy 21 S, left on Houston Rd. Right into Georgia Mills Plantation

SUBDIVISION Georgia Mills Plantation BLOCK / SECTION N/A LOT # 14 LOT AREA 0.57 acres DESIGN FLOW 480 gpd L.T.A.R. 0.25

Septic Tank Existing Gallons: STB ____ Date ____

Pump Tank Existing Gallons: P T ____ Date ____

Pump Make ____ Model ____ Serial # ____

No. Nitrification Fields: 1 No. Lines 4 Linear Feet 320

Trench Width 24" Max. Trench Bottom Depth Existing Gravel Depth N/A

☐ New System ☐ Repair ☐ Expansion System Type I II III (IV) V VI

System Description: Low Pressure Panel Block

Repair System Description: Low Pressure Panel Block

Maintenance Agreement Required ☑ YES ☐ NO

☐ GRAVITY ☑ PRESSURE

☑ Residence No. Bedrooms 4

☐ Business No. Persons ____

☑ Other Garage No. Employees ____

☐ Slab ☐ Crawl Space


☐ Basement w/plumbing ☐ Basement w/o plumbing

Water Supply: ☑ Private ☐ Public ☐ Community


Comments / Conditions

- Garage shall maintain at least a 5' setback btw foundation and all components of existing septic system as well as future repair area

INITIAL SITE SKETCH

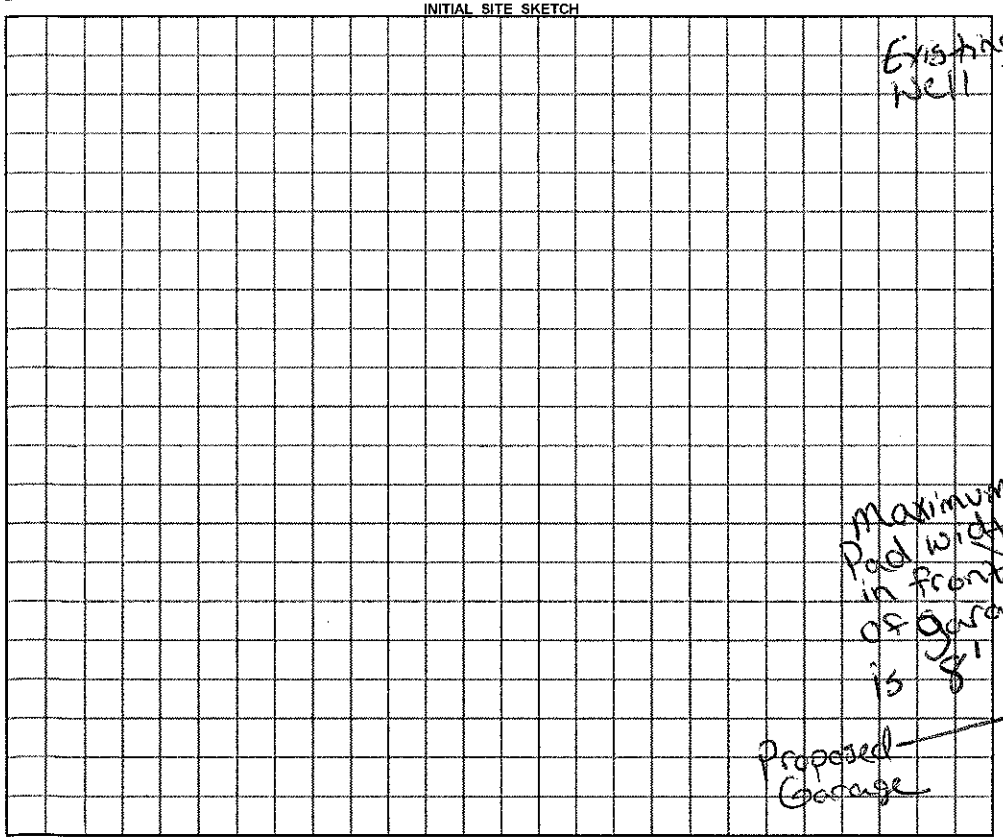

AS BUILT SKETCH

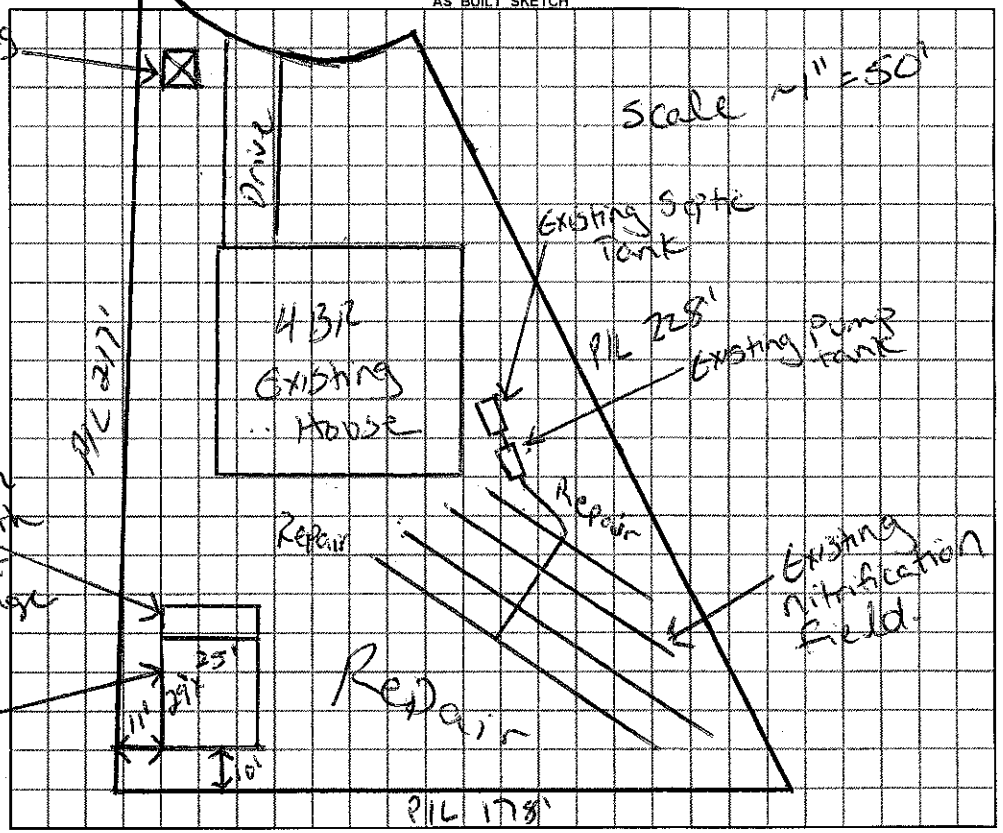

Permit can be suspended or revoked if any false information is supplied toward securing the permit / any unauthorized changes are made to the site / any unauthorized changes are made in the installation of the system.

☐ ***IMPROVEMENT PERMIT*** *with plat valid without expiration.* ☑ ***IMPROVEMENT PERMIT*** *with ~~plat valid without expiration~~ site plan valid 60 mo.* ☐ ***AUTHORIZATION TO CONSTRUCT*** valid for period equal to IMPROVEMENT PERMIT--not to exceed 60 mo.

Owner / Applicant Signature: Richard Zylak Date 7/13/12 Installed by: ____

IMPROVEMENT PERMIT by: ____ ***REHS*** Date ____ OPERATION PERMIT by: ____ ***REHS*** Date ____

AUTHORIZATION TO CONSTRUCT by: ____ ***REHS*** Date ____ Existing System Inspected by: Justin Henderson ***REHS*** Date 7-12-12

YOU SHOULD CONTACT A LOCATOR SERVICE PRIOR TO ANY EXCAVATION

White Copy -- Environmental Health YELLOW COPY (Final) Owner / Applicant PINK COPY (Initial) Owner / Applicant