IREDELL COUNTY HEALTH DEPARTMENT

STATESVILLE 704-878-5305 MOORESVILLE 704-664-5281

IMPROVEMENT PERMIT / AUTHORIZATION TO CONSTRUCT / OPERATION PERMIT / EXISTING SYSTEM INSPECTION

PERMIT # 163461 PIN # 4750715202 DATE 10-22-2010

OWNER or APPLICANT Susan & Richard Zylak PHONE: Business 803 785 3357 Home: 704 508-1175

OWNER or APPLICANT ADDRESS 122 Mills Plantation Circle Troutman NC 28166

LOCATION / DIRECTIONS US 21 Hwy 115 TR Shepherd TL Houston TL Colonial Congress TR Mills Plant. on left. #122

SUBDIVISION GA Mills Plantation BLOCK / SECTION LOT # 57 LOT AREA .17Ac DESIGN FLOW 480gpd L.T.A.R. .25

Septic Tank 1000 Gallons: STB Date

Pump Tank Gallons: PT Date

Pump Make Model Serial #

Nitrification Field No Fields 1 No Lines 5 Linear Feet 480

Trench Width 36" Max. Trench Bottom Depth 36" Gravel Depth N/A

☒ New System ☐ Repair ☐ Expansion System Type I (II) III IV V VI

System Description: Gravity - 25% Reduction

Repair System Description: * LPPPBPS

Maintenance Agreement Required ☐ YES ☒ NO

☒ GRAVITY ☐ PRESSURE

☒ Residence No. Bedrooms 4

☐ Business No. Persons

☐ Other No. Employees

☐ Slab ☐ Crawl Space


☐ Basement w/plumbing ☐ Basement w/o plumbing

Water Supply: ☒ Private ☐ Public ☐ Community

Comments / Conditions: * Repair per original plan.

#W

INITIAL SITE SKETCH

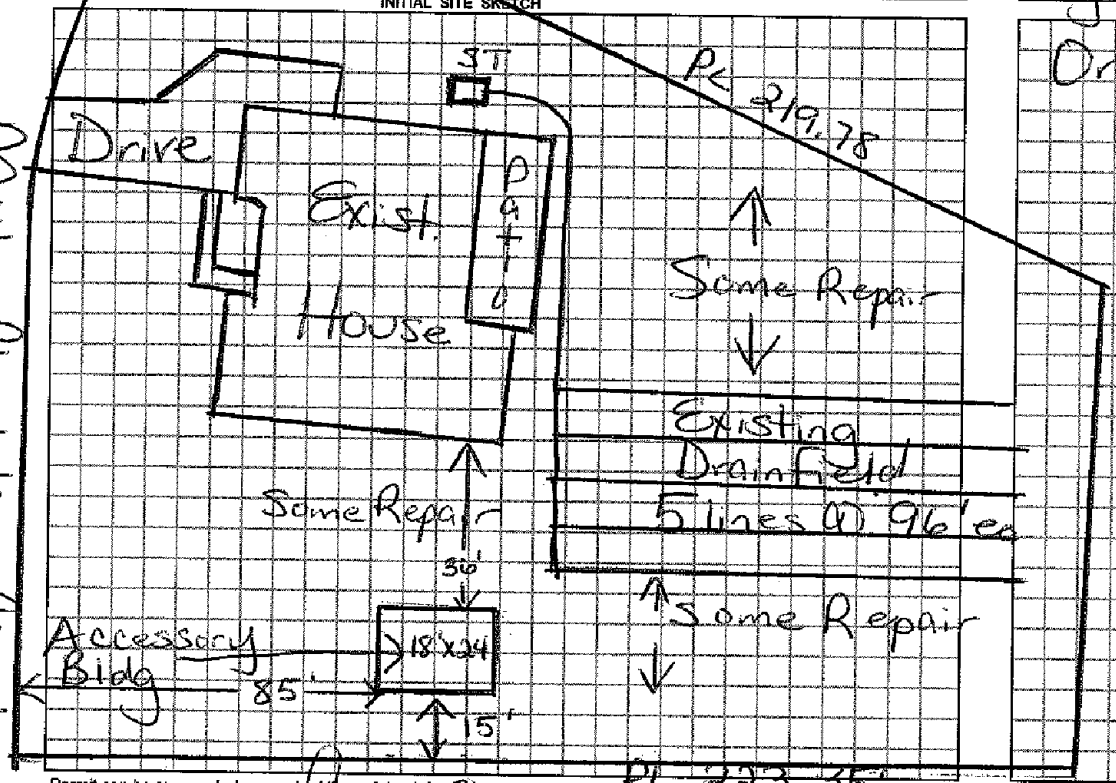

Comments / Conditions: Existing Septic System appears to be Functioning Okay at time of inspection. Accessory Bldg. should not impact Septic System. Must keep Bldg. at least 5ft. from Septic.

AS BUILT SKETCH

Original Septic System installed 2/11/2010

Permit can be suspended or revoked if any false information is supplied toward securing the permit / any unauthorized changes are made to the site / any unauthorized changes are made in the installation of the system.

☐ *IMPROVEMENT PERMIT w / plat valid without expiration.* ☐ *IMPROVEMENT PERMIT w / site plan valid for 60 mos.* ☐ *AUTHORIZATION TO CONSTRUCT valid for period equal to IMPROVEMENT PERMIT-not to exceed 60 mo.*

Owner / Applicant Signature: X Susan Zylak Date 10/25/10

Improvement Permit by: Date

Authorization to Construct by: Date

YOU SHOULD CONTACT A LOCATOR SERVICE PRIOR TO ANY EXCAVATION.

Installed by: Rowan Septic

Operation Permit by: Date:

Existing System Inspected by: Maria H. Dolan RFHS Date 10/22/2010

WHITE COPY Environmental Health YELLOW COPY (Final) Owner / Applicant PINK COPY (Initial) Owner / Applicant