IREDELL COUNTY HEALTH DEPARTMENT

STATESVILLE 704-878-5305 MOORESVILLE 704-664-5281

IMPROVEMENT PERMIT / AUTHORIZATION TO CONSTRUCT / OPERATION PERMIT / EXISTING SYSTEM INSPECTION

PERMIT# 14232 PIN# 4750 71 6407 DATE 3/30/07

OWNER OR APPLICANT Edwards Const. Inc. PHONE: Business 704-753-5310 Home

ADDRESS 2419 Henry Bowman Rd. Monroe, NC 28110

LOCATION 115 N TR Shepherd Rd. TL Houston Rd TL Colonial Congress Way TR Mills Plantation Circle on R Corner

SUBDIVISION GA MILLS PLANTATION SECTION 1 LOT 10 LOT AREA .714 SITE CLASS. PSI DESIGN FLOW 480 L.T.A.R. ~~3/5~~ 4

Septic Tank: 1000 Gallons; STB 794 Date 12/9/07

Pump Tank: 1000 Gallons; PT 283 Date 12/2/07

Pump Make: Goulds Model WE0-3122 Serial No. 11079240

Nitrification Field: No Fields 1 Square Feet 960 Linear Feet ~~320~~

No. Lines 4 Trench Width 3 Max Trench Bottom Depth 3

☒ New System ☐ Repair ☐ Expansion System Type: I II III (IV) V VI

System Description: LP - 16" PPBPS

Repair System Description: SAME TYPE

Maintenance Agreement Required: ☒ Yes ☐ No

☒ House/Mod. Home No. Bedrooms ~~3~~ 4 Water Supply:

☐ Mobile Home No. Persons ☒ Individual

☐ Business No. Employees ☐ Public

☐ Other ☐ Community


Gravel Depth NA ☐ Gravity ☒ Pressure ☐ Slab ☒ Crawl Space ☐ Basement w/plumbing ☐ Basement wo/plumbing

Comments:/Conditions:


LOT 10 COLONIAL CONGRESS WAY

Comments:/Conditions:

INITIAL SITE SKETCH

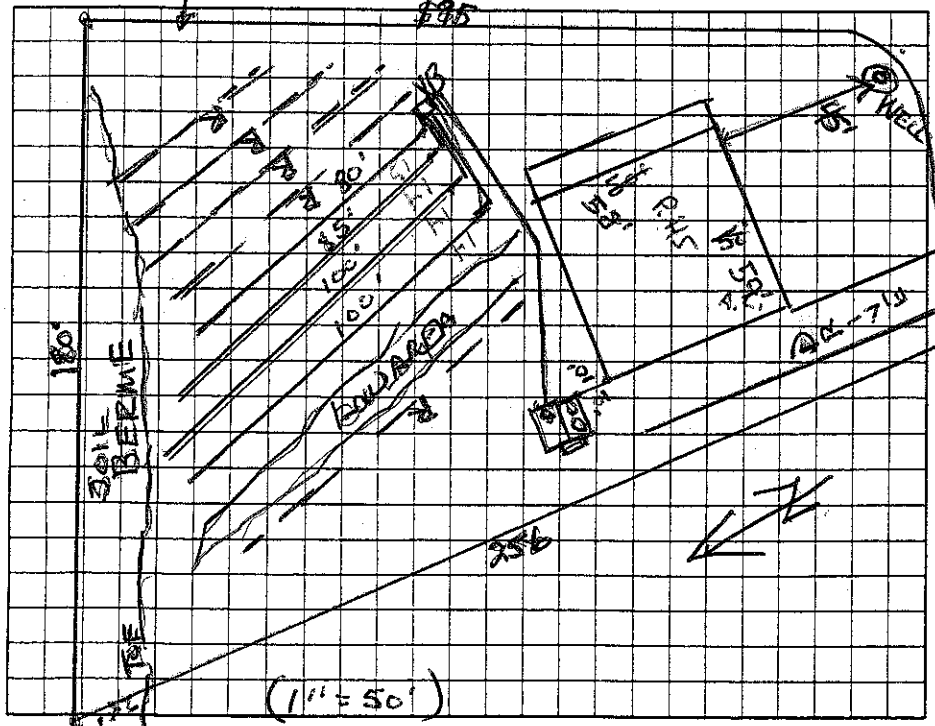

AS BUILT SKETCH

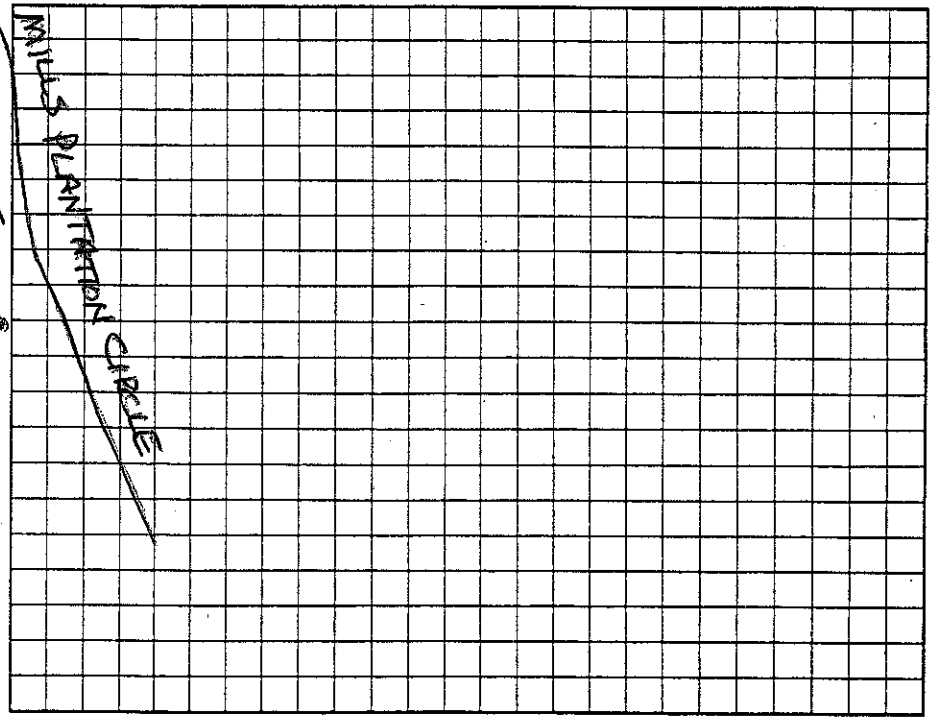

Permit can be suspended or revoked if any false information is supplied toward securing the permit/any unauthorized changes are made to the site/any unauthorized changes are made in the installation of the system. Improvement Permit with plat valid without expiration. ☐ Improvement Permit with site plan valid for sixty months ☒ Authorization to Construct is valid for a period equal to that of Improvement Permit – not to exceed sixty months.

Signed: Ann A. Edwards date 5-1-07

Improvement Permit by: Wesley Sparks RS date 3/30/07

Authorization to Construct by: Anthony Coker date 8/27/07

Installed by: A-1 BACKHOE

Operation Permit by: Wesley Sparks RS. date 10/6/09

Existing System Inspection by: date

HEALTH DEPT. COPY: WHITE OWNER COPY (FINAL): YELLOW OWNER COPY (INITIAL): PINK