IREDELL COUNTY HEALTH DEPARTMENT - *ENVIRONMENTAL HEALTH* ☐ STATESVILLE OFFICE 704-878-5305 ☒ MOORESVILLE OFFICE 704-664-5281

IMPROVEMENT PERMIT / AUTHORIZATION TO CONSTRUCT / OPERATION PERMIT / EXISTING SYSTEM INSPECTION

PERMIT # 146392 PIN # 4750-71-8016 DATE 12-7-11

OWNER ADAMS HOMES APPLICANT: SAME PHONE: Home/Cell # 704-947-6118 Business # —

SITE ADDRESS 140 Mills Plantation OWNER / APPLICANT ADDRESS 10115 Kincey Ave. #1100 Huntersville

SITE DIRECTIONS SHEPHERD, TL HOUSTON, TL GA MILLS, TL, ON R

SUBDIVISION GA MILLS BLOCK / SECTION LOT # 42 LOT AREA .75 AC DESIGN FLOW 360 L.T.A.R. .3

Septic Tank 1000 Gallons: STB Date

Pump Tank 1000 Gallons: P T Date

Pump Make Model Serial #

No. Nitrification Fields: 1 No. Lines 4 Linear Feet 300'

Trench Width 36" Trench Bottom Depth 36"

☒ New System ☐ Repair ☐ Expansion System Type I II (III) IV V VI

System Description: PM-75% REDUCTION

Repair System Description: LP-PANEL

Maintenance Agreement Required ☐ YES ☒ NO

Gravel Depth ☐ GRAVITY ☒ PRESSURE

☒ Residence No. Bedrooms 3

☐ Business No. Persons

☐ Other No. Employees

☒ Slab ☐ Crawl Space

☐ Basement w/plumbing ☐ Basement w/o plumbing

Water Supply: ☒ Private ☐ Public ☐ Community

Comments / Conditions * FOLLOW PLAN SPECS

INITIAL SITE SKETCH

SEE PLAN FROM MICHAEL ATHANAS & ASSOCIATES APPROVED BY CHD *

AS BUILT SKETCH

INSTALLED AS SHOWN ON PLAN

E-MAILED 1-12-12 ADAMS HOMES

Permit can be suspended or revoked if any false information is supplied toward securing the permit / any unauthorized changes are made to the site / any unauthorized changes are made in the installation of the system.

☐ *IMPROVEMENT PERMIT with plat valid without expiration.* ☐ *IMPROVEMENT PERMIT with ~~plat valid without expiration.~~ site plan valid 60 mo.* ☒ *AUTHORIZATION TO CONSTRUCT* valid for period equal to IMPROVEMENT PERMIT--not to exceed 60 mo.

Owner / Applicant Signature: [signature] Date 12/19/11

IMPROVEMENT PERMIT by: [signature] REHS Date 12-7-11

AUTHORIZATION TO CONSTRUCT by: [signature] REHS Date 12-7-11


YOU SHOULD CONTACT A LOCATOR SERVICE PRIOR TO ANY EXCAVATION

Installed by: ROWAN SEPTIC

OPERATION PERMIT by: [signature] REHS Date 12-29-11

Existing System Inspected by: REHS Date

White Copy -- Environmental Health YELLOW COPY (Final) Owner / Applicant PINK COPY (Initial) Owner / Applicant

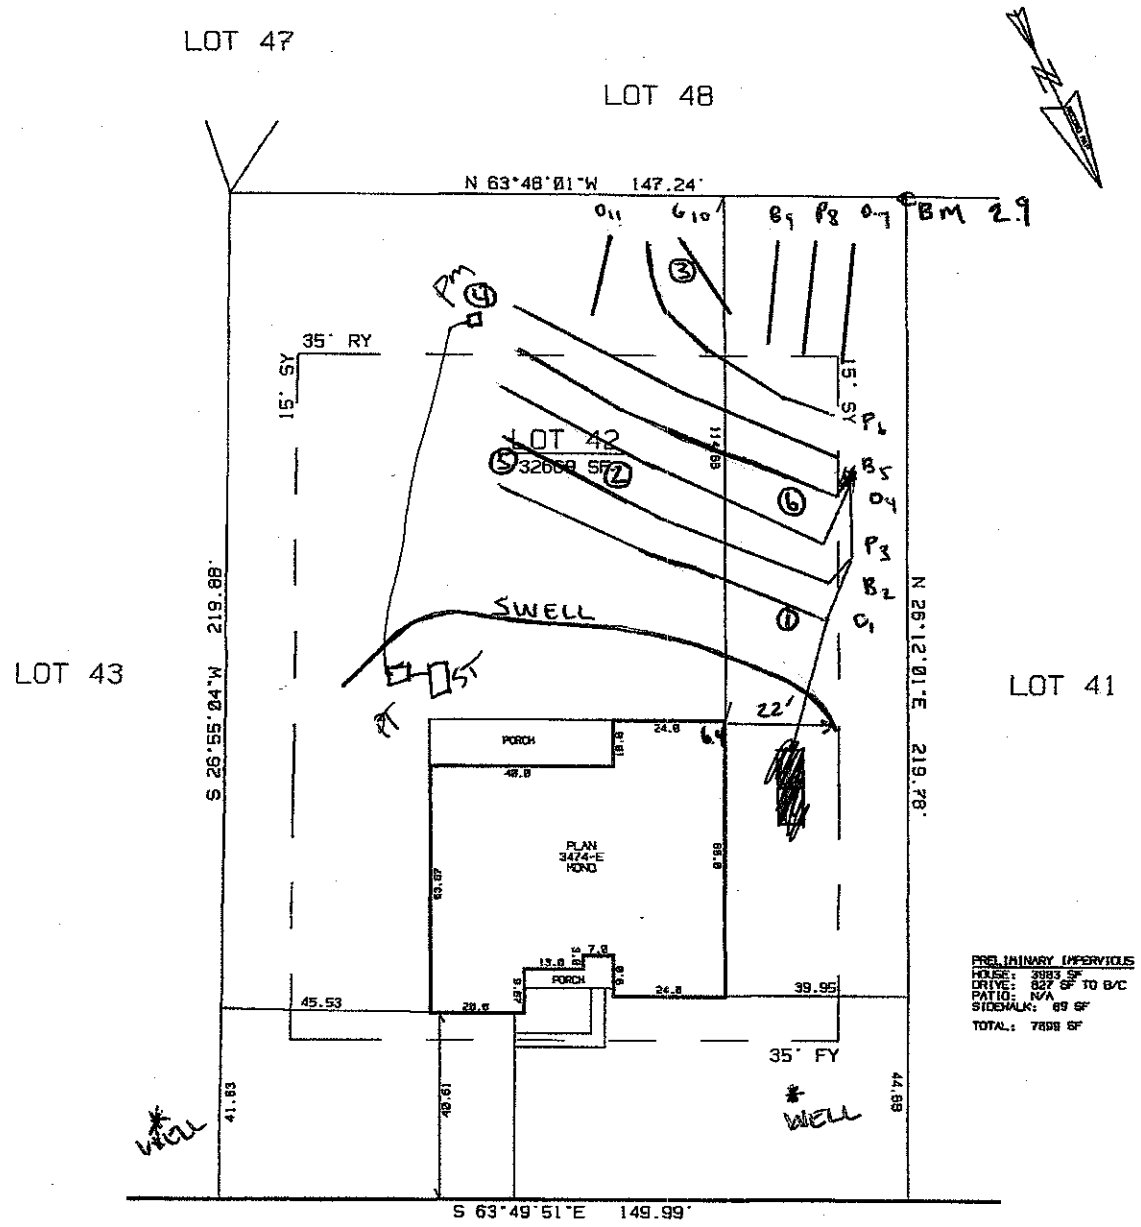

MILLS PLANTATION CIRCLE

50' PUBLIC R/W

NOTE: U.G. UTILITIES IN AREA SERVING OTHER PROPERTIES.
THIS PROPERTY SUBJECT TO ANY EASEMENTS OR RIGHT-OF-WAYS OF RECORD.
SEE RECORD PLAT FOR FURTHER NOTES.

IPF - IRON PIN FOUND
IPS - IRON PIN SET
BC - BACK OF CURB
CM - CONCRETE MONUMENT
PSDE - PUBLIC STORM DRAIN EASEMENT
S.T. - SIGHT TRIANGLE

SCALE - 1" = 40'

0 20 40 60 80

ADAMS HOMES

PLOT PLAN

OF
140 MILLS PLANTATION CIRCLE
LOT 42 OF GEORGIA MILLS PLANTATION (REVISED)
BARRINGER TOWNSHIP, IREDELL COUNTY, N.C.

MAP RECORDED IN BOOK 54
AT PAGE 82

ADGEO#9
DSK AD#20 GM42
REVISED: 09/23/11
DRAWN: CLJ