IREDELL COUNTY HEALTH DEPARTMENT

STATESVILLE 704-878-5305 MOORESVILLE 704-664-5281

IMPROVEMENT PERMIT / AUTHORIZATION TO CONSTRUCT / OPERATION PERMIT / EXISTING SYSTEM INSPECTION

PERMIT# 14128 PIN# 4750 71 8326.000 DATE 4/2/07

OWNER OR APPLICANT Edwards Const. Co. PHONE: Business 704-753-5310 Home

ADDRESS 2419 Henry Boucom Rd. Monroe NC. 28110

LOCATION 115 N TR Shepherd Rd TL Houston Rd. TL Colonial Congress Way TL Mills Plantation Circle, lot on L corner

SUBDIVISION CAMILLS PLANTATION / SECTION 1 LOT 40 LOT AREA .8 SITE CLASS. PS DESIGN FLOW 480 L.T.A.R. .3

Septic Tank: 1000v Gallons; STB 794 Date 12/9/07
Pump Tank: Gallons; PT Date
Pump Make: Model Serial No.
Nitrification Field: No Fields 1 Square Feet 1200 Linear Feet 400
No Lines 5@80' Trench Width 3' Max Trench Bottom Depth 3'

X New System ☐ Repair ☐ Expansion System Type: I II III IV V VI
System Description: GRAVITY - 25% REDUCED
Repair System Description: PRESSURE - 25% REDUCED
Maintenance Agreement Required: ☐ Yes X No

X House/Mod. Home No. Bedrooms 4
☐ Mobile Home No. Persons
☐ Business No. Employees
☐ Other


Water Supply: X Individual ☐ Public ☐ Community

Gravel Depth 3' X Gravity ☐ Pressure ☐ Slab X Crawl Space ☐ Basement w/plumbing ☐ Basement wo/plumbing

Comments/Conditions:

COLONIAL CONGRESS WAY

INITIAL SITE SKETCH

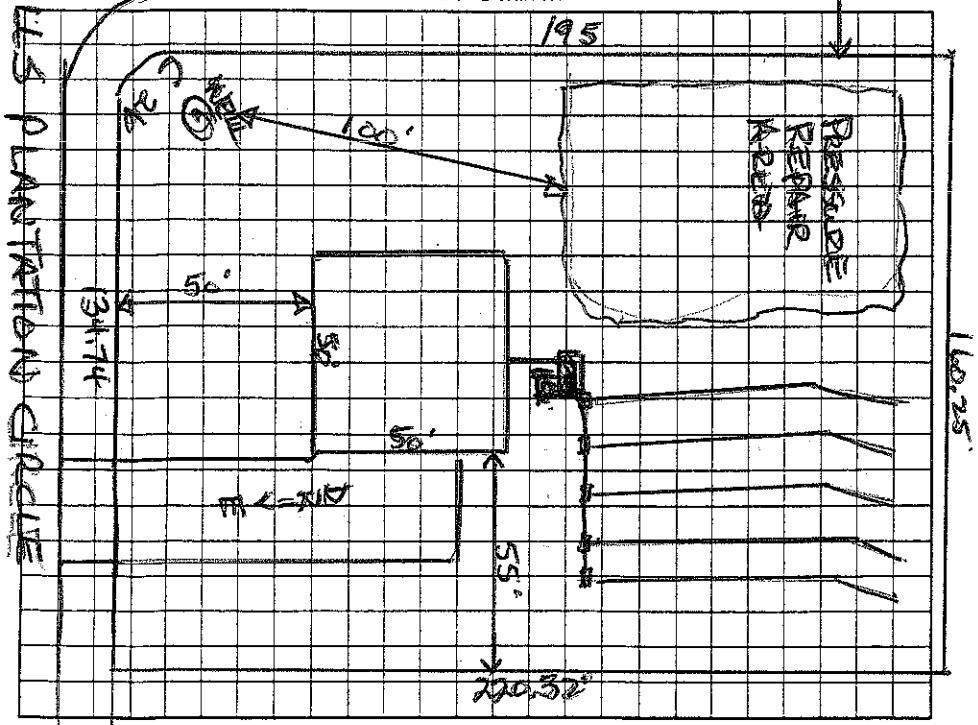

Comments/Conditions:

IQ4VX - INSTALLED
NO DROP BOXES - END TO END

AS BUILT SKETCH

Permit can be suspended or revoked if any false information is supplied toward securing the permit/any unauthorized changes are made to the site/any unauthorized changes are made in the installation of the system. Improvement Permit with plat valid without expiration ☐ Improvement Permit with site plan valid for sixty months ☐ Authorization to Construct is valid for a period equal to that of Improvement Permit – not to exceed sixty months.

Signed: Donald Edwards date 5-1-07 Installed by: A-1 Backhoe

Improvement Permit by: Wesley Sparks R.S. date 4/2/07 Operation Permit by: Wesley Sparks R.S. date 1/25/08

Authorization to Construct by: John E Alpi date 6/27/07 Existing System Inspection by: date

HEALTH DEPT. COPY: WHITE OWNER COPY (FINAL): YELLOW OWNER COPY (INITIAL): PINK