4750789867

IREDELL COUNTY HEALTH DEPARTMENT

STATESVILLE 704-878-5305 MOORESVILLE 704-664-5281

IMPROVEMENT PERMIT / CERTIFICATE OF COMPLETION / OPERATION PERMIT / EXISTING SYSTEM INSPECTION

PROPERTY DESCRIPTION NO. 21135 DATE 5/30/95 TAX MAP NO. 46 B 53 Watershed: ☐ Yes ☒ No

OWNER OR CONTRACTOR Nathaniel Ramsey PHONE: Business _____ Home 528-9080

ADDRESS 228 Overcash Rd Troutman, NC.

LOCATION Overcash Rd, Os Dmitry off 115 TR on Overcash Rd. ~ 1 mile on (R) at Pin Oak Trees

SUBDIVISION NL/A BLOCK / SECTION _____ LOT _____ LOT AREA Existg SITE CLASS. _____ DESIGN FLOW _____ L.T.A.R. _____

Septic Tank: Existg Gallons; STB _____ Date _____

Pump Tank: _____ Gallons; PT _____ Date _____

Pump Make: _____ Model _____ Serial No. _____

Nitrification Field: No Fields ____ Square Feet Existg Linear Feet _____

No Lines _____ Trench Width _____ Max Trench Bottom Depth _____ Gravel Depth _____

☐ New System ☐ Repair System Type: ☒ I, II, III, IV, V, VI

System Description: Existg system

Repair System Description: _____

Maintenance Agreement Required: ☐ Yes ☒ No

☒ House/Mod. Home No. Bedrooms 3

☐ Mobile Home No. Bathrooms 2

☐ Business No. Employees ____

☐ Other _____


☐ Slab ☒ Crawl Space ☐ Basement w/plumbing ☐ Basement wo/plumbing

Water Supply:
☒ Individual
☐ Community
☐ Public


Comments:

Comments:
1974 - Cost of Comp - Fixed Bugenit for 3 BdRm Mobile Home

INITIAL SITE SKETCH

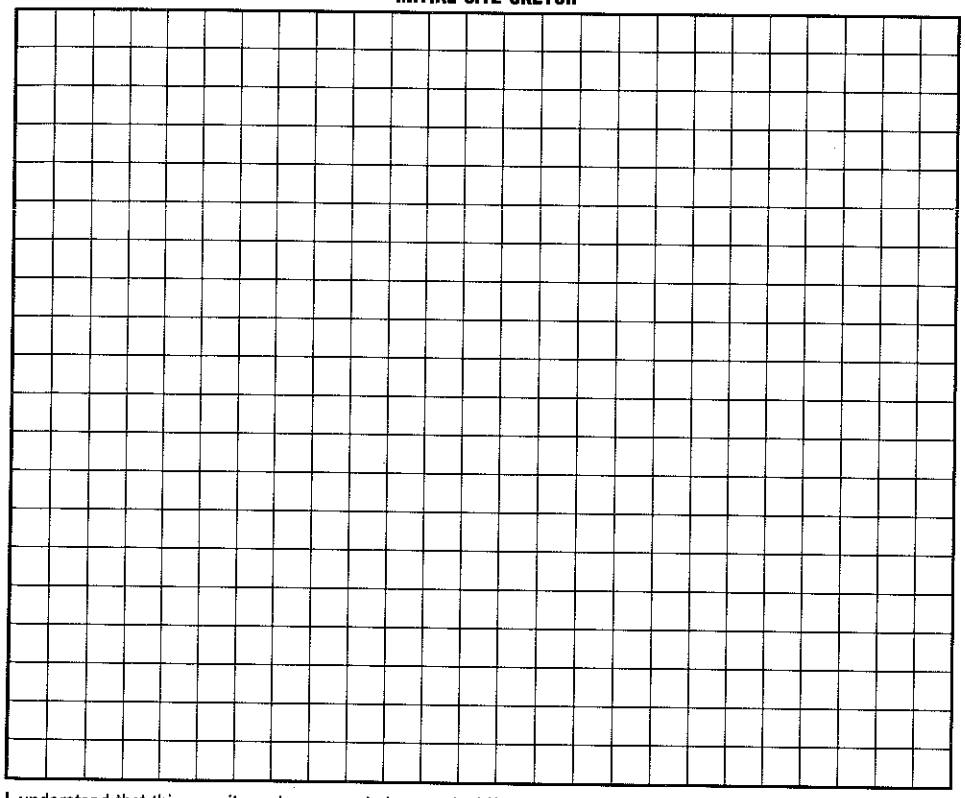

AS BUILT SKETCH

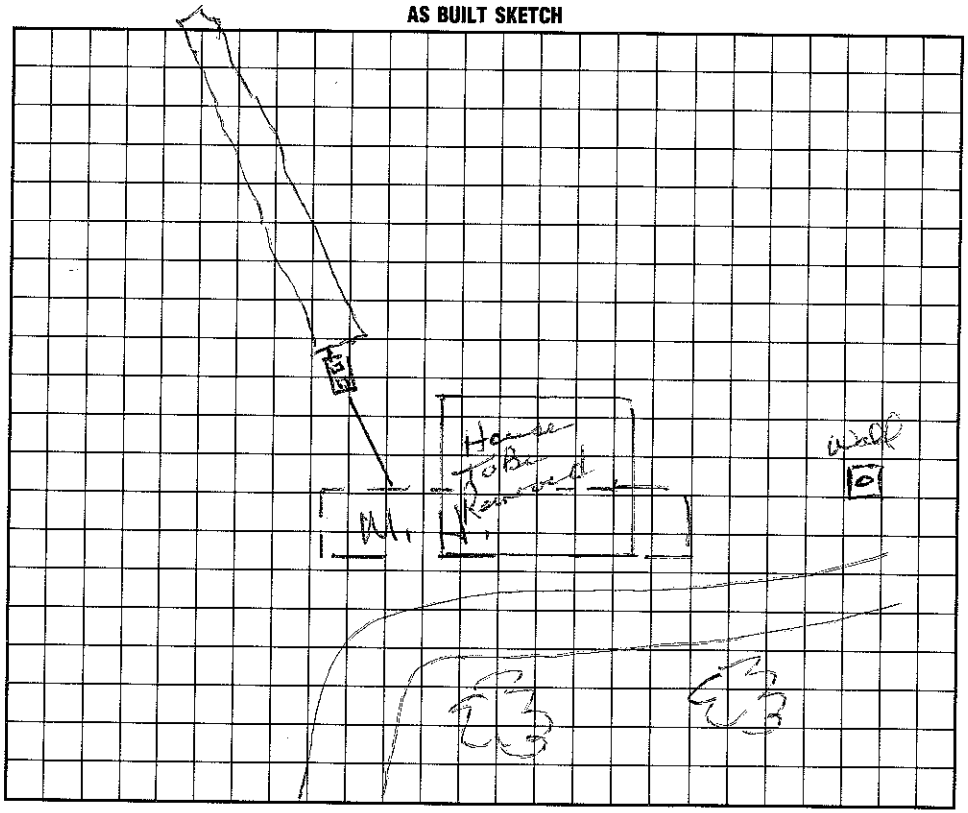

I understand that this permit can be suspended or revoked if any false information is supplied toward securing the permit/any unauthorized changes are made to the site/any unauthorized changes are made in the installation of the system. Improvement Permit is valid for 60 months from date of issuance.

Signed: _____

Improvement Permit by: _____ date _____

Existing System Inspection by: Wesley Sparks RS date 5/30/95

Installed by: _____

Certificate of Completion by: _____ date _____

Operation Permit by: _____ date _____

HEALTH DEPT. COPY: WHITE INSPECTION COPY (FINAL): GREEN OWNER COPY (FINAL): YELLOW INSPECTION COPY (INITIAL): PINK OWNER COPY (INITIAL): GOLD