IREDELL COUNTY HEALTH DEPARTMENT

STATESVILLE 704-878-5305 MOORESVILLE 704-664-5281

IMPROVEMENT PERMIT / CERTIFICATE OF COMPLETION / OPERATION PERMIT / EXISTING SYSTEM INSPECTION

PROPERTY DESCRIPTION NO. 19557 DATE 10/14/94 TAX MAP NO. 4G 3A 2 Watershed: ☐ Yes ☑ No

OWNER OR CONTRACTOR Edith Jane Pethel PHONE: Business 4750-79-0153 Home 662-6015

ADDRESS 776-804 White Oaks Rd. Mooresville, NC. 28115

LOCATION corner of Kendall Rd. of Basswood Dr.

SUBDIVISION Kendallwood BLOCK / SECTION ____ LOT 2 LOT AREA ~28,400 SITE CLASS. P DESIGN FLOW 240 L.T.A.R. .3

Septic Tank: 1000 Gallons; STB 821 Mull Date 9-29-94

Pump Tank: ____ Gallons; PT ____ Date ____

Pump Make: ____ Model ____ Serial No. ____

Nitrification Field: No Fields 1 Square Feet 800 Linear Feet 266

No Lines 2 Trench Width 36" Max Trench Bottom Depth 30" Gravel Depth 12"

☑ New System ☐ Repair System Type: I, II, III, IV, V, VI

System Description: CONV - DIST BOX

Repair System Description: ____

Maintenance Agreement Required: ☐ Yes ☑ No

☑ House/Mod. Home No. Bedrooms 2

☐ Mobile Home No. Bathrooms 2

☐ Business No. Employees ____

☐ Other ____


☐ Slab ☑ Crawl Space ☐ Basement w/plumbing ☐ Basement wo/plumbing

Water Supply: ☑ Individual ☐ Community ☐ Public


Comments: Trenches no deeper than 30" to trench bottom. Lines on slope contour.

Comments: Will not installed as of 11/4/94

INITIAL SITE SKETCH

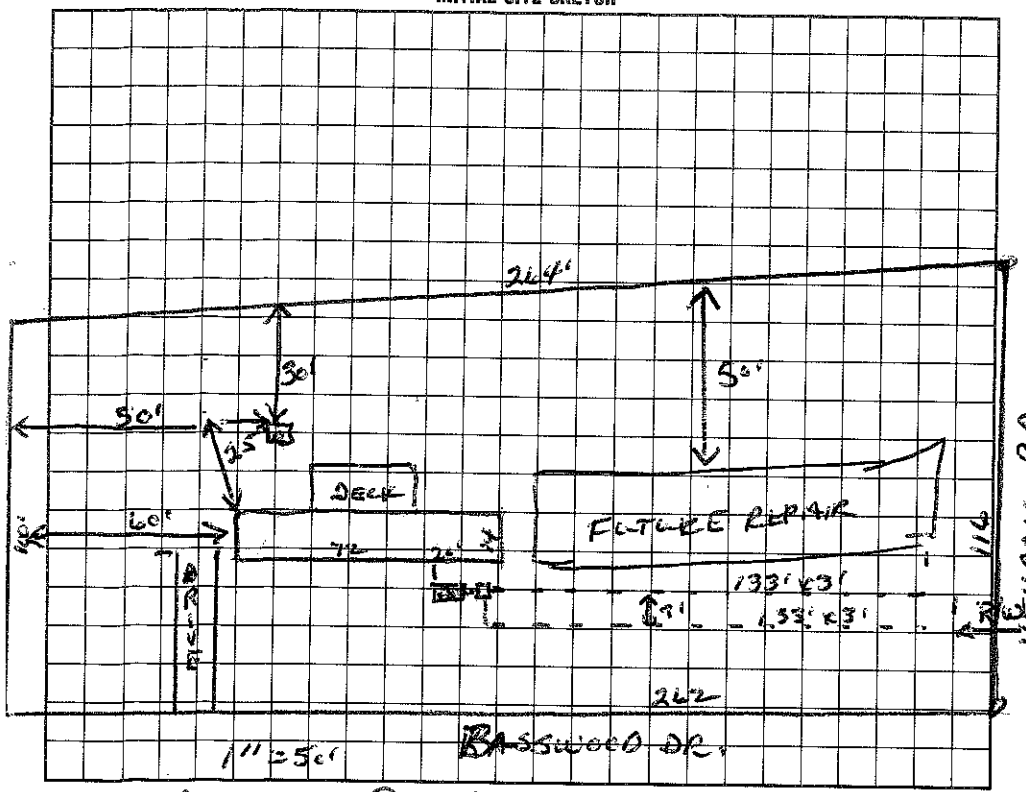

AS BUILT SKETCH

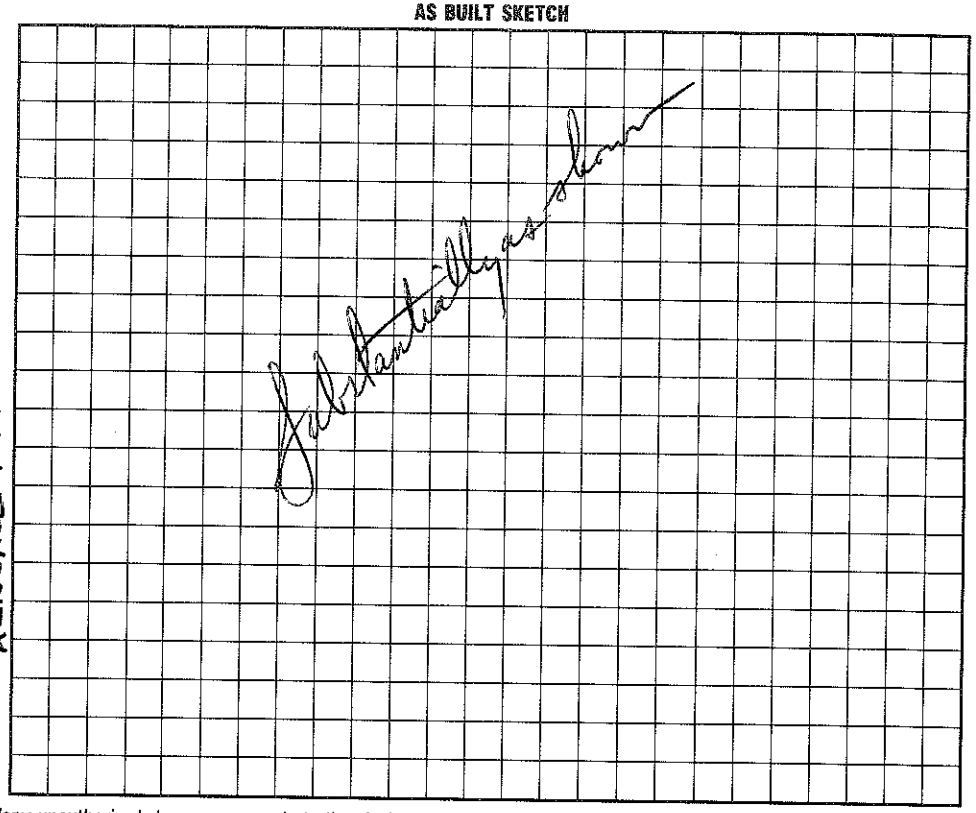

I understand that this permit can be suspended or revoked if any false information is supplied toward securing the permit/any unauthorized changes are made to the site/any unauthorized changes are made in the installation of the system. Improvement Permit is valid for 60 months from date of issuance.

Signed: [signature]

Improvement Permit by: [signature] RS date 10/19/94

Existing System Inspection by: ____ date ____

Installed by: Gary Miller G & M Enterprises

Certificate of Completion by: [signature] IRS date 11/4/94

Operation Permit by: ____ date ____

HEALTH DEPT. COPY: WHITE INSPECTION COPY (FINAL): GREEN OWNER COPY (FINAL): YELLOW INSPECTION COPY (INITIAL): PINK OWNER COPY (INITIAL): GOLD