# IREDELL COUNTY HEALTH DEPARTMENT

STATESVILLE 704-878-5305 MOORESVILLE 704-664-5281

4750792722

## IMPROVEMENT PERMIT / CERTIFICATE OF COMPLETION / OPERATION PERMIT / EXISTING SYSTEM INSPECTION

PROPERTY DESCRIPTION NO. 18113 DATE 3/30/94 TAX MAP NO. 4K A 15

OWNER OR CONTRACTOR Blanche Brown PHONE: Business _____ Home 528-3475

ADDRESS PO Box 1301 Troutman, NC 28166 Watershed: ☐ Yes ☐ No

LOCATION Owencash Rd., Oswalt Cmty TR on Owencash on (R) just before Kendall Rd

SUBDIVISION _____ BLOCK / SECTION _____ LOT _____ LOT AREA 1 Ac SITE CLASS. P DESIGN FLOW 240 L.T.A.R. .25

Septic Tank: 1000 Gallons; STB 358 Date 3/8/94

Pump Tank: _____ Gallons; PT _____ Date _____

Pump Make: _____ Model _____ Serial No. _____

Nitrification Field: No Fields 1 Square Feet 960 Linear Feet 320

No Lines 3 Trench Width 3' Max Trench Bottom Depth 36" Gravel Depth 12"

☑ New System ☐ Repair System Type: I, ☑ III, IV, V, VI

System Description: CONV - DBOX

Repair System Description: _____

Maintenance Agreement Required: ☐ Yes ☑ No

☑ House/Mod. Home No. Bedrooms 2

☐ Mobile Home No. Bathrooms 2

☐ Business No. Employees ____

☐ Other _____


☐ Slab ☐ Crawl Space ☐ Basement w/plumbing ☐ Basement wo/plumbing

Water Supply: ☑ Individual ☐ Community ☐ Public


Comments: TRENCH DEPTH NO GREATER THAN 36"
LINES ON SLOPE CONTOUR IN DIRECTION SITE WILL.

Comments:

INITIAL SITE SKETCH

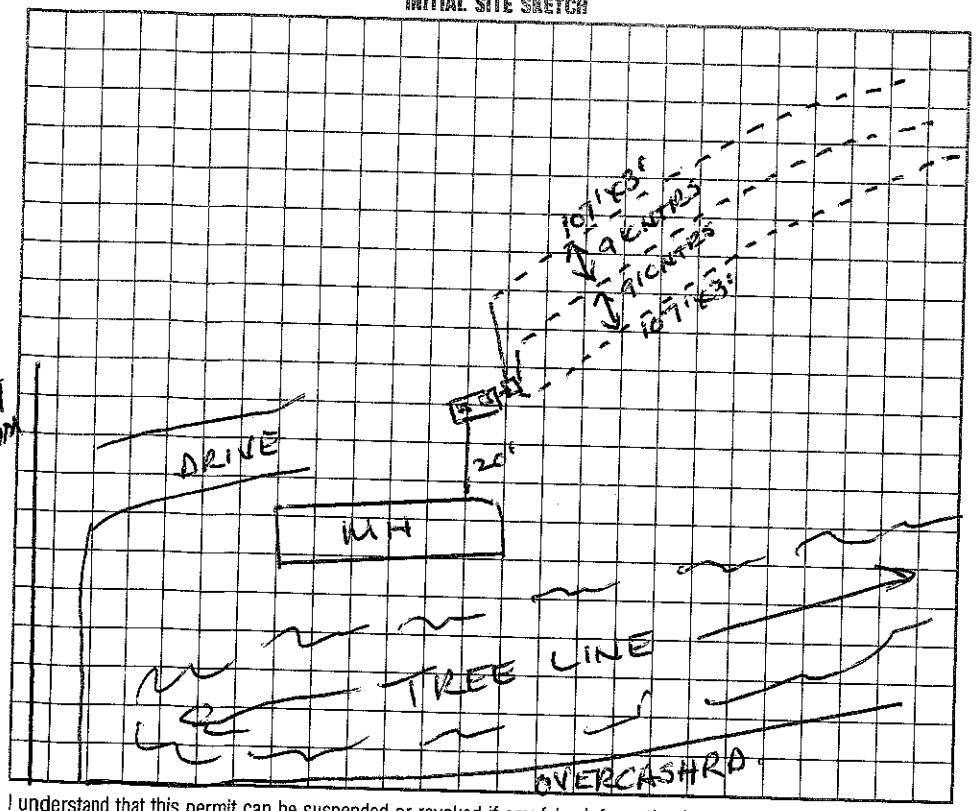


AS BUILT SKETCH

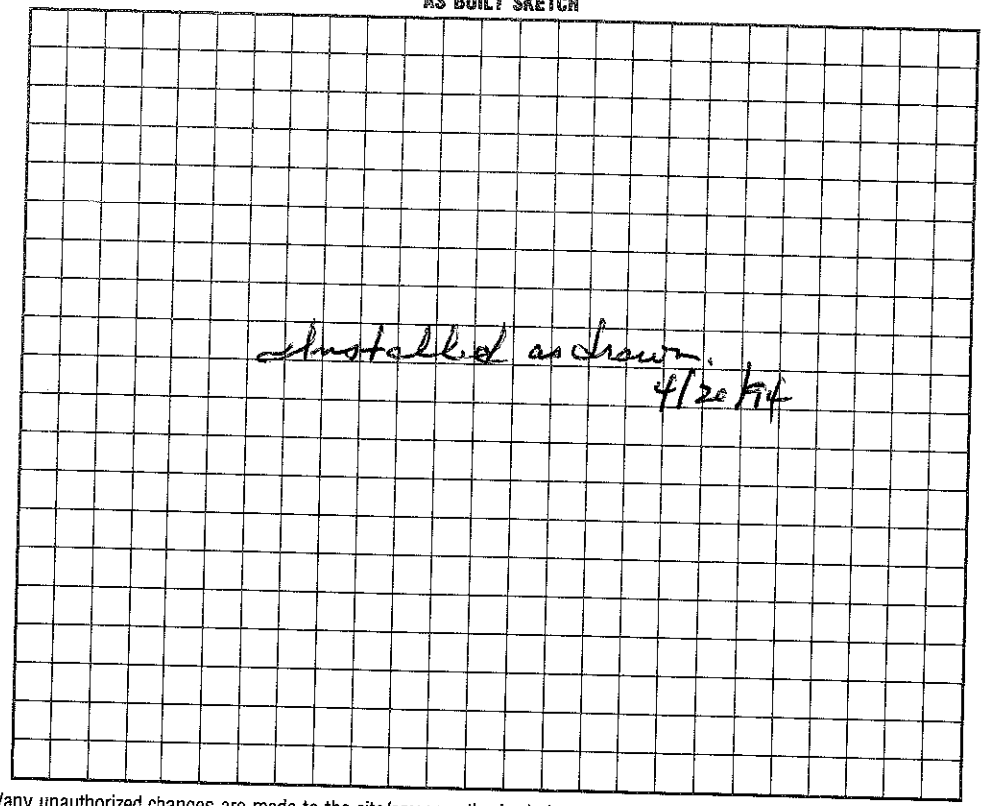


I understand that this permit can be suspended or revoked if any false information is supplied toward securing the permit/any unauthorized changes are made to the site/any unauthorized changes are made in the installation of the system. Improvement Permit is valid for 60 months from date of issuance.

Signed: Blanche Brown

Improvement Permit by: Wesley Sparks R.S. date 3/30/94

Existing System Inspection by: _____ date _____

Installed by: Dennis Salisbury

Certificate of Completion by: Wesley Sparks R.S. date 4/20/94

Operation Permit by: _____ date _____

HEALTH DEPT. COPY: WHITE INSPECTION COPY (FINAL): GREEN OWNER COPY (FINAL): YELLOW INSPECTION COPY (INITIAL): PINK OWNER COPY (INITIAL): GOLD