IREDELL COUNTY HEALTH DEPARTMENT

STATESVILLE 704-878-5305 MOORESVILLE 704-664-5281

IMPROVEMENT PERMIT / AUTHORIZATION TO CONSTRUCT / OPERATION PERMIT / EXISTING SYSTEM INSPECTION

(200) 300gpd

PERMIT# REPAIR PIN# ~~REPAIR~~ 4750 79 3093 DATE 1/28/99

OWNER OR CONTRACTOR JOHN McLEAN PHONE: Business 528-4528 Home 528 1010

ADDRESS (127 KENDALL RD.) OSWALT AMITY - TR OVERLASH - TL KENDALL RD. 1ST MAON LT.

LOCATION

SUBDIVISION — BLOCK / SECTION — LOT — LOT AREA — SITE CLASS. PS DESIGN FLOW 360 L.T.A.R. —

Septic Tank: EXISTING Gallons; STB Date

Pump Tank: Gallons; PT Date

Pump Make: Model Serial No.

Nitrification Field: No Fields 1 Square Feet 720 Linear Feet 60

No Lines 1 Trench Width 12' Max Trench Bottom Depth AS NEEDED Gravel Depth 24"

☐ New System ☑ Repair System Type: I, II, III, IV, V, VI

System Description:

Repair System Description: GRAVITY CONVENTIONAL

Maintenance Agreement Purchased ☐ Yes ☐ No

☐ House/Mod. Home ☑ Mobile Home ☐ Business ☐ Other

No. Bedrooms 3 No. Bathrooms 2 No. Employees

☐ Slab ☐ Crawl Space ☐ Basement w/plumbing ☐ Basement wo/plumbing


Water Supply: ☑ Individual ☐ Public ☐ Community

Comments/Conditions:


BULL RUN VALVE

Comments/Conditions:

INITIAL SITE SKETCH

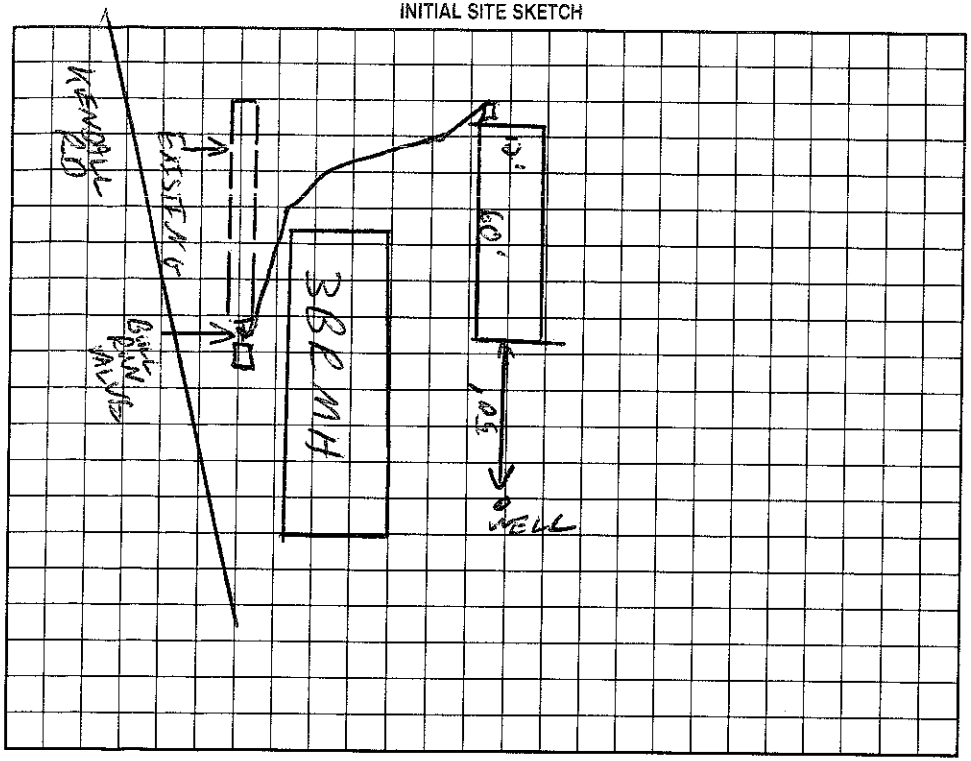

AS BUILT SKETCH

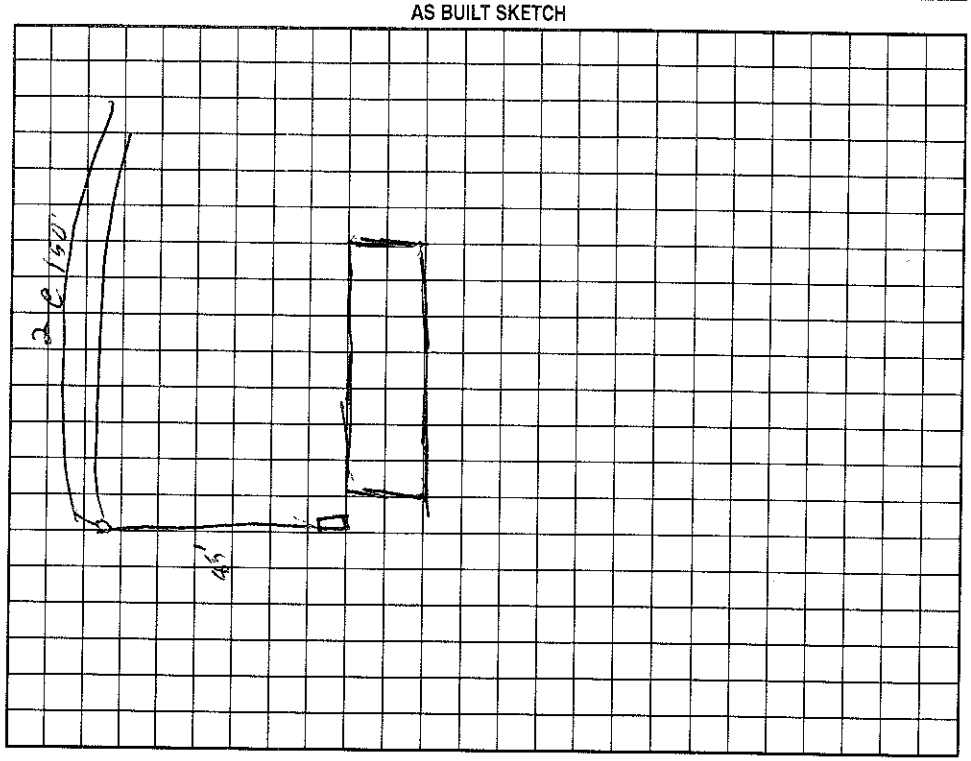

Permit can be suspended or revoked if any false information is supplied toward securing the permit/any unauthorized changes are made to the site/any unauthorized changes are made in the installation of the system. Improvement Permit with plat valid without expiration. Improvement Permit with site plan valid for sixty months. Authorization to Construct is valid for a period equal to that of Improvement Permit – not to exceed sixty months.

Signed: John McLean 1-29-99 date Installed by: A1 BACKHOE

Improvement Permit by: C. [signature] RS date 1/28/99 Operation Permit by: C. [signature] RS date 2/22/99

Authorization to Construct by: C. [signature] RS date 1/28/99 Existing System Inspection by: date

HEALTH DEPT. COPY: WHITE OWNER COPY (FINAL): YELLOW OWNER COPY (INITIAL): PINK