IREDELL COUNTY HEALTH DEPARTMENT

STATESVILLE 704-878-5305 MOORESVILLE 704-664-5281

IMPROVEMENT PERMIT / AUTHORIZATION TO CONSTRUCT / OPERATION PERMIT / EXISTING SYSTEM INSPECTION

PERMIT# 083635 PIN# 4750795667 DATE 9/14/99

OWNER OR CONTRACTOR Jack Gray PHONE: Business Home 528-0848

ADDRESS 105 Winbrook Dr Troutman

LOCATION Hwy 21 N TR Ostwalt-Amity TR Overcash TL Winalbrook on L

SUBDIVISION Winalbrook BLOCK / SECTION LOT LOT AREA .75 Acre SITE CLASS PS DESIGN FLOW 240gpd L.T.A.R. Existing

Septic Tank: 1000 Gallons; STB Date

Pump Tank: Gallons; PT Date

Pump Make: Model Serial No.

Nitrification Field: No Fields 2 Square Feet Existing Linear Feet

No Lines 4 Trench Width Max Trench Bottom Depth Gravel Depth

☐ New System ☐ Repair System Type: I, II, III, IV, V, VI Existing

System Description: Gravity - Conv.

Repair System Description:

Maintenance Agreement Required: ☐ Yes ☐ No

☐ House/Mod. Home No. Bedrooms 2+S

☒ Mobile Home No. Bathrooms 2

☐ Business No. Employees

☐ Other


☐ Slab ☒ Crawl Space ☐ Basement w/plumbing ☐ Basement wo/plumbing

Water Supply: ☒ Individual ☐ Public ☐ Community


Comments:/Conditions: Existing System appears to be functioning okay at time of inspection, No problems were Noticed.

Comments:/Conditions: Repair done 2/99. Upgrading from SW to DW, sized for 2 Bedroom + Study.

INITIAL SITE SKETCH Not to Scale

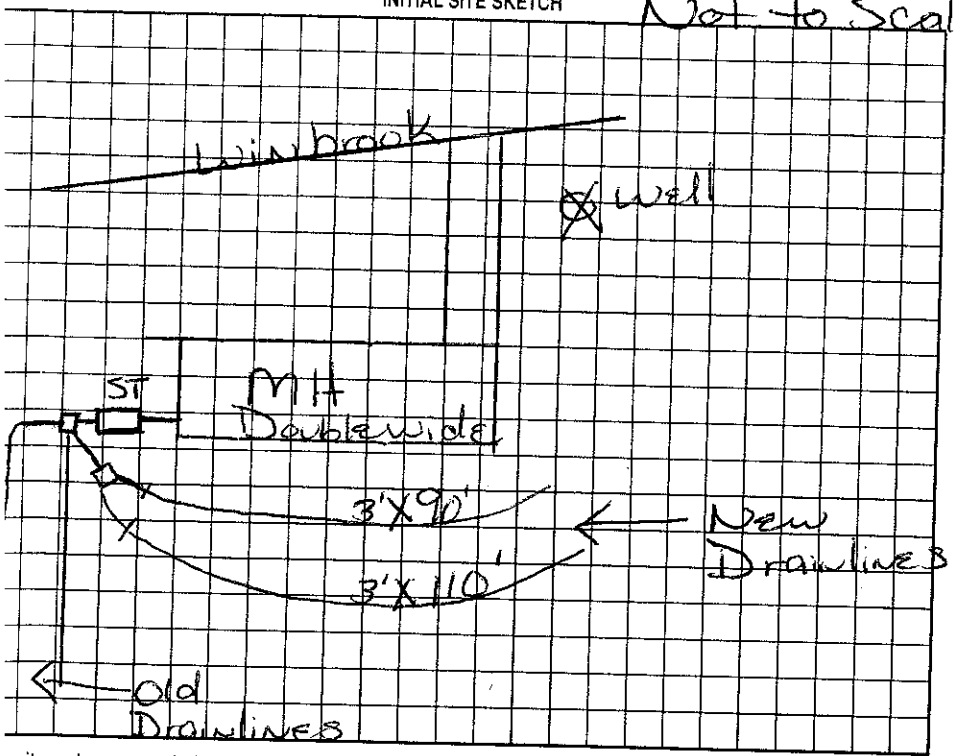

AS BUILT SKETCH

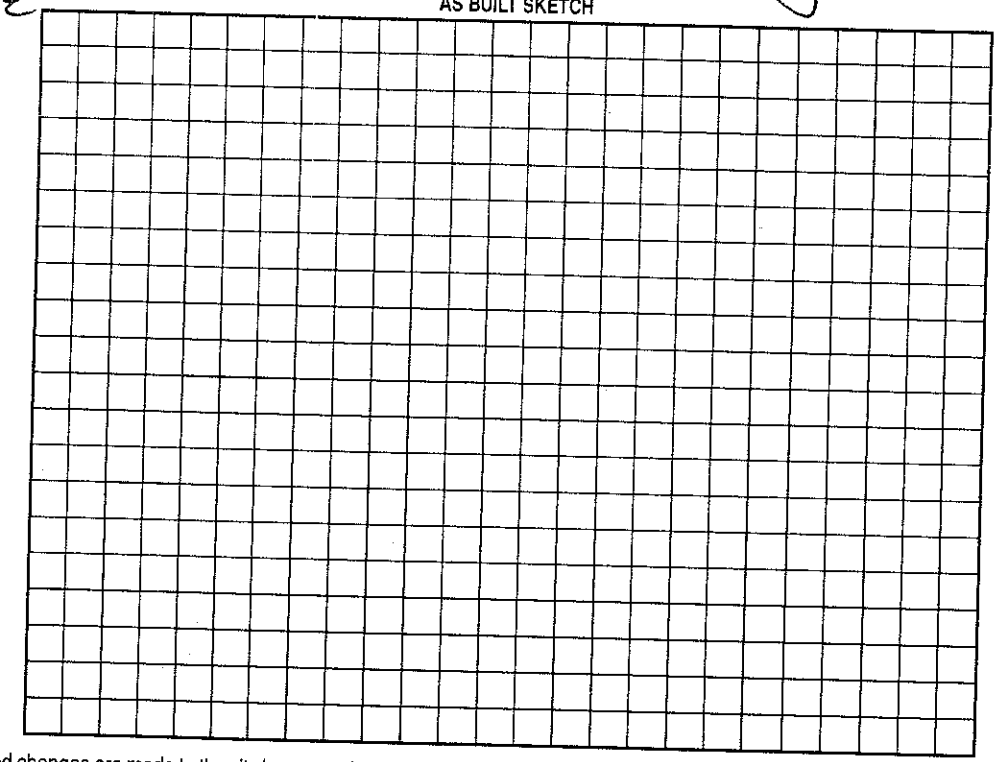

rmit can be suspended or revoked if any false information is supplied toward securing the permit/any unauthorized changes are made to the site/any unauthorized changes are made in the installation of the system. Improvement rmit with plat valid without expiration. Improvement Permit with site plan valid for sixty months. Authorization to Construct is valid for a period equal to that of Improvement Permit – not to exceed sixty months.

ned: Larry Mitchell date Installed by:

rovement Permit by: Marian H Dotson RS date 9/14/99 Operation Permit by: date

horization to Construct by: date Existing System Inspection by: Marian H Dotson RS date 9/14/99

HEALTH DEPT. COPY: WHITE OWNER COPY (FINAL): YELLOW OWNER COPY (INITIAL): PINK