4750 796257

IREDELL COUNTY HEALTH DEPARTMENT

STATESVILLE 704-878-5305 MOORESVILLE 704-664-5281

IMPROVEMENT PERMIT / CERTIFICATE OF COMPLETION / OPERATION PERMIT / EXISTING SYSTEM INSPECTION

PROPERTY DESCRIPTION NO. 17099 DATE 9/27/93 TAX MAP NO. 4G-B-74

OWNER OR CONTRACTOR DALE LIPE PHONE: Business _____ Home 528-0956

ADDRESS Rt 1 Box 499 TROUTMAN, NC. 28166

LOCATION OVERCASH ON (R) JUST PAST KENDALL RD. TO TRAILER ON (R) IN FIELD

SUBDIVISION _____ BLOCK / SECTION _____ LOT _____ LOT AREA _____ SITE CLASS. _____ L.T.A.R. _____

Water Supply: ☑ Individual ☐ Community ☐ Public

Septic Tank: 1000 Gallons; STB 782 Date 8/25/93

Pump Tank: _____ Gallons; PT _____ Date _____ 240 Lins

Nitrification Field: No Fields 1 Square Feet 685 Linear Feet ~~228~~

No Lines 3 Trench Width 80 Ins Trench Depth 3' Gravel Depth 12"

☑ New System ☐ Repair System Type: I (II) II, IV, V, VI

System Description: CONV.

Repair System Description: CONV.

Maintenance Agreement Required: ☐ Yes ☑ No

☐ House/Mod. Home ☑ Mobile Home ☐ Business ☐ Other

No. Bedrooms 2 No. Bathrooms 2 No. Employees _____

☐ Slab ☑ Crawl Space ☐ Basement w/plumbing ☐ Basement wo/plumbing

Garbage Disposal: ☐ Yes ☑ No


Auto. Dishwasher: ☑ Yes ☐ No

Auto. Washing Machine: ☑ Yes ☐ No


Other _____

Comments: Lines can be lengthened and reduced to 2 @ 114' x 3' of space allows. Trenches not deeper than 24" to trench bottom.

INITIAL SITE SKETCH

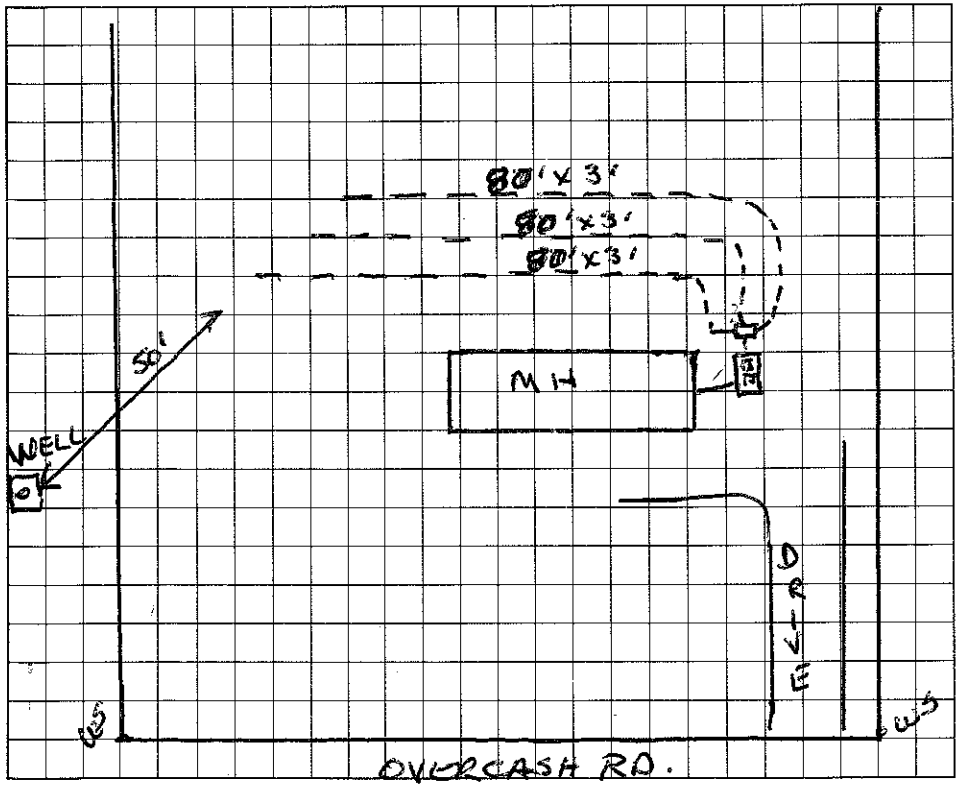

AS BUILT SKETCH

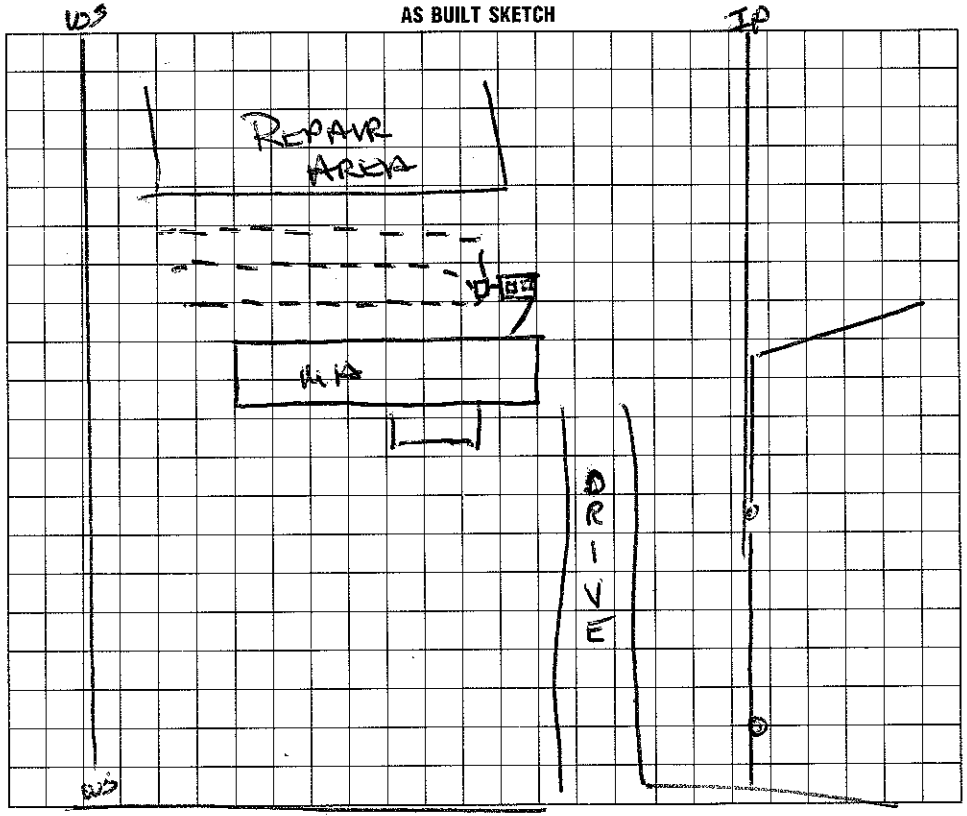

I understand that this permit can be suspended or revoked if any false information is supplied toward securing the permit/any unauthorized changes are made to the site/any unauthorized changes are made in the installation of the system. Improvement Permit is valid for 60 months from date of issuance.

Signed: Dale Lipe

Improvement Permit by: Wesley Sparks R.S. date 9/27/93

Existing System Inspection by: _____ date _____

Installed by: Dennis Pallicher OVERCASH RD

Certificate of Completion by: Wesley Sparks R.S. date 10/11/93

Operation Permit by: _____ date _____

HEALTH DEPT. COPY: WHITE INSPECTION COPY (FINAL): GREEN OWNER COPY (FINAL): YELLOW INSPECTION COPY (INITIAL): PINK OWNER COPY (INITIAL): GOLD