40 4750804019

IREDELL COUNTY HEALTH DEPARTMENT

STATESVILLE 704-878-5305 MOORESVILLE 704-664-5281

IMPROVEMENT PERMIT / AUTHORIZATION TO CONSTRUCT / OPERATION PERMIT / EXISTING SYSTEM INSPECTION

PERMIT# 140925 PIN# 4750802056.002 DATE 3/26/07

OWNER OR APPLICANT Teresa Newton PHONE: Business _____ Home _____

ADDRESS 525 Shepherd Rd Troutman NC 28166

LOCATION Hwy 115 N, RT on Shepherd Rd, Property down on Left before GA Mills 300

SUBDIVISION _____ BLOCK / SECTION _____ LOT 2 LOT AREA _____ SITE CLASS. P.S. DESIGN FLOW ~~300~~ L.T.A.R. .50

Septic Tank: 1000 Gallons; STB 1012 Date 3/14/07

Pump Tank: _____ Gallons; PT _____ Date _____

Pump Make: _____ Model _____ Serial No. _____

Nitrification Field: No Fields 1 Square Feet 1200 Linear Feet ~~1200~~ 300'

No Lines ~~4~~ 3 @ 100 Trench Width 36" Max Trench Bottom Depth 36"

☑ New System ☐ Repair ☐ Expansion System Type: I II III IV V VI

System Description: Gravity → 25% Reduction

Repair System Description: LP Panel

Maintenance Agreement Required: ☐ Yes ☑ No

☑ House/Mod. Home ☐ Mobile Home ☐ Business ☐ Other

No. Bedrooms ~~3~~ 4 No. Persons ____ No. Employees ____


Water Supply: ☑ Individual ☐ Public ☐ Community

Gravel Depth ____ ☑ Gravity ☐ Pressure ☐ Slab ☑ Crawl Space ☐ Basement w/plumbing ☐ Basement wo/plumbing

Comments/Conditions:
~~3~~ Lines equaling ~~300~~ 300 linear feet using drop boxes
- keep lines 15' to 25' from gully, and 10' from property lines

Comments/Conditions: Building Plans comply with I.P.
- CHANGING TO 3 Bedroom System which looses 100' of line (the 2030')

INITIAL SITE SKETCH

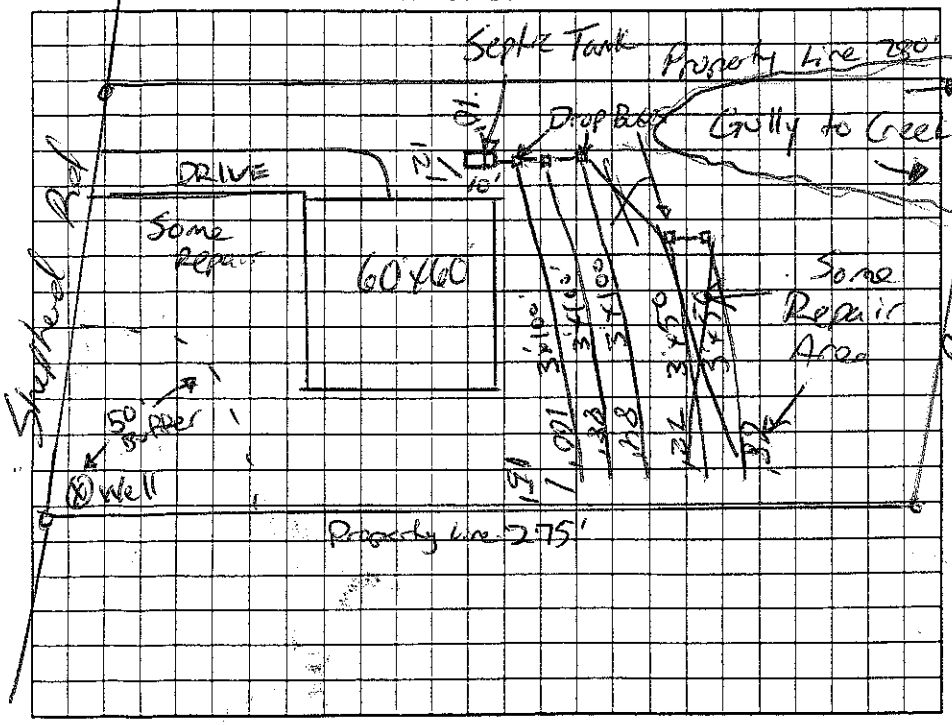

AS BUILT SKETCH

System installed as originally designed with 4/12 installed Infiltrator Quick 4

9/13/07 AC

House is 3BR but installer installed enough drainfield for 4BR house.

Permit can be suspended or revoked if any false information is supplied toward securing the permit/any unauthorized changes are made to the site/any unauthorized changes are made in the installation of the system. Improvement Permit with plat valid without expiration ☐ Improvement Permit with site plan valid for sixty months ☑ Authorization to Construct is valid for a period equal to that of Improvement Permit – not to exceed sixty months.

Signed: Teresa Newton date 3-26-07 Installed by: Piedmont ~~Septic~~ Backhoe

Improvement Permit by: John E Alp date 3/26/07 Operation Permit by: Anthony Cobern date 9/13/07

Authorization to Construct by: John E Alp date 4-24-07 Existing System Inspection by: _____ date _____

HEALTH DEPT. COPY: WHITE OWNER COPY (FINAL): YELLOW OWNER COPY (INITIAL): PINK