2100

IREDELL COUNTY HEALTH DEPARTMENT - *ENVIRONMENTAL HEALTH* ☐ STATESVILLE OFFICE 704-878-5305 ☑ MOORESVILLE OFFICE 704-664-52

IMPROVEMENT PERMIT / AUTHORIZATION TO CONSTRUCT / OPERATION PERMIT / EXISTING SYSTEM INSPECTION

PERMIT # 150356 PIN # 4756-80-4302 DATE 1-20-12

OWNER ADAMS HOMES APPLICANT: MIKE ATHANAS PHONE: Home/Cell # 704-576-3887 Business #

SITE ADDRESS 559 SHEPHERD RD OWNER / APPLICANT ADDRESS 10115 KINCEY AVE. #1600 HUNTERSVILLE NC

SITE DIRECTIONS 21N, TR SHEPHERD, ON L

SUBDIVISION GA MILLS BLOCK / SECTION LOT # 74 LOT AREA .77AC DESIGN FLOW 480 GPD L.T.A.R. .3

Septic Tank 1000 Gallons: STB 825 Date 1-7-12 ☒ New System ☐ Repair ☐ Expansion System Type I II III IV V VI ☒ Residence No. Bedrooms 4 **Water Supply** ☒ Private

Pump Tank Gallons: P T Date System Description: 25% REDUCTION ☐ Business No. Persons ☐ Public

Pump Make Model Serial # Repair System Description: PM - 25% REDUCTION ☐ Other No. Employees ☐ Community


No. Nitrification Fields: 1 No. Lines 3 Linear Feet 400' Maintenance Agreement Required ☐ YES ☒ NO ☒ Slab ☐ Crawl Space

Trench Width 36" Max. Trench Bottom Depth 36" Gravel Depth — ☒ GRAVITY ☐ PRESSURE ☐ Basement w/plumbing ☐ Basement w/o plumbing


Comments / Conditions

Used Quick 4 ST to Side of House. Serial dist Line lengths 148, 132, & 120

INITIAL SITE SKETCH

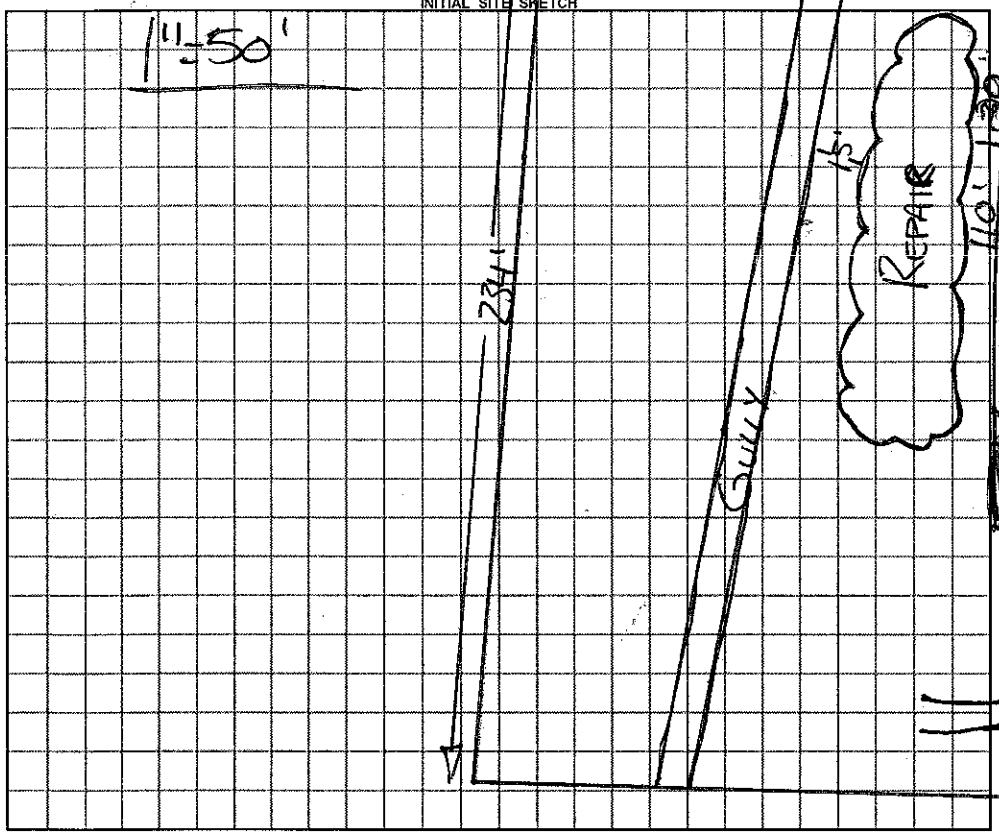

AS BUILT SKETCH

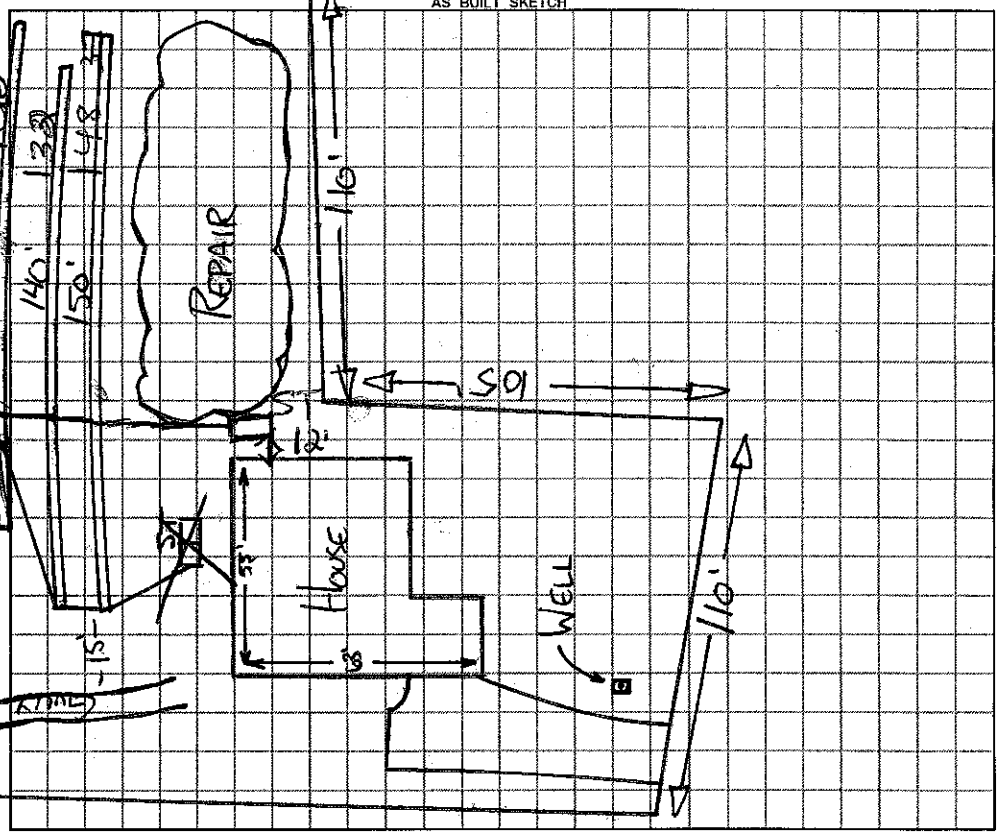

Permit can be suspended or revoked if any false information is supplied toward securing the permit / any unauthorized changes are made to the site / any unauthorized changes are made in the installation of the system.

☐ ***IMPROVEMENT PERMIT*** with plat valid without expiration. ☐ ***IMPROVEMENT PERMIT*** with ~~plat valid without expiration.~~ site plan valid 60 mo. ☐ ***AUTHORIZATION TO CONSTRUCT*** valid for period equal to IMPROVEMENT PERMIT--not to exceed 60 mo.

Owner / Applicant Signature: Date 11/24/12 Installed by: Rowan Septic

IMPROVEMENT PERMIT by: REHS Date 1-20-12 OPERATION PERMIT by: REHS Date 5/8/2012

AUTHORIZATION TO CONSTRUCT by: REHS Date 1-24-12 Existing System Inspected by: REHS Date

YOU SHOULD CONTACT A LOCATOR SERVICE PRIOR TO ANY EXCAVATION

White Copy – Environmental Health YELLOW COPY (Final) Owner / Applicant PINK COPY (Initial) Owner / Applicant