2145 gpm

IREDELL COUNTY HEALTH DEPARTMENT

STATESVILLE 704-878-5305 MOORESVILLE 704-664-5281

IMPROVEMENT PERMIT / AUTHORIZATION TO CONSTRUCT / OPERATION PERMIT / EXISTING SYSTEM INSPECTION

PERMIT # 149426 PIN # 4750-80-4875 DATE 10-26-10

OWNER or APPLICANT Adams Homes PHONE: Business 704-947-6118 Home:

OWNER or APPLICANT ADDRESS 10115 Kincey Ave 160 Huntersville, NC 28078

LOCATION / DIRECTIONS 589 Shepherd Rd

SUBDIVISION C-A Mills BLOCK / SECTION LOT # 69 LOT AREA .76 Ac DESIGN FLOW 480 GPD L.T.A.R. .3

Septic Tank 1000 Gallons: STB 825 Date 7-29-10
Pump Tank 1000 Gallons: PT 302 Date 9-20-10
Pump Make Zoeller Model N152 Serial #
Nitrification Field No Fields 1 No Lines 4 Linear Feet 267'
Trench Width 24-36" Max. Trench Bottom Depth 36" Gravel Depth Sand

☒ New System ☐ Repair ☐ Expansion System Type I II III (IV) V VI
System Description: LP- Panel Block
Repair System Description: Same
Maintenance Agreement Required ☒ YES ☐ NO
☐ GRAVITY ☒ PRESSURE


☒ Residence No. Bedrooms 4
☐ Business No. Persons
☐ Other No. Employees
☒ Slab ☐ Crawl Space
☐ Basement w/plumbing ☐ Basement w/o plumbing

Water Supply: ☒ Private ☐ Public ☐ Community


Comments / Conditions 1) Do Not Drive Or Set Materials Over Drain Field Area 2) Flag Around Septic After Installation 3) Meet All Required Set Backs 4) Tanks Must Go Where Shown

Comments / Conditions 5/32" hole drilled
11/19/10 Checked tanks, lines & set pressure

INITIAL SITE SKETCH

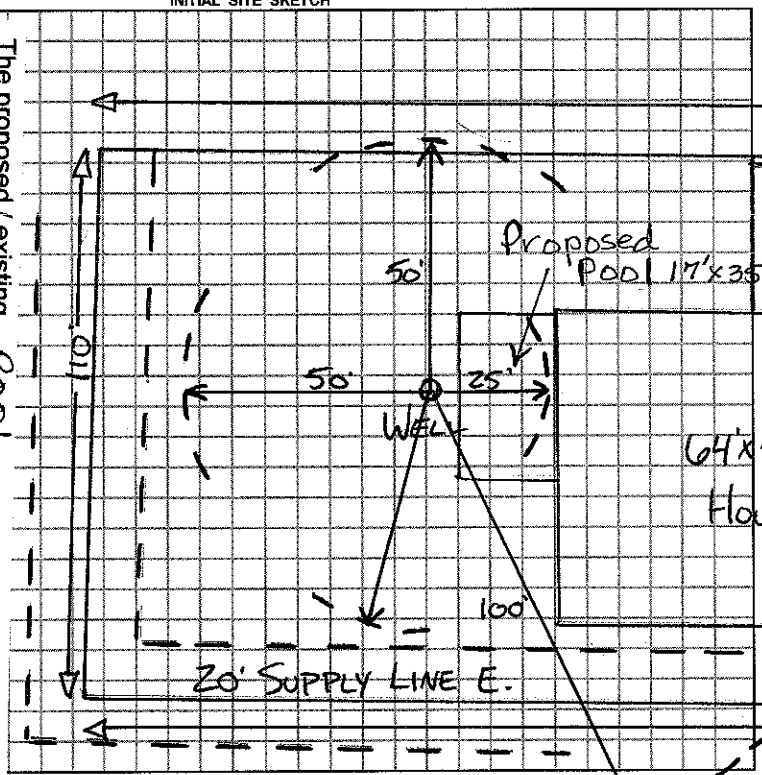

AS BUILT SKETCH

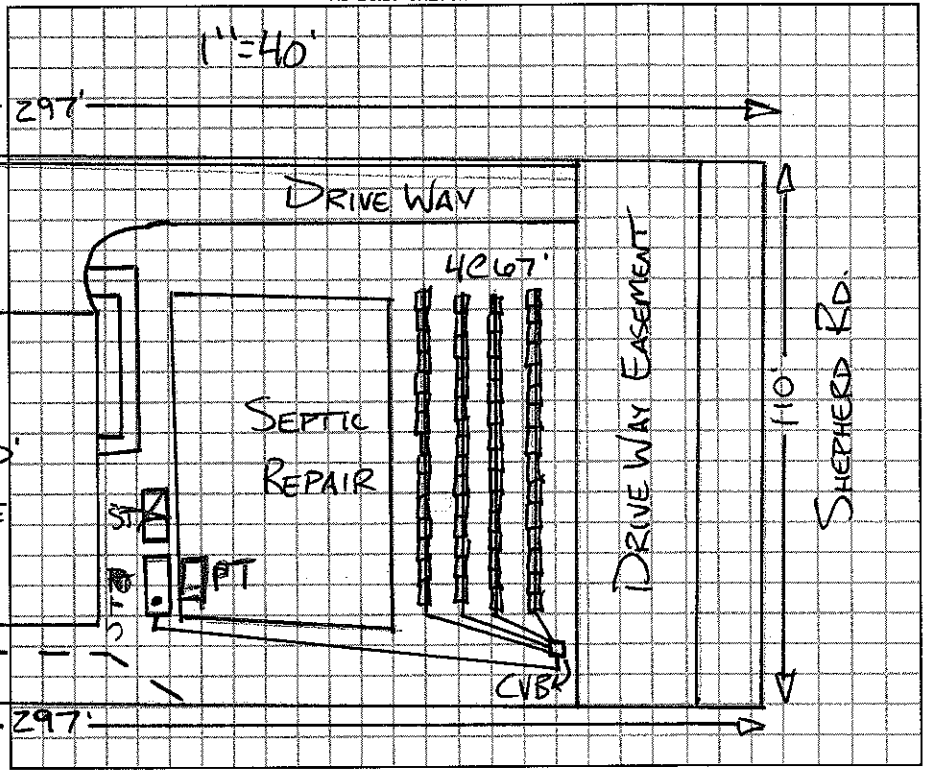

**NOTE: The proposed / existing Pool addition does not appear to impact the existing septic system.

Date: 5-29-12 ICHD-Environmental Health Division R.S.

Permit can be suspended or revoked if any false information is supplied toward securing the permit / any unauthorized changes are made to the site / any unauthorized changes are made in the installation of the system.

☐ *IMPROVEMENT PERMIT w / plat valid without expiration* ☐ *IMPROVEMENT PERMIT w / site plan valid for 60 mos.* ☐ *AUTHORIZATION TO CONSTRUCT valid for period equal to IMPROVEMENT PERMIT-not to exceed 60 mo.*

Owner / Applicant Signature: [signature] Date 11/4/10

Improvement Permit by: [signature] REHS Date 10-26-10

Authorzation to Construct by: [signature] REHS Date 10-26-10

Installed by: Rowan Septic RS

Operation Permit by: [signature] Date: 12/7/2010

Existing System Inspected by: Date:

YOU SHOULD CONTACT A LOCATOR SERVICE PRIOR TO ANY EXCAVATION.

WHITE COPY Environmental Health YELLOW COPY (Final) Owner / Applicant PINK COPY (Initial) Owner / Applicant