PERMIT # _____ PIN # 4750-81-2010

IREDELL COUNTY HEALTH DEPARTMENT – *Environmental Health Division*

Statesville Office 704-878-5305 Mooresville Office 704-660-3625

PRIVATE DRINKING WATER WELL PERMIT

Type of Permit (circle one) New Repair Abandonment

APPLICANT INFORMATION Robert Powell 704.742.6113

Adams Homes NC LLC 10115 Kincey Ave # 100 Huntersville NC 28078

Name Full Address Telephone #

PROPERTY INFORMATION


NSR, TR Shepherd, TL Hunter TR Final Conn. TL Mills Plantation on Left

Directions to Site

155 Mills Plantation Crescent Mills 36

Physical location of proposed well (street address) Subdivision Lot #

Initial Site Sketch

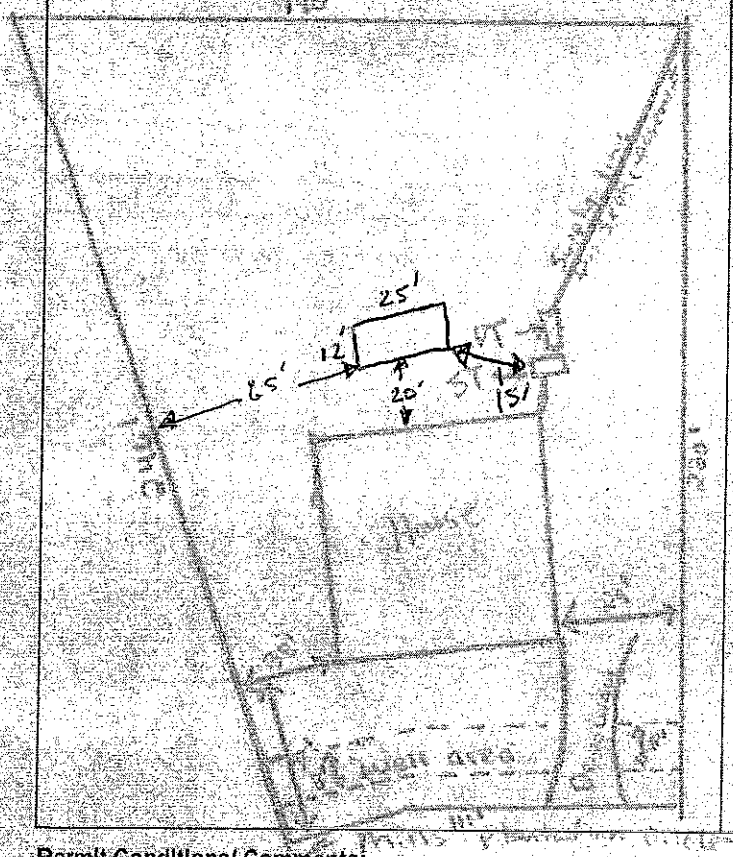

"As Built" Sketch

4/4/11

Pool Site Plan

Hatteras Pools of Statesville

fiveyoungs89@yahoo.com

Permit Conditions/ Comments: _____

Maintain all setbacks, stay out of adv. Easement of well in front yard

Well Permit Issued By: _____ **Date:** 10/7/10

(Permit is valid for 5 years from date issued. This permit may be revoked if it is determined there has been a material change in any fact or circumstance upon which the permit is issued. Actions of the employees of the Iredell County Health Department shall in no way be taken as a guarantee that this well will produce water of any particular quantity or quality or for any amount of time. Employees of the Iredell County Health Department assume no liability for any damages, either direct or consequential which may be caused by this well.)

Well GPS Coordinates Lat: _____ **Long:** _____ **Well Contractor** _____ **Contractor Cert #** _____

Grout Inspection By: _____ **Date:** _____ **or Certification for Grouting Not Witnessed by Dept** _____ **Date:** _____ **Well Head Inspection** (check when completed) Grout to Ground Surface ☐

Well Contractor ID Plate ☐ Pump Installer ID Plate ☐ Sample Port ☐ Access Port / Vent ☐ Well Seal ☐ Well Head 12 inches / Pitless Adaptor 8 inches above grade ☐ **Well Head Inspection By:** _____ **Date:** _____

Certificate of Completion by: _____ **Date:** _____ **Water Samples By:** _____ **Date:** _____

Attachments: Form GW-1a (*required except for abandonment*) ☐ Form GW 30 ☐ Water Sample Results ☐ Plat ☐

Health Dept. Copy - White Applicant Certificate of Completion - Yellow Applicant Well Construction Permit - Pink