IREDELL COUNTY HEALTH DEPARTMENT

STATESVILLE 704-878-5305 MOORESVILLE 704-664-5281

IMPROVEMENT PERMIT / AUTHORIZATION TO CONSTRUCT / OPERATION PERMIT / EXISTING SYSTEM INSPECTION

PERMIT # 146751 PIN # 4750813401 DATE 8/14/09

OWNER or APPLICANT Adams Homes PHONE: Business 704.947.6118 Home:

OWNER or APPLICANT ADDRESS 10115 Kincey Ave Suite 160 Huntersville, NC 28078

LOCATION / DIRECTIONS Hwy 115 N, TR Shepherd, TL Thurston, on left

SUBDIVISION Georgia Mills BLOCK / SECTION — LOT # 60 LOT AREA 1.68 acre DESIGN FLOW 480 gal/d L.T.A.R. 0.25

Septic Tank 1000 Gallons: STB 825 Date 8-4-09

Pump Tank 1000 Gallons: PT 502 Date 7-20-09

Pump Make ZOELLER Model BN152 Serial # .4HP

Nitrification Field No Fields 1 No Lines 4 Linear Feet 480'

Trench Width 36" Max. Trench Bottom Depth 36" Gravel Depth —

☒ New System ☐ Repair ☐ Expansion System Type I II III IV V VI

System Description: 825 % reduction pm

Repair System Description: LP PPBPS

Maintenance Agreement Required ☐ YES ☒ NO Initially

☐ GRAVITY ☒ PRESSURE

☐ Residence No. Bedrooms 4 ☐ Business No. Persons ☐ Other No. Employees ☒ Slab ☐ Crawl Space ☐ Basement w/plumbing ☐ Basement w/o plumbing


Water Supply ☒ Private ☐ Public ☐ Community

Comments / Conditions


* Install on Contour
* Maintain all Setbacks
* Stay at least 10' off of back property line
* Do not cut into Drainfield area for House Pad

Comments / Conditions

INITIAL SITE SKETCH

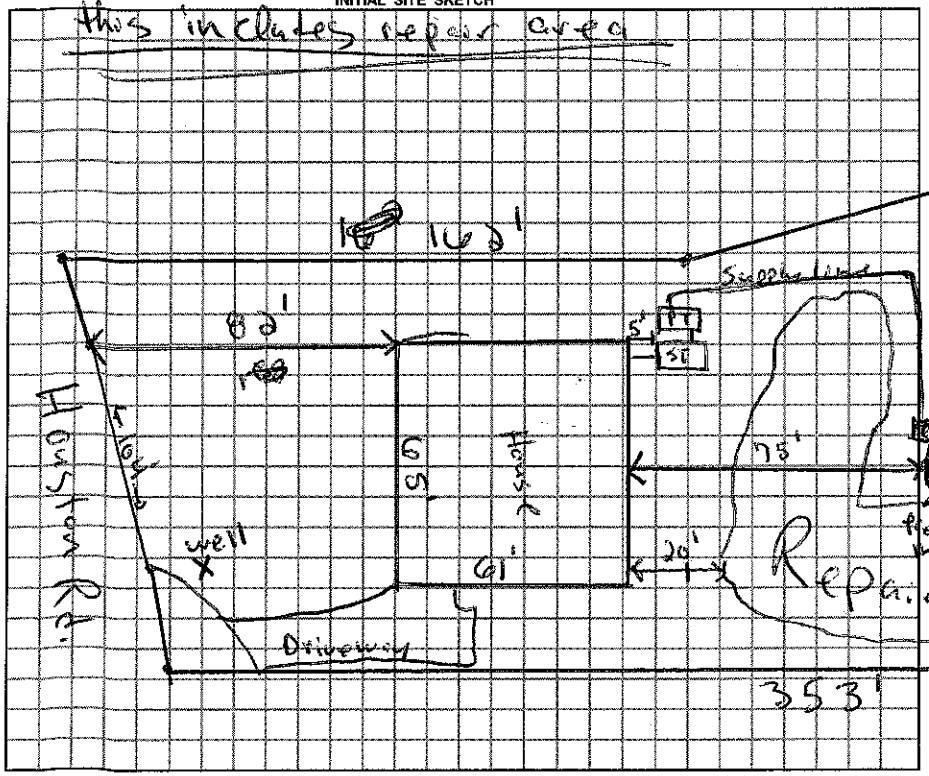

AS BUILT SKETCH

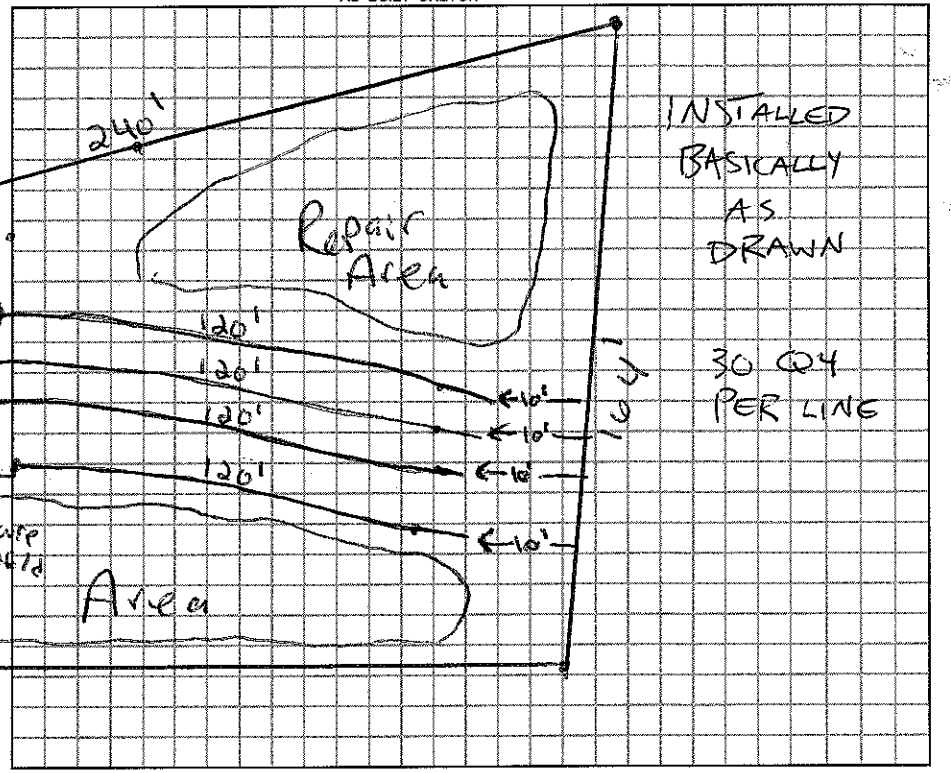

Permit can be suspended or revoked if any false information is supplied toward securing the permit / any unauthorized changes are made to the site / any unauthorized changes are made in the installation of the system.

☐ *IMPROVEMENT PERMIT w / plat valid without expiration.* ☒ *IMPROVEMENT PERMIT w / site plan valid for 60 mos.* ☒ *AUTHORIZATION TO CONSTRUCT valid for period equal to IMPROVEMENT PERMIT-not to exceed 60 mo.*

Owner / Applicant Signature: Jed Alsaqa Date 8/17/09

Improvement Permit by: [signature] Date 8/14/09

Authorization to Construct by: Ronnie Moore Date 8/14/09

Installed by: ROWAN SEPTIC TANK

Operation Permit by: [signature] REHS Date: 11-19-09

Existing System Inspected by: Date:

YOU SHOULD CONTACT A LOCATOR SERVICE PRIOR TO ANY EXCAVATION.

WHITE COPY Environmental Health YELLOW COPY (Final) Owner / Applicant PINK COPY (Initial) Owner / Applicant