9M

IREDELL COUNTY HEALTH DEPARTMENT

STATESVILLE 704-878-5305 MOORESVILLE 704-664-5281

IMPROVEMENT PERMIT / AUTHORIZATION TO CONSTRUCT / OPERATION PERMIT / EXISTING SYSTEM INSPECTION

PERMIT # 139891 PIN # 4750-81-4034 DATE 10-20-10

OWNER or APPLICANT Adams Homes PHONE: Business 704-947-6118 Home:

OWNER or APPLICANT ADDRESS 10115 Kincey Ave 160 Huntersville, NC 28078

LOCATION / DIRECTIONS Shepherd Rd

SUBDIVISION GA Mills BLOCK / SECTION LOT # 67/67A LOT AREA .74Ac DESIGN FLOW 480GPD L.T.A.R. .35

Septic Tank 1000 Gallons: STB 825 Date 7-20-10
Pump Tank 1000 Gallons: P T 502 Date 8-18-10
Pump Make Zoeller Model M152 Serial #
Nitrification Field No Fields 1 No Lines 5 Linear Feet 335'
Trench Width 36" Max. Trench Bottom Depth 36" Gravel Depth —

☒ New System ☐ Repair ☐ Expansion System Type I II III IV V VI
System Description: PM - 25% Reduction
Repair System Description: LP - Panel
Maintenance Agreement Required ☐ YES ☒ NO
☐ GRAVITY ☒ PRESSURE


☒ Residence No. Bedrooms 4
☐ Business No. Persons
☐ Other No. Employees
☒ Slab ☐ Crawl Space
☐ Basement w/plumbing ☐ Basement w/o plumbing

Water Supply: ☒ Private ☐ Public ☐ Community


Comments / Conditions 1) Do Not Drive or Set Materials Over Drain Field 2) Flag Around Septic After Installation 3) Meet All Required Set Backs 4) Tanks Must Go Where Shown

Comments / Conditions Tanks Installed Deep Because of Plumbing
Drainlines, tanks & pressure 11/15/10 by BA

INITIAL SITE SKETCH

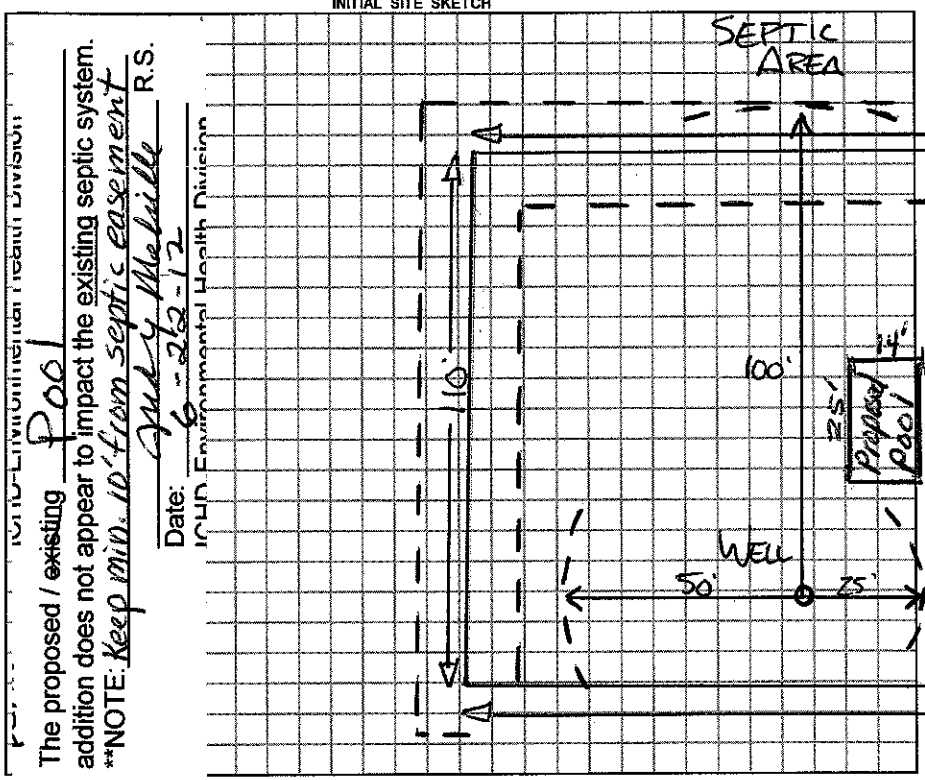

AS BUILT SKETCH

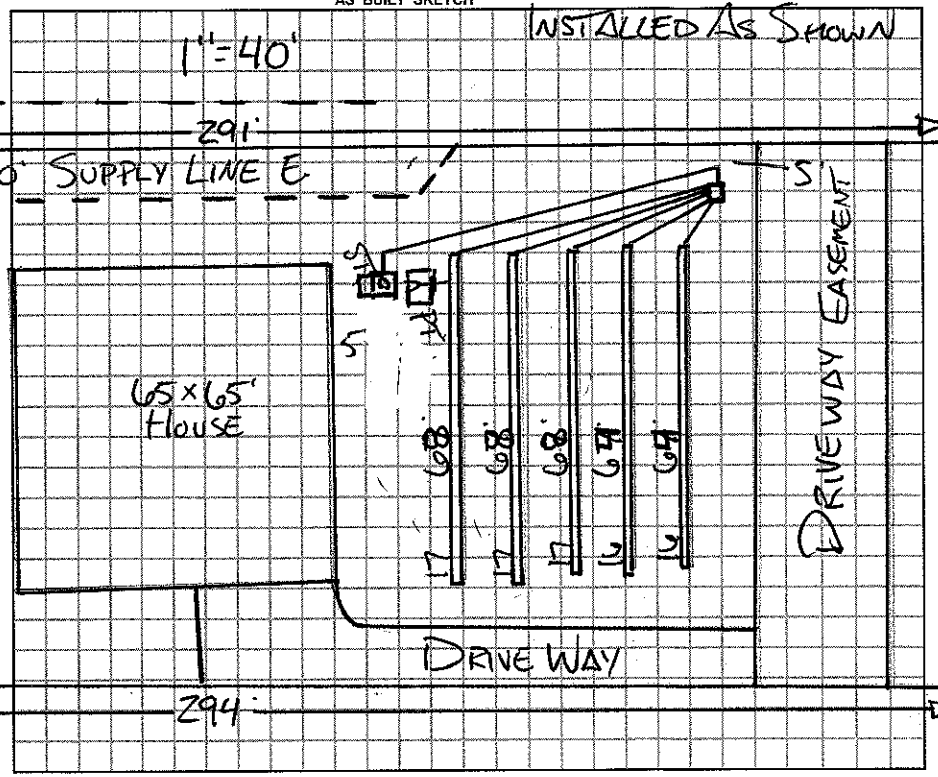

The proposed / existing Pool addition does not appear to impact the existing septic system.
**NOTE: Keep min. 10' from septic easement
Date: 6-22-12 Judy Melville R.S.
Iredell Environmental Health Division

Permit can be suspended or revoked if any false information is supplied toward securing the permit / any unauthorized changes are made to the site / any unauthorized changes are made in the installation of the system.

☐ *IMPROVEMENT PERMIT w / plat valid without expiration* ☐ *IMPROVEMENT PERMIT w / site plan valid for 60 mos.* ☐ *AUTHORIZATION TO CONSTRUCT valid for period equal to IMPROVEMENT PERMIT-not to exceed 60 mo.*

Owner / Applicant Signature: Matt Calhoun Date 11/4/10
Improvement Permit by: REHS Date 10-26-10
Authorzation to Construct by: REHS Date 10-26-10
Installed by: Rowan Septics
Operation Permit by: Marie H. Osborne Date: 11/22/2010
Existing System Inspected by: Date:

YOU SHOULD CONTACT A LOCATOR SERVICE PRIOR TO ANY EXCAVATION.

WHITE COPY Environmental Health YELLOW COPY (Final) Owner / Applicant PINK COPY (Initial) Owner / Applicant