Site Address: 625 Shepherd Rd - Iredell

# IREDELL COUNTY HEALTH DEPARTMENT

STATESVILLE 704-878-5305 MOORESVILLE 704-664-5281

## IMPROVEMENT PERMIT / AUTHORIZATION TO CONSTRUCT / OPERATION PERMIT / EXISTING SYSTEM INSPECTION

PERMIT# 146715 PIN# 4750815512.000 DATE 11/16/07

OWNER OR APPLICANT Edwards Construction PHONE: Business 704 753-5310 Home

ADDRESS 2419 Henry Baucom Rd. Monroe, NC 28110

LOCATION Hwy 21 TR Houston Rd TR on Shepherd, 1st Lot on Right

SUBDIVISION Georgia Mills Plantation BLOCK / SECTION LOT 63 LOT AREA 1.077ac SITE CLASS PS DESIGN FLOW 480 L.T.A.R. 3

Septic Tank: 1000 Gallons: STB 825 Date 7-9-12

Pump Tank: Gallons: PT Date

Pump Make: Model Serial No.

Nitrification Field: No Fields 1 Square Feet 1200 Linear Feet 400'

No Lines 3@134' Trench Width 36" Max Trench Bottom Depth 36" Gravel Depth N/A

☑ New System ☐ Repair ☐ Expansion System Type: I II III IV V VI

System Description: Gravity 25% Reduction

Repair System Description: Same

Maintenance Agreement Required: ☐ Yes ☑ No

☑ House/Mod. Home ☐ Mobile Home ☐ Business ☐ Other

No. Bedrooms 4 No. Persons No. Employees

Water Supply: ☑ Individual ☐ Public ☐ Community

☑ Gravity ☐ Pressure ☐ Slab ☑ Crawl Space ☐ Basement w/plumbing ☐ Basement wo/plumbing

Comments:/Conditions:

* Per Plan Specs

Comments:/Conditions:

RECEIVED

INITIAL SITE SKETCH

* see plan attached from S&ME

REVIEWED PLANS BA 8-2-12

AS BUILT SKETCH

INSTALLED AS DRAWN

Permit can be suspended or revoked if any false information is supplied toward securing the permit/any unauthorized changes are made to the site/any unauthorized changes are made in the installation of the system. Improvement Permit with plat valid without expiration ☐ Improvement Permit with site plan valid for sixty months ☑ Authorization to Construct is valid for a period equal to that of Improvement Permit – not to exceed sixty months.

Signed: date 3/7/07

Improvement Permit by: Anthony Cokes Jr date 11/16/07


Authorization to Construct by: BA date 8-2-12

Installed by: Rowan Septic

Operation Permit by: BA REHS date 9-13-12

Existing System Inspection by: date

HEALTH DEPT. COPY: WHITE OWNER COPY (FINAL): YELLOW OWNER COPY (INITIAL): PINK

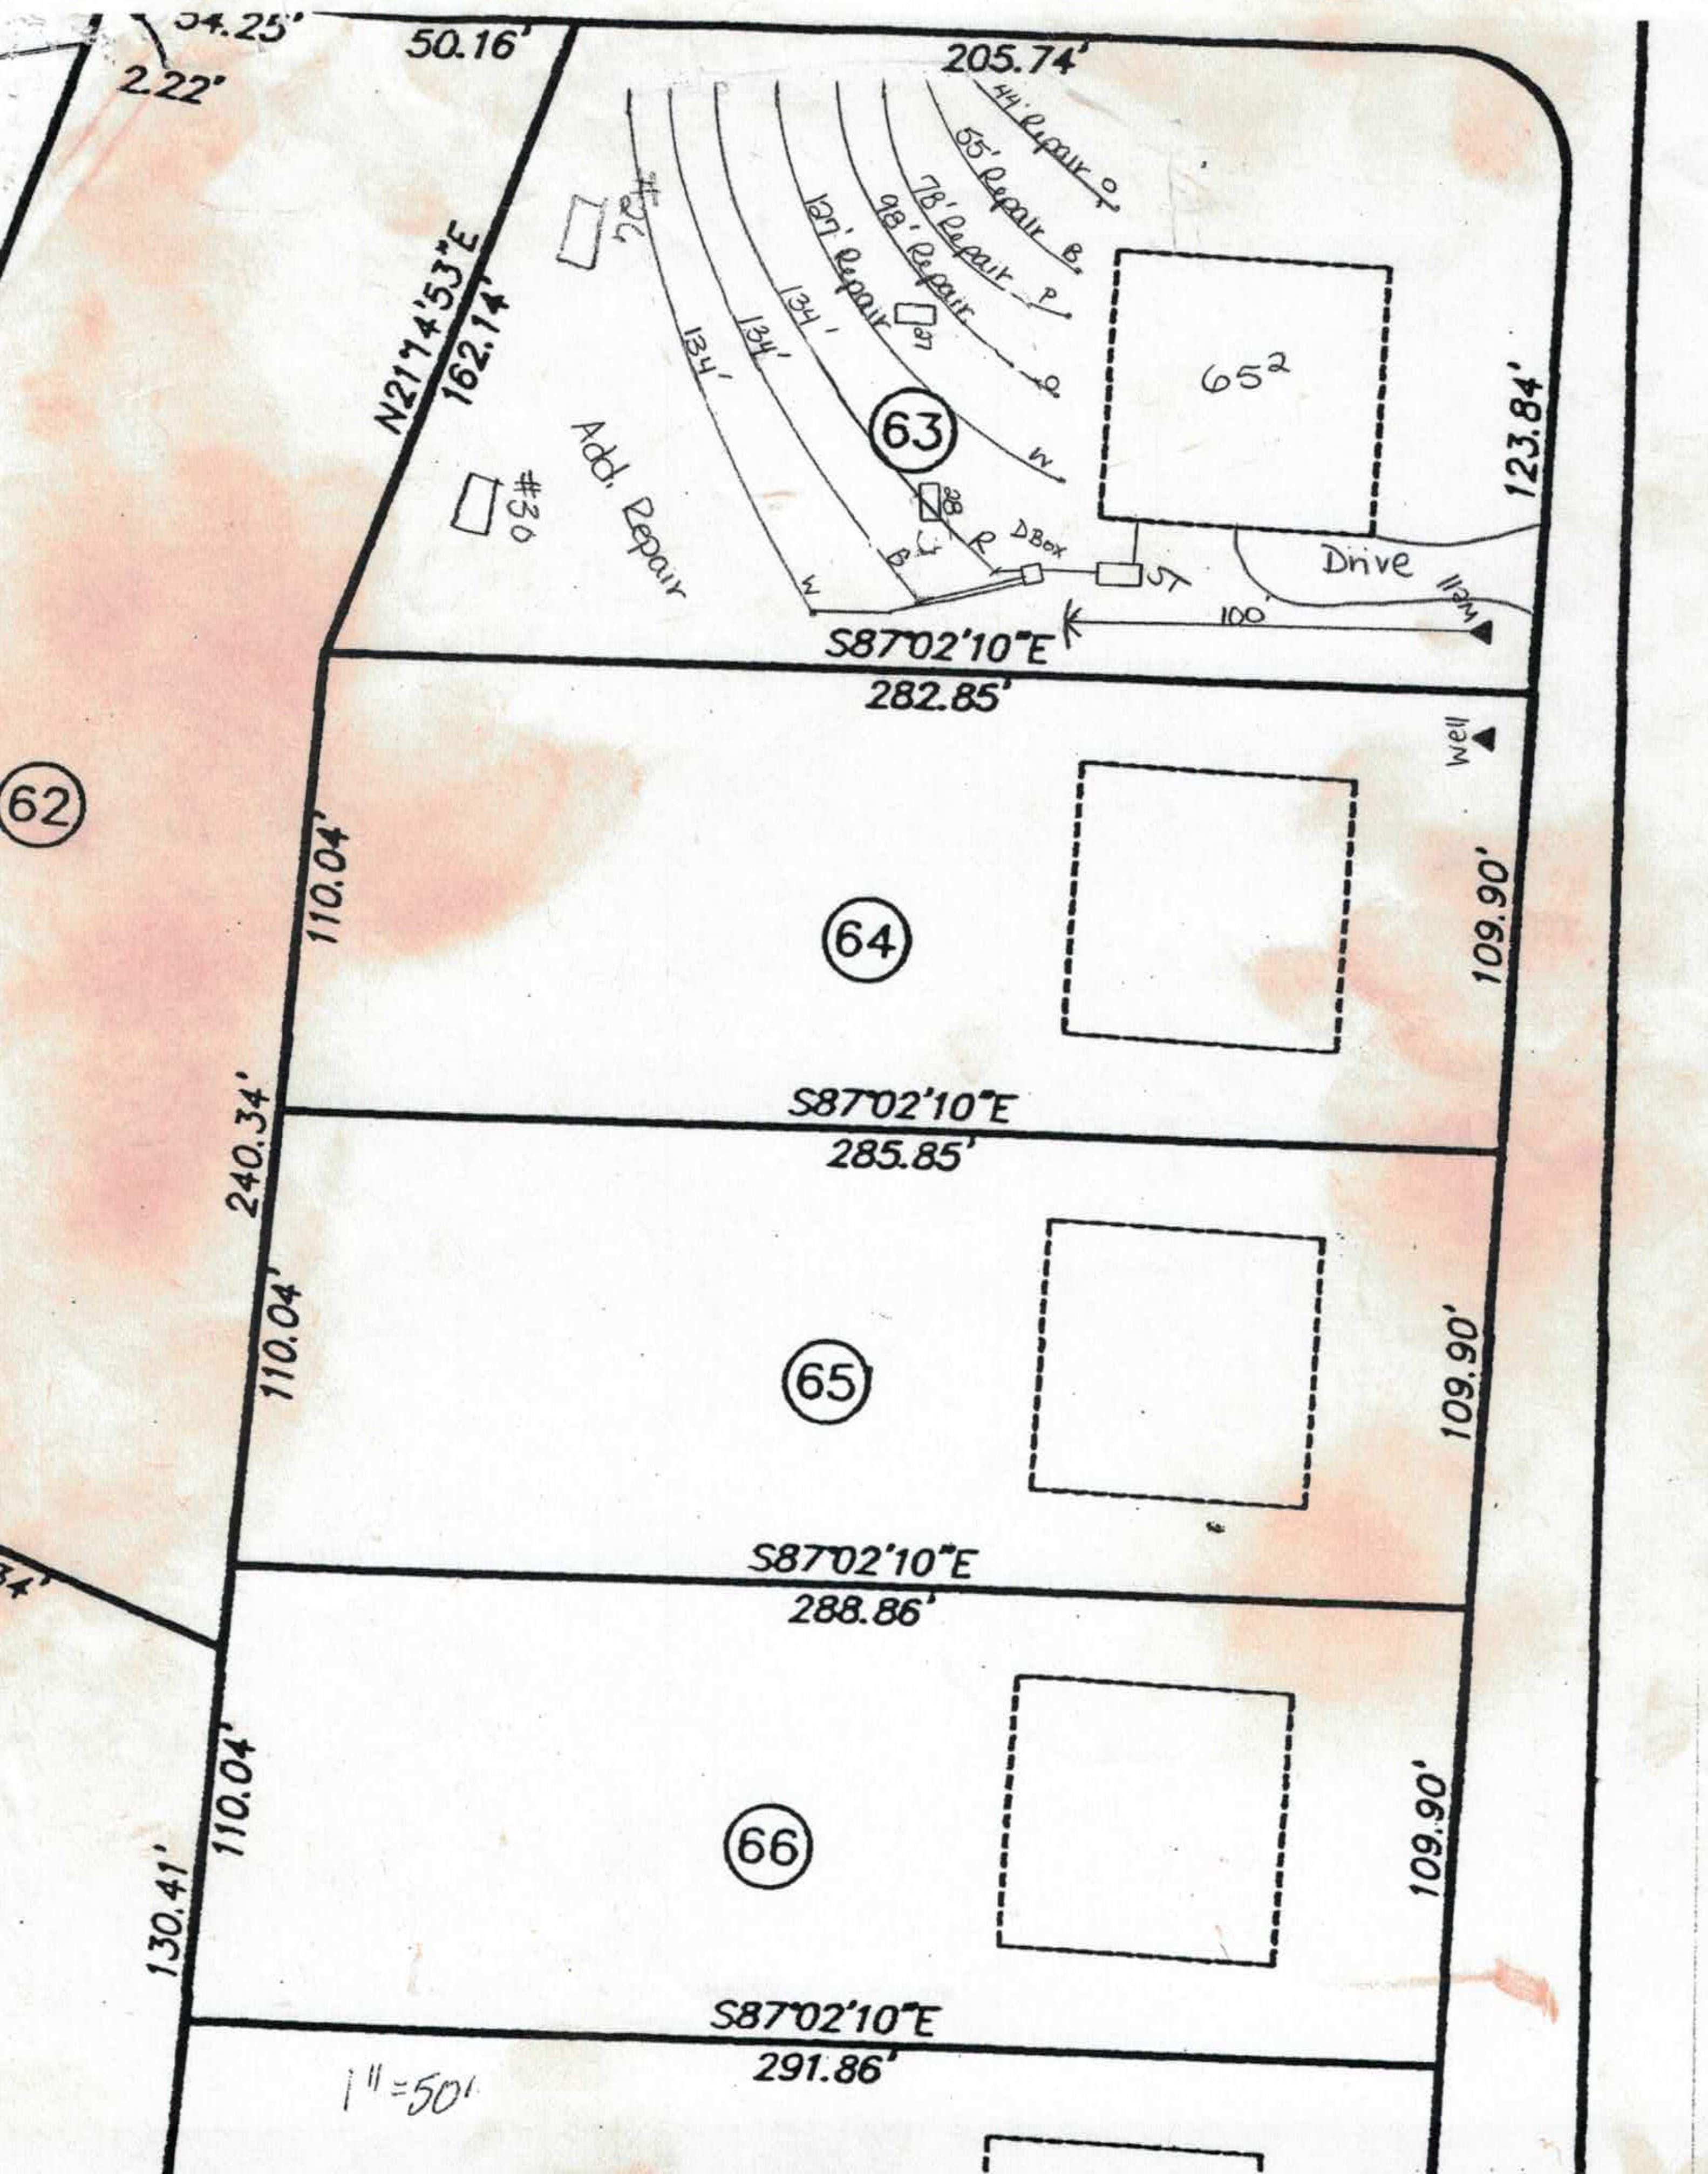

54.25'
2.22'
50.16'
205.74'
44' Repair O
55' Repair B
78' Repair P
98' Repair
127' Repair
134'
134'
134'
N21°14'53"E
162.14'
652
63
123.84'
Add. Repair
#30
DBox
ST
Drive
Well
100'
S87°02'10"E
282.85'
Well
62
110.04'
64
109.90'
S87°02'10"E
285.85'
240.34'
110.04'
65
109.90'
S87°02'10"E
288.86'
110.04'
130.41'
66
109.90'
S87°02'10"E
291.86'
1" = 50'