IREDELL COUNTY HEALTH DEPARTMENT

STATESVILLE 704-878-5305 MOORESVILLE 704-664-5281

IMPROVEMENT PERMIT / AUTHORIZATION TO CONSTRUCT / OPERATION PERMIT / EXISTING SYSTEM INSPECTION

PERMIT# 114985 PIN# 4750 88 5764 DATE 8/14/03

OWNER OR CONTRACTOR Fleetwood - Trentmon PHONE: Business 704-528-7120 Home

ADDRESS 1040 Charlotte Hwy Trentmon, NC 28166

LOCATION Wcaffins Creek Rd TL Owencash Rd. on (R) before Kendall Rd.

SUBDIVISION Pheasant Run BLOCK / SECTION 1 LOT 7 LOT AREA 25acres SITE CLASS. PS DESIGN FLOW 360 L.T.A.R. .3

Septic Tank: 1000 Gallons; STB 1012 Date 2/10/03
Pump Tank: Gallons; PT Date
Pump Make: Model Serial No.
Nitrification Field: No Fields 1 Square Feet 900 X Linear Feet 300
No Lines 3 @ 100' Trench Width 3' Max Trench Bottom Depth 3' Gravel Depth No

X New System ☐ Repair System Type: I, II, III, IV, V, VI
System Description: GRAV - Type 3 Drainfield
Repair System Description: Same
Maintenance Agreement Required: ☐ Yes ☒ No

X House/Mod. Home No. Bedrooms 3
☐ Mobile Home No. Bathrooms 2
☐ Business No. Employees
☐ Other
☐ Slab X Crawl Space ☐ Basement w/plumbing ☐ Basement wo/plumbing


Water Supply: X Individual ☐ Public ☐ Community

Comments:/Conditions:

Comments:/Conditions:


(1" = 50')

INITIAL SITE SKETCH

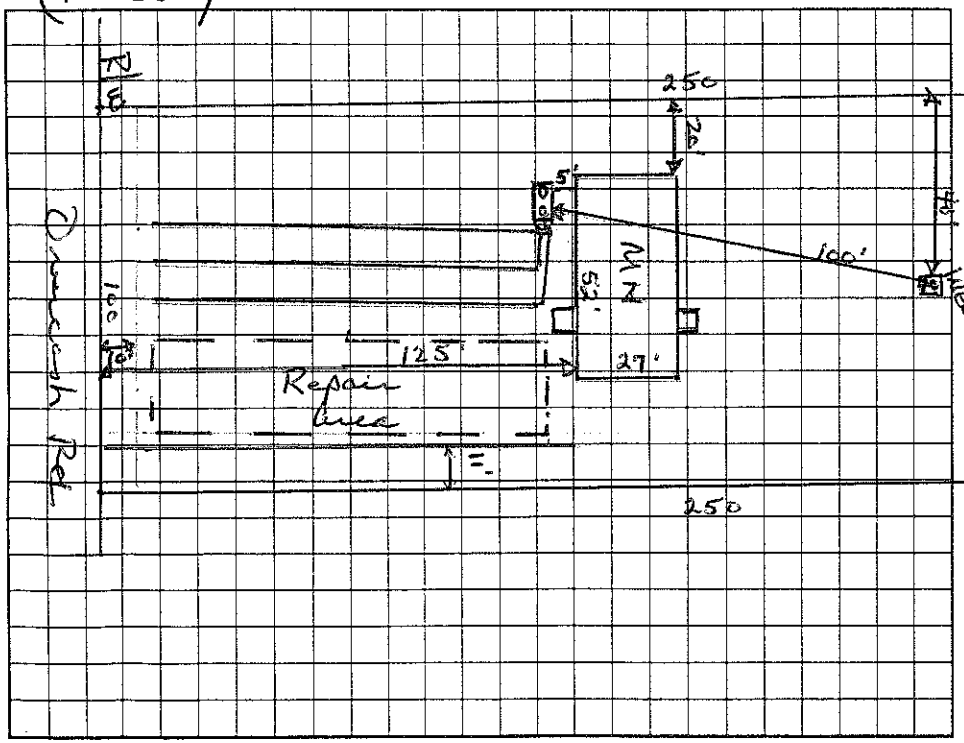

AS BUILT SKETCH


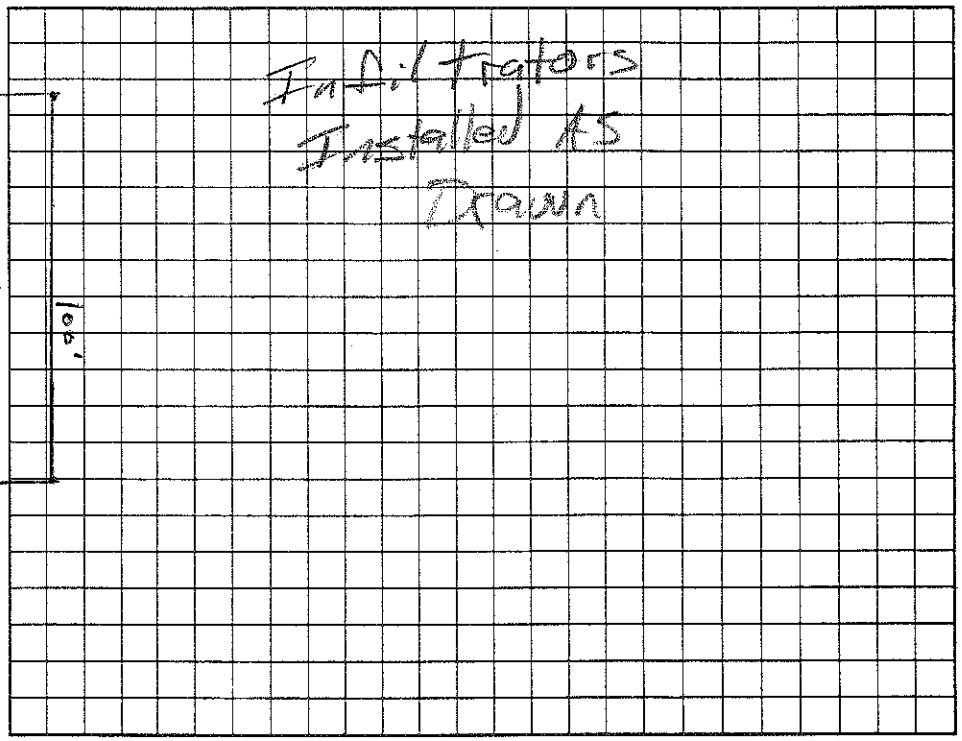

Permit can be suspended or revoked if any false information is supplied toward securing the permit/any unauthorized changes are made to the site/any unauthorized changes are made in the installation of the system. Improvement Permit with plat valid without expiration. Improvement Permit with site plan valid for sixty months. Authorization to Construct is valid for a period equal to that of Improvement Permit – not to exceed sixty months.

Signed: X Chris Hutton date 8/15/03
Improvement Permit by: Wesley Sparks RS. date 8/14/03
Authorization to Construct by: Wesley Sparks RS date 8/14/03

Installed by: Craig Thompson
Operation Permit by: [signature] RS date 8/29/03
Existing System Inspection by: date

HEALTH DEPT. COPY: WHITE OWNER COPY (FINAL): YELLOW OWNER COPY (INITIAL): PINK