IREDELL COUNTY HEALTH DEPARTMENT

STATESVILLE 704-878-5305 MOORESVILLE 704-664-5281

IMPROVEMENT PERMIT / ~~CERTIFICATE OF COMPLETION~~ / OPERATION PERMIT / EXISTING SYSTEM INSPECTION

PROPERTY DESCRIPTION NO. 21986 DATE 12/20/95 TAX MAP NO. 4G 4A 47 4750 88 8860 Watershed: ☐ Yes ☒ No

OWNER OR CONTRACTOR Mel Graham (BRAD DAVIS) PHONE: Business 663-6905 Home

ADDRESS 7701 Park Rd. Charlotte, NC. 28201

LOCATION Westhess Creek Rd. TL on Pheasant Run Rd. to 9th lot on (L)

SUBDIVISION Pheasant Run BLOCK / SECTION III LOT 47 LOT AREA .624c SITE CLASS. PS DESIGN FLOW 360 L.T.A.R. .30

Septic Tank: 1000 Gallons; STB 55 Date 12/18/95

Pump Tank: Gallons; PT Date

Pump Make: Model Serial No.

Nitrification Field: No Fields 1 Square Feet 1200 Linear Feet ~~300~~

No Lines 4 Trench Width 36" Max Trench Bottom Depth 36" Gravel Depth N/A

☒ New System ☐ Repair System Type: I, II, (III) IV, V, VI

System Description: Gravity Infiltrator

Repair System Description: Same

Maintenance Agreement Required: ☐ Yes ☐ No

☒ House/Mod. Home No. Bedrooms 3

☐ Mobile Home No. Bathrooms 2

☐ Business No. Employees

☐ Other


☐ Slab ☒ Crawl Space ☐ Basement w/plumbing ☐ Basement wo/plumbing

Water Supply: ☒ Individual ☐ Community ☐ Public


Comments: ~~X~~ 25% reduction for Infiltrator use. Sand required to backfill around louvers.

Comments:

INITIAL SITE SKETCH

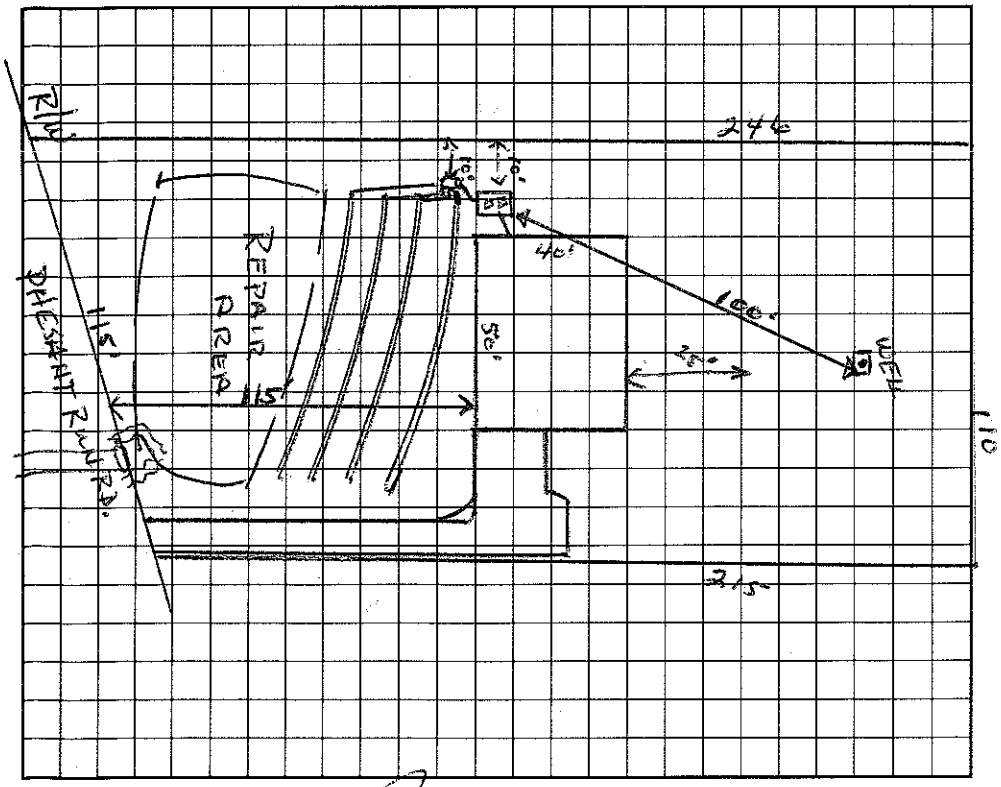

AS BUILT SKETCH

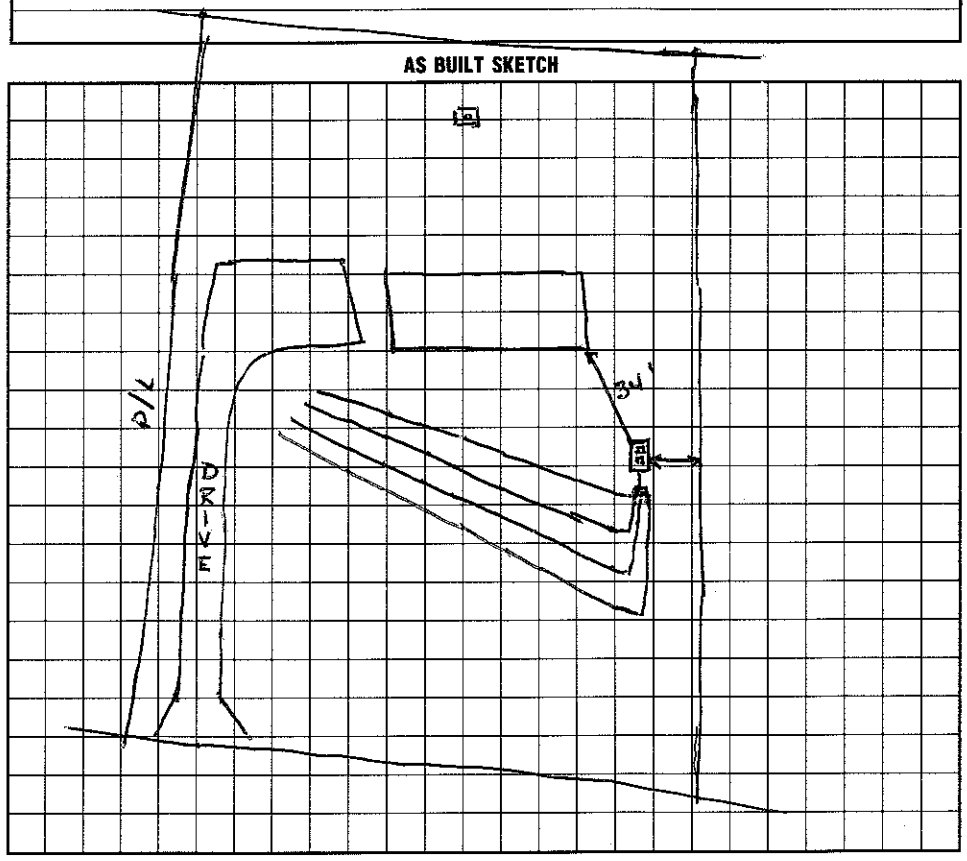

I understand that this permit can be suspended or revoked if any false information is supplied toward securing the permit/any unauthorized changes are made to the site/any unauthorized changes are made in the installation of the system.

Signed: Tony C. Parker, REHS (Agent)

Improvement Permit by: Wesley Sparks R.S. date 12/20/95

~~Authorization to Construct~~ Existing System Inspection by: Wesley Sparks R.S. date 12/20/95

Installed by: G+M Enterprises

Certificate of Completion by: date

Operation Permit by: Wesley Sparks R.S. date 3/31/99

HEALTH DEPT. COPY: WHITE INSPECTION COPY (FINAL): GREEN OWNER COPY (FINAL): YELLOW INSPECTION COPY (INITIAL): PINK OWNER COPY (INITIAL): GOLD