IREDELL COUNTY HEALTH DEPARTMENT

STATESVILLE 704-878-5305 MOORESVILLE 704-664-5281

IMPROVEMENT PERMIT / CERTIFICATE OF COMPLETION / OPERATION PERMIT / EXISTING SYSTEM INSPECTION

PROPERTY DESCRIPTION NO. 20264 $9283 DATE 4/8/95 TAX MAP NO. 4G 4 A 50 Watershed: ☐ Yes ☒ No

OWNER OR CONTRACTOR Mel Graham (Pheasant Run) PHONE: Business 552-5338 ~~Home~~ 4750-~~89~~-4155

ADDRESS 7701 Park Rd. Charlotte, NC. 28210

LOCATION Weathers Cek TL Pheasant Run Rd. to cul de sac through R/W to rear lot.

SUBDIVISION Pheasant Run BLOCK / SECTION III LOT 50 LOT AREA _____ SITE CLASS. PS DESIGN FLOW 360 L.T.A.R. .35

Septic Tank: 1000 Gallons; STB 794 Date 2/16/00

Pump Tank: _____ Gallons; PT _____ Date _____

Pump Make: _____ Model _____ Serial No. _____

Nitrification Field: No Fields 1 Square Feet 1028 Linear Feet 342

No Lines 3 Trench Width 36" Max Trench Bottom Depth 36" Gravel Depth 12"

☒ New System ☐ Repair System Type: I (II) III, IV, V, VI

System Description: CONV - DIST BOX

Repair System Description: SAME

Maintenance Agreement Required: ☐ Yes ☒ No

☒ House/Mod. Home ☐ Mobile Home ☐ Business ☐ Other

No. Bedrooms 3 No. Bathrooms 2 No. Employees _____


☐ Slab ☒ Crawl Space ☐ Basement w/plumbing ☐ Basement wo/plumbing

Water Supply: ☒ Individual ☐ Community ☐ Public


Comments:

Comments: 4/20/00 Checked lines and tank

INITIAL SITE SKETCH

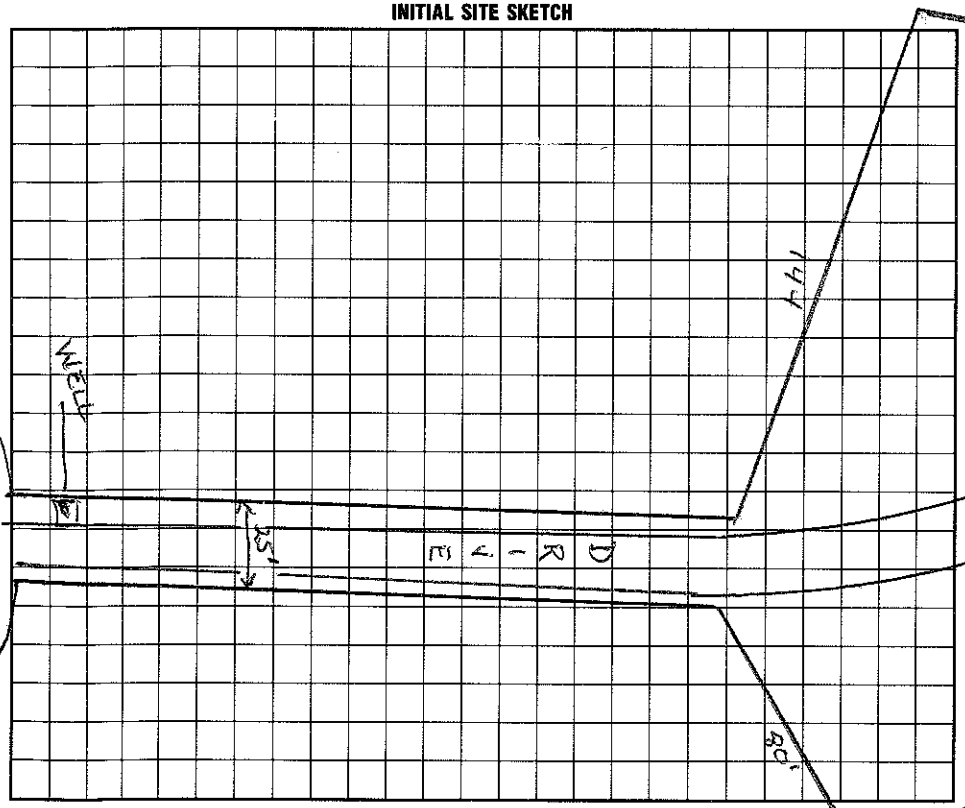

AS BUILT SKETCH

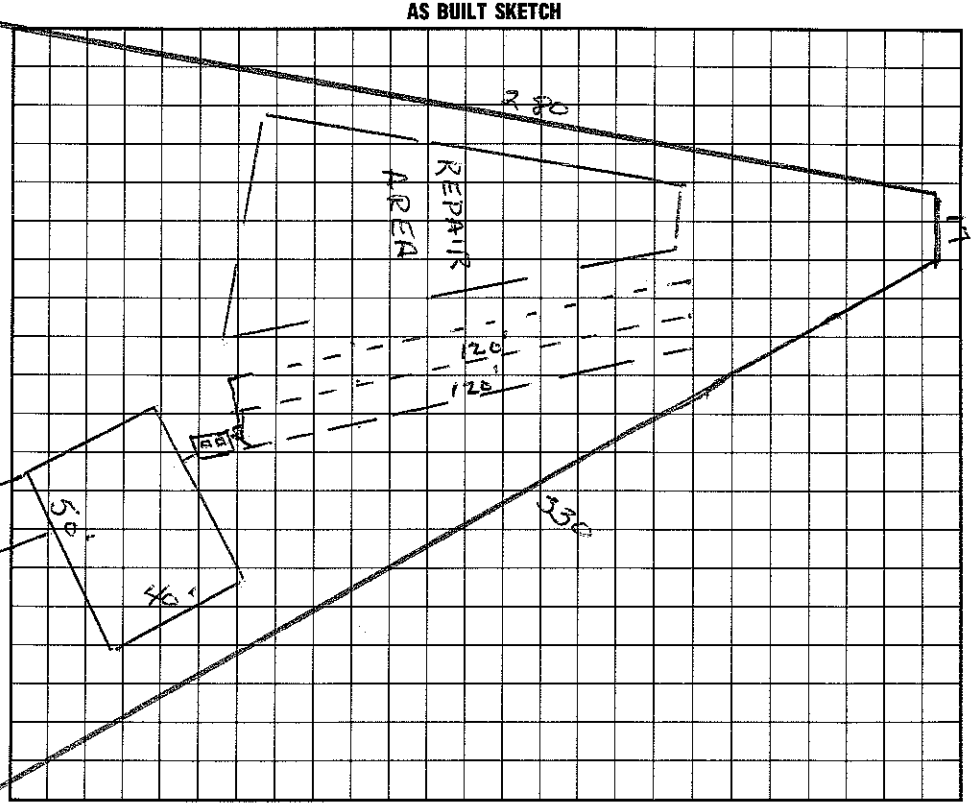

I understand that this permit can be suspended or revoked if any false information is supplied toward securing the permit/any unauthorized changes are made to the site/any unauthorized changes are made in the installation of the system. Improvement Permit is valid for 60 months from date of issuance.

Signed: Park Pennington

Improvement Permit by: Wesley Sparks R.S. date 4/8/95

Existing System Inspection by: _____ date _____

Installed by: Donald Tucker

Certificate of Completion by: Wesley Sparks R.S. date 7/11/00

Operation Permit by: _____ date _____

HEALTH DEPT. COPY: WHITE INSPECTION COPY (FINAL): GREEN OWNER COPY (FINAL): YELLOW INSPECTION COPY (INITIAL): PINK OWNER COPY (INITIAL): GOLD